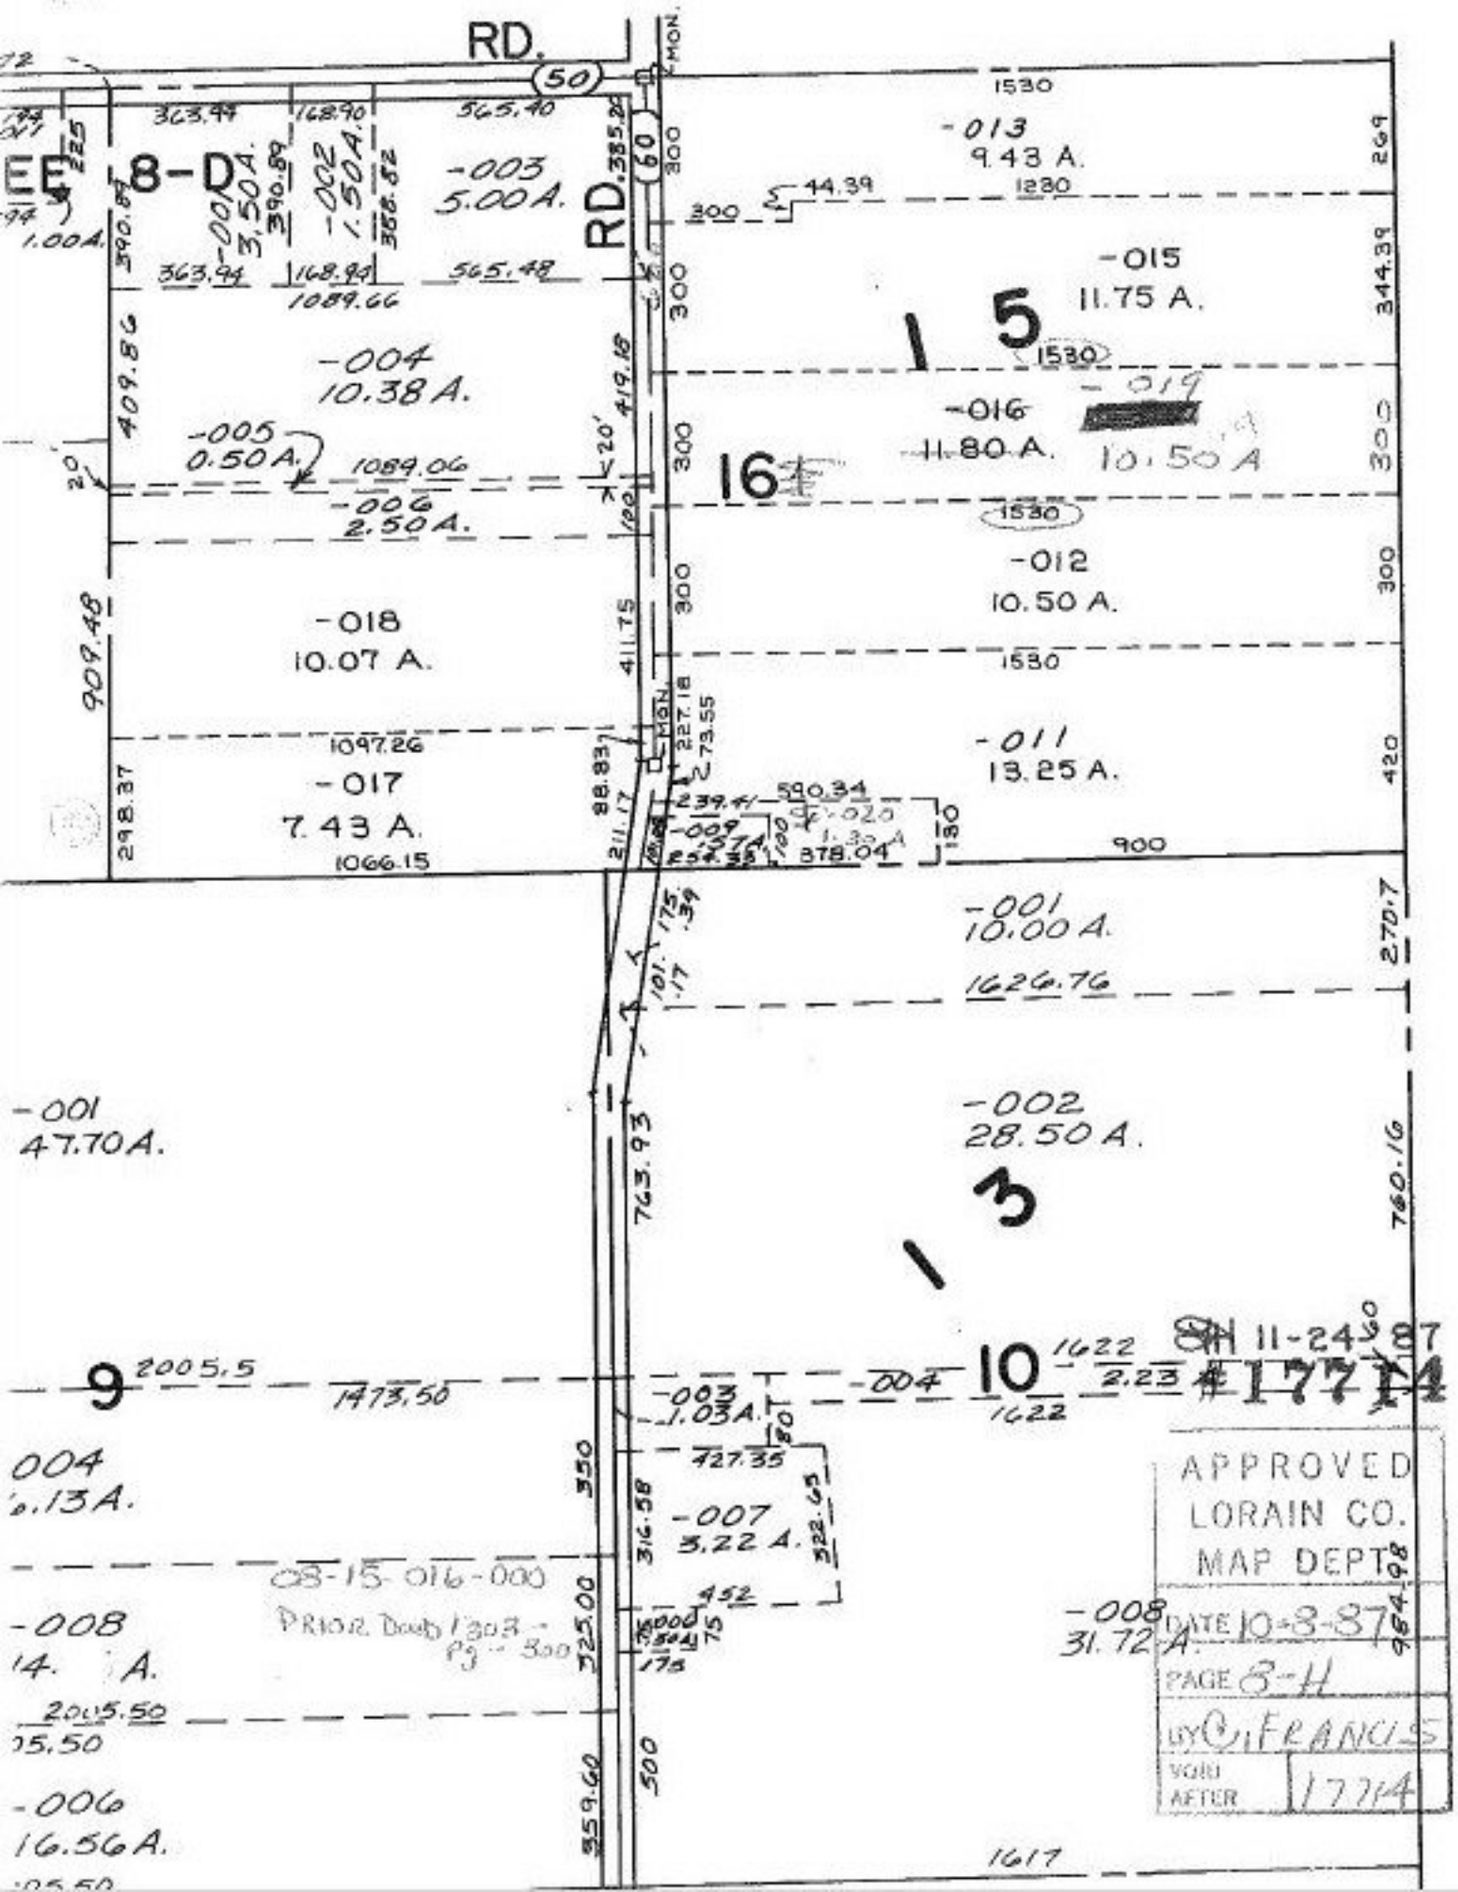
RD.
50
RD.
60
MON.
8-D
-001
3.50A.
-002
1.50A.
-003
5.00A.
-004
10.38 A.
-005
0.50A.
-006
2.50A.
-018
10.07 A.
-017
7.43 A.
-013
9.43 A.
-015
11.75 A.
15
-016
11.80 A.
-019
10.50 A
16
-012
10.50 A.
-011
13.25 A.
-009
1.37A.
-020
1.30 A.
-001
10.00 A.
-001
47.70A.
-002
28.50 A.
13
9
10
-003
1.03A.
-007
3.22 A.
-008
14. A.
-008
31.72 A.
-004
-006
16.56A.
004
.13A.
08-15-016-000
PRIOR Dwg 1303 - P3 - 300
APPROVED
LORAIN CO.
MAP DEPT.
DATE 10-8-87
PAGE 8-H
BY G.FRANCIS
VOID AFTER 1774
SH 11-24-87
#1774