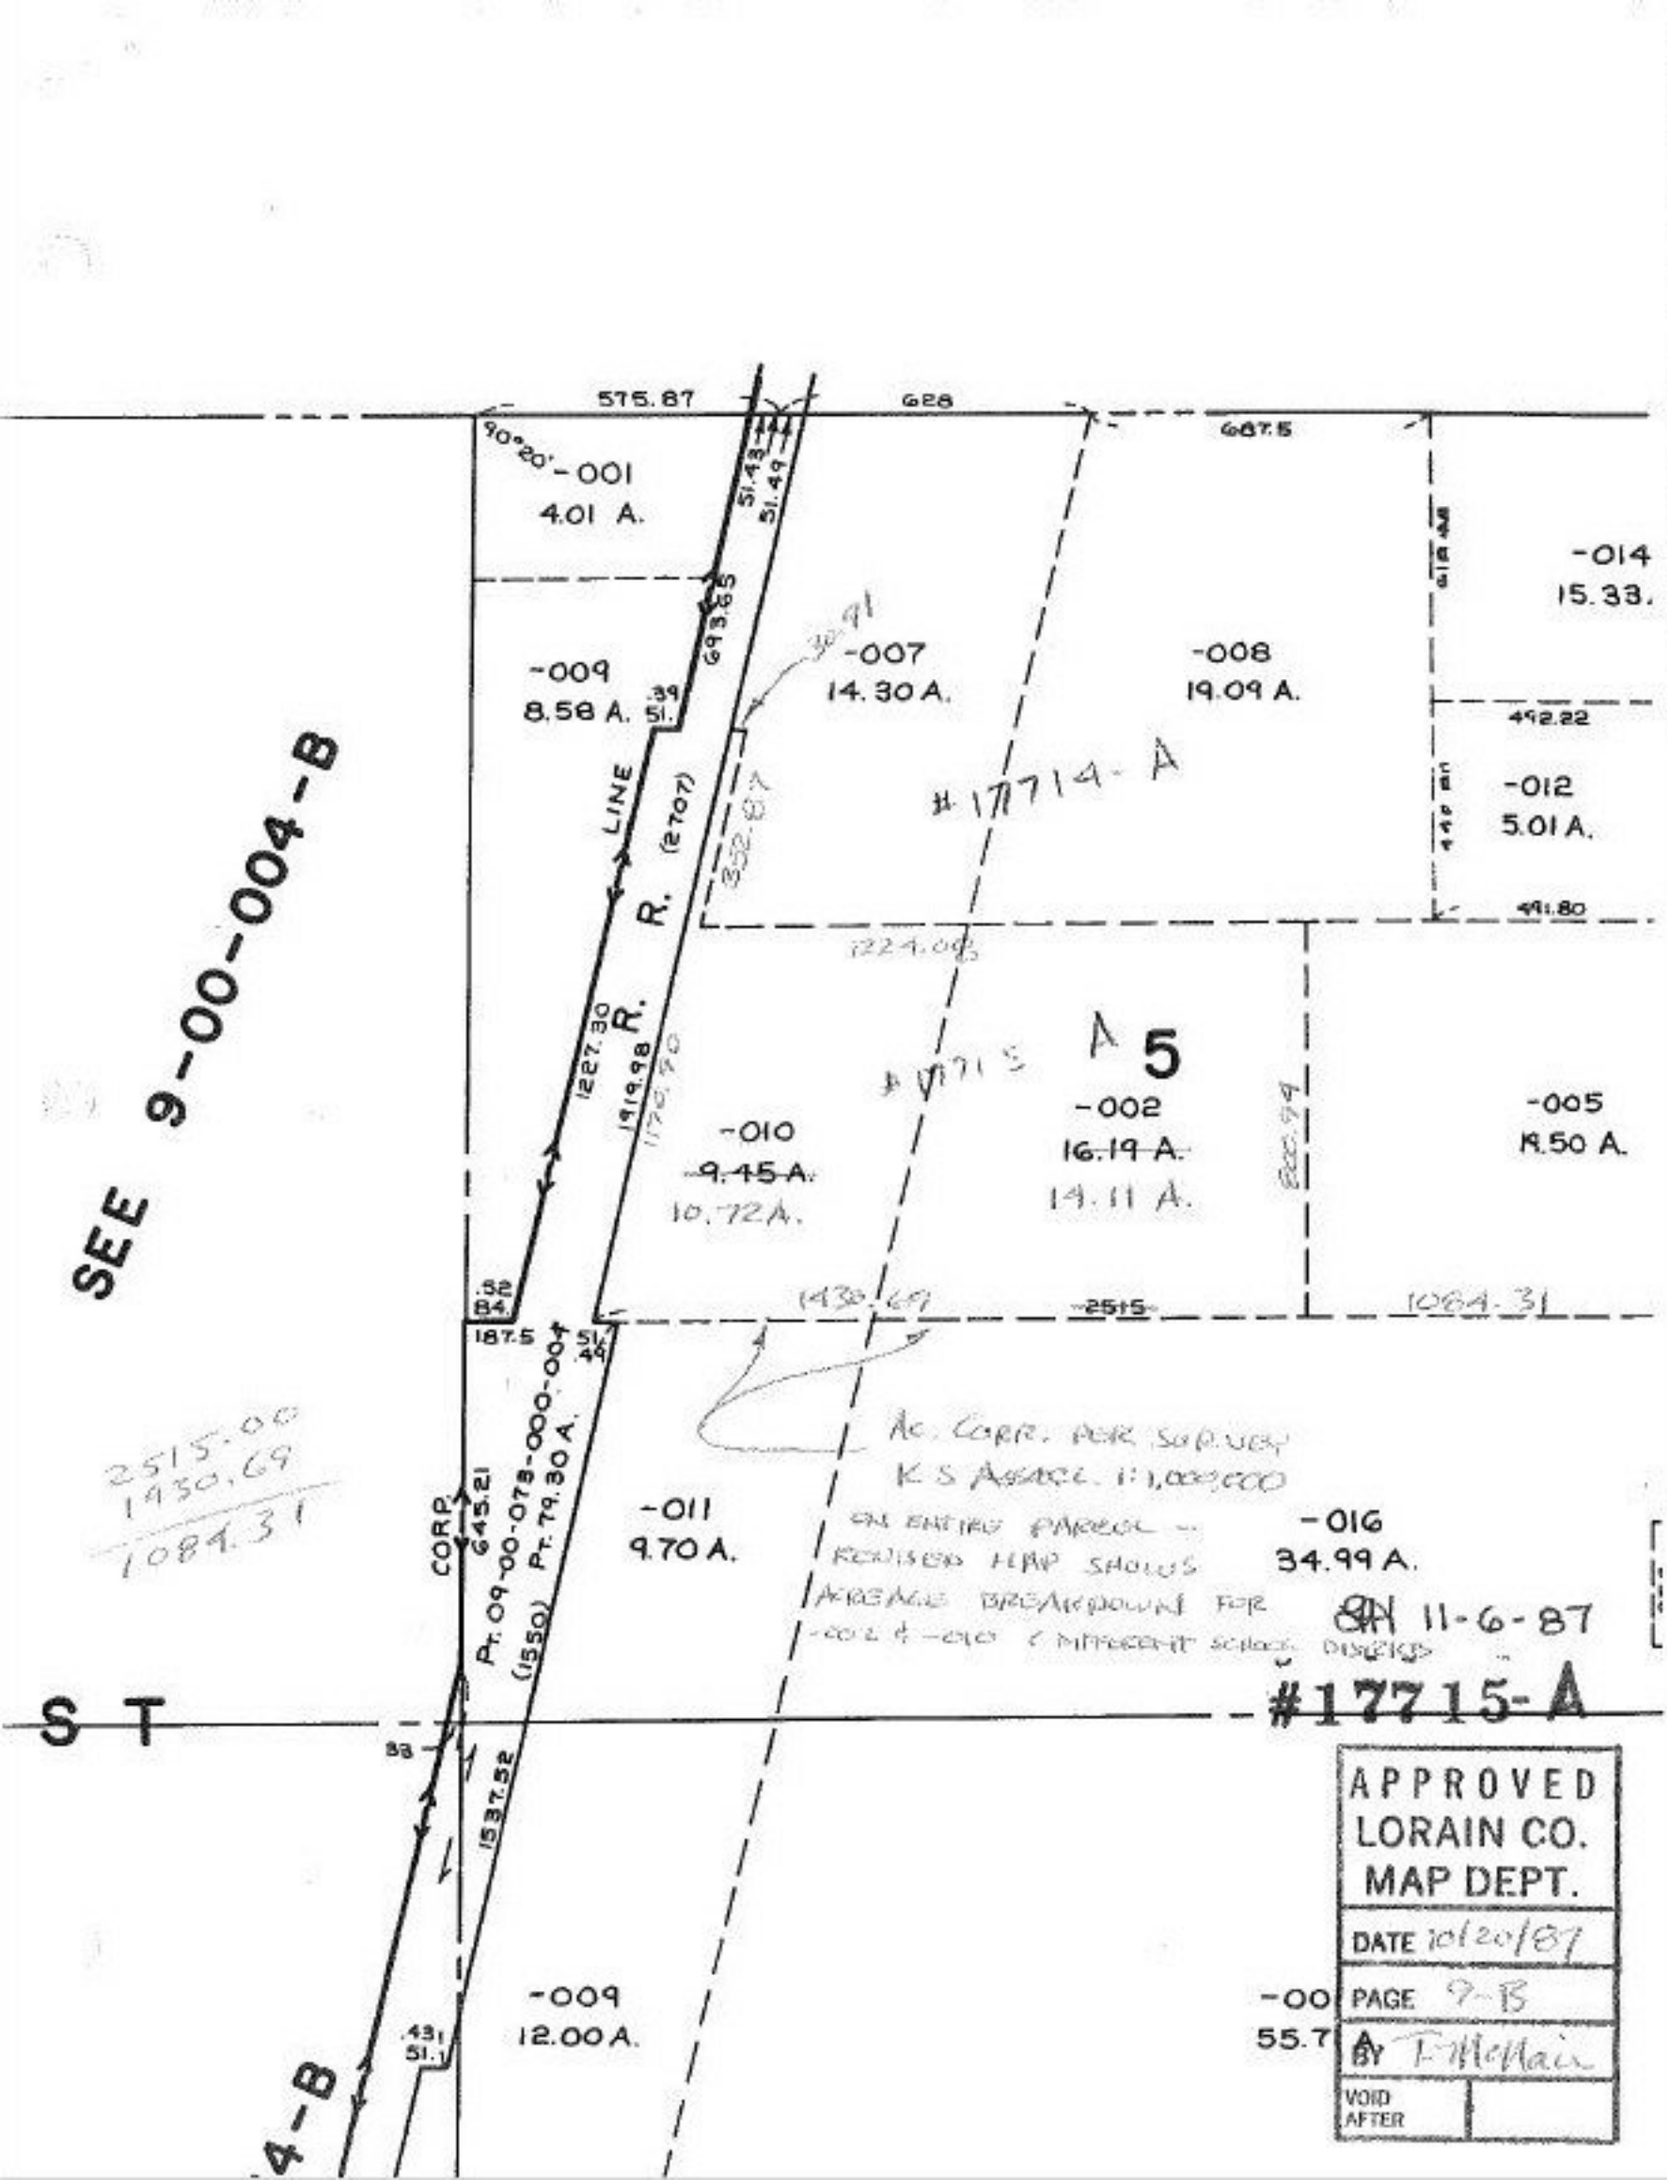
575.87
628
687.5
90°20'
-001
4.01 A.
51.43
51.49
-014
15.33.
-009
8.58 A.
693.85
-007
14.30 A.
-008
19.09 A.
492.22
-012
5.01 A.
#17714-A
LINE
R. (2707)
R.
1227.30
1919.98
1224.08
#17715-A
5
-010
9.45 A.
10.72A.
-002
16.19 A.
14.11 A.
-005
18.50 A.
1430.69
2515
1084.31
SEE 9-00-004-B
2515.00
1430.69
1084.31
187.5
CORP
645.21
Pt. 09-00-078-000-004
Pt. 79.30 A.
(1550)
-011
9.70 A.
-016
34.99 A.
AC. CORR. PER SURVEY
K.S ASSOC. 1:1,000,000
ON ENTIRE PARCEL --
REVISED HEAP SHOWS
ACREAGE BREAKDOWN FOR
-002 & -010 & DIFFERENT SCHOOL DISTRICTS
SH 11-6-87
#17715-A
S T
1537.52
-009
12.00 A.
-00
55.7
4-B
APPROVED
LORAIN CO.
MAP DEPT.
DATE 10/20/87
PAGE 9-B
BY T. McClain
VOID AFTER