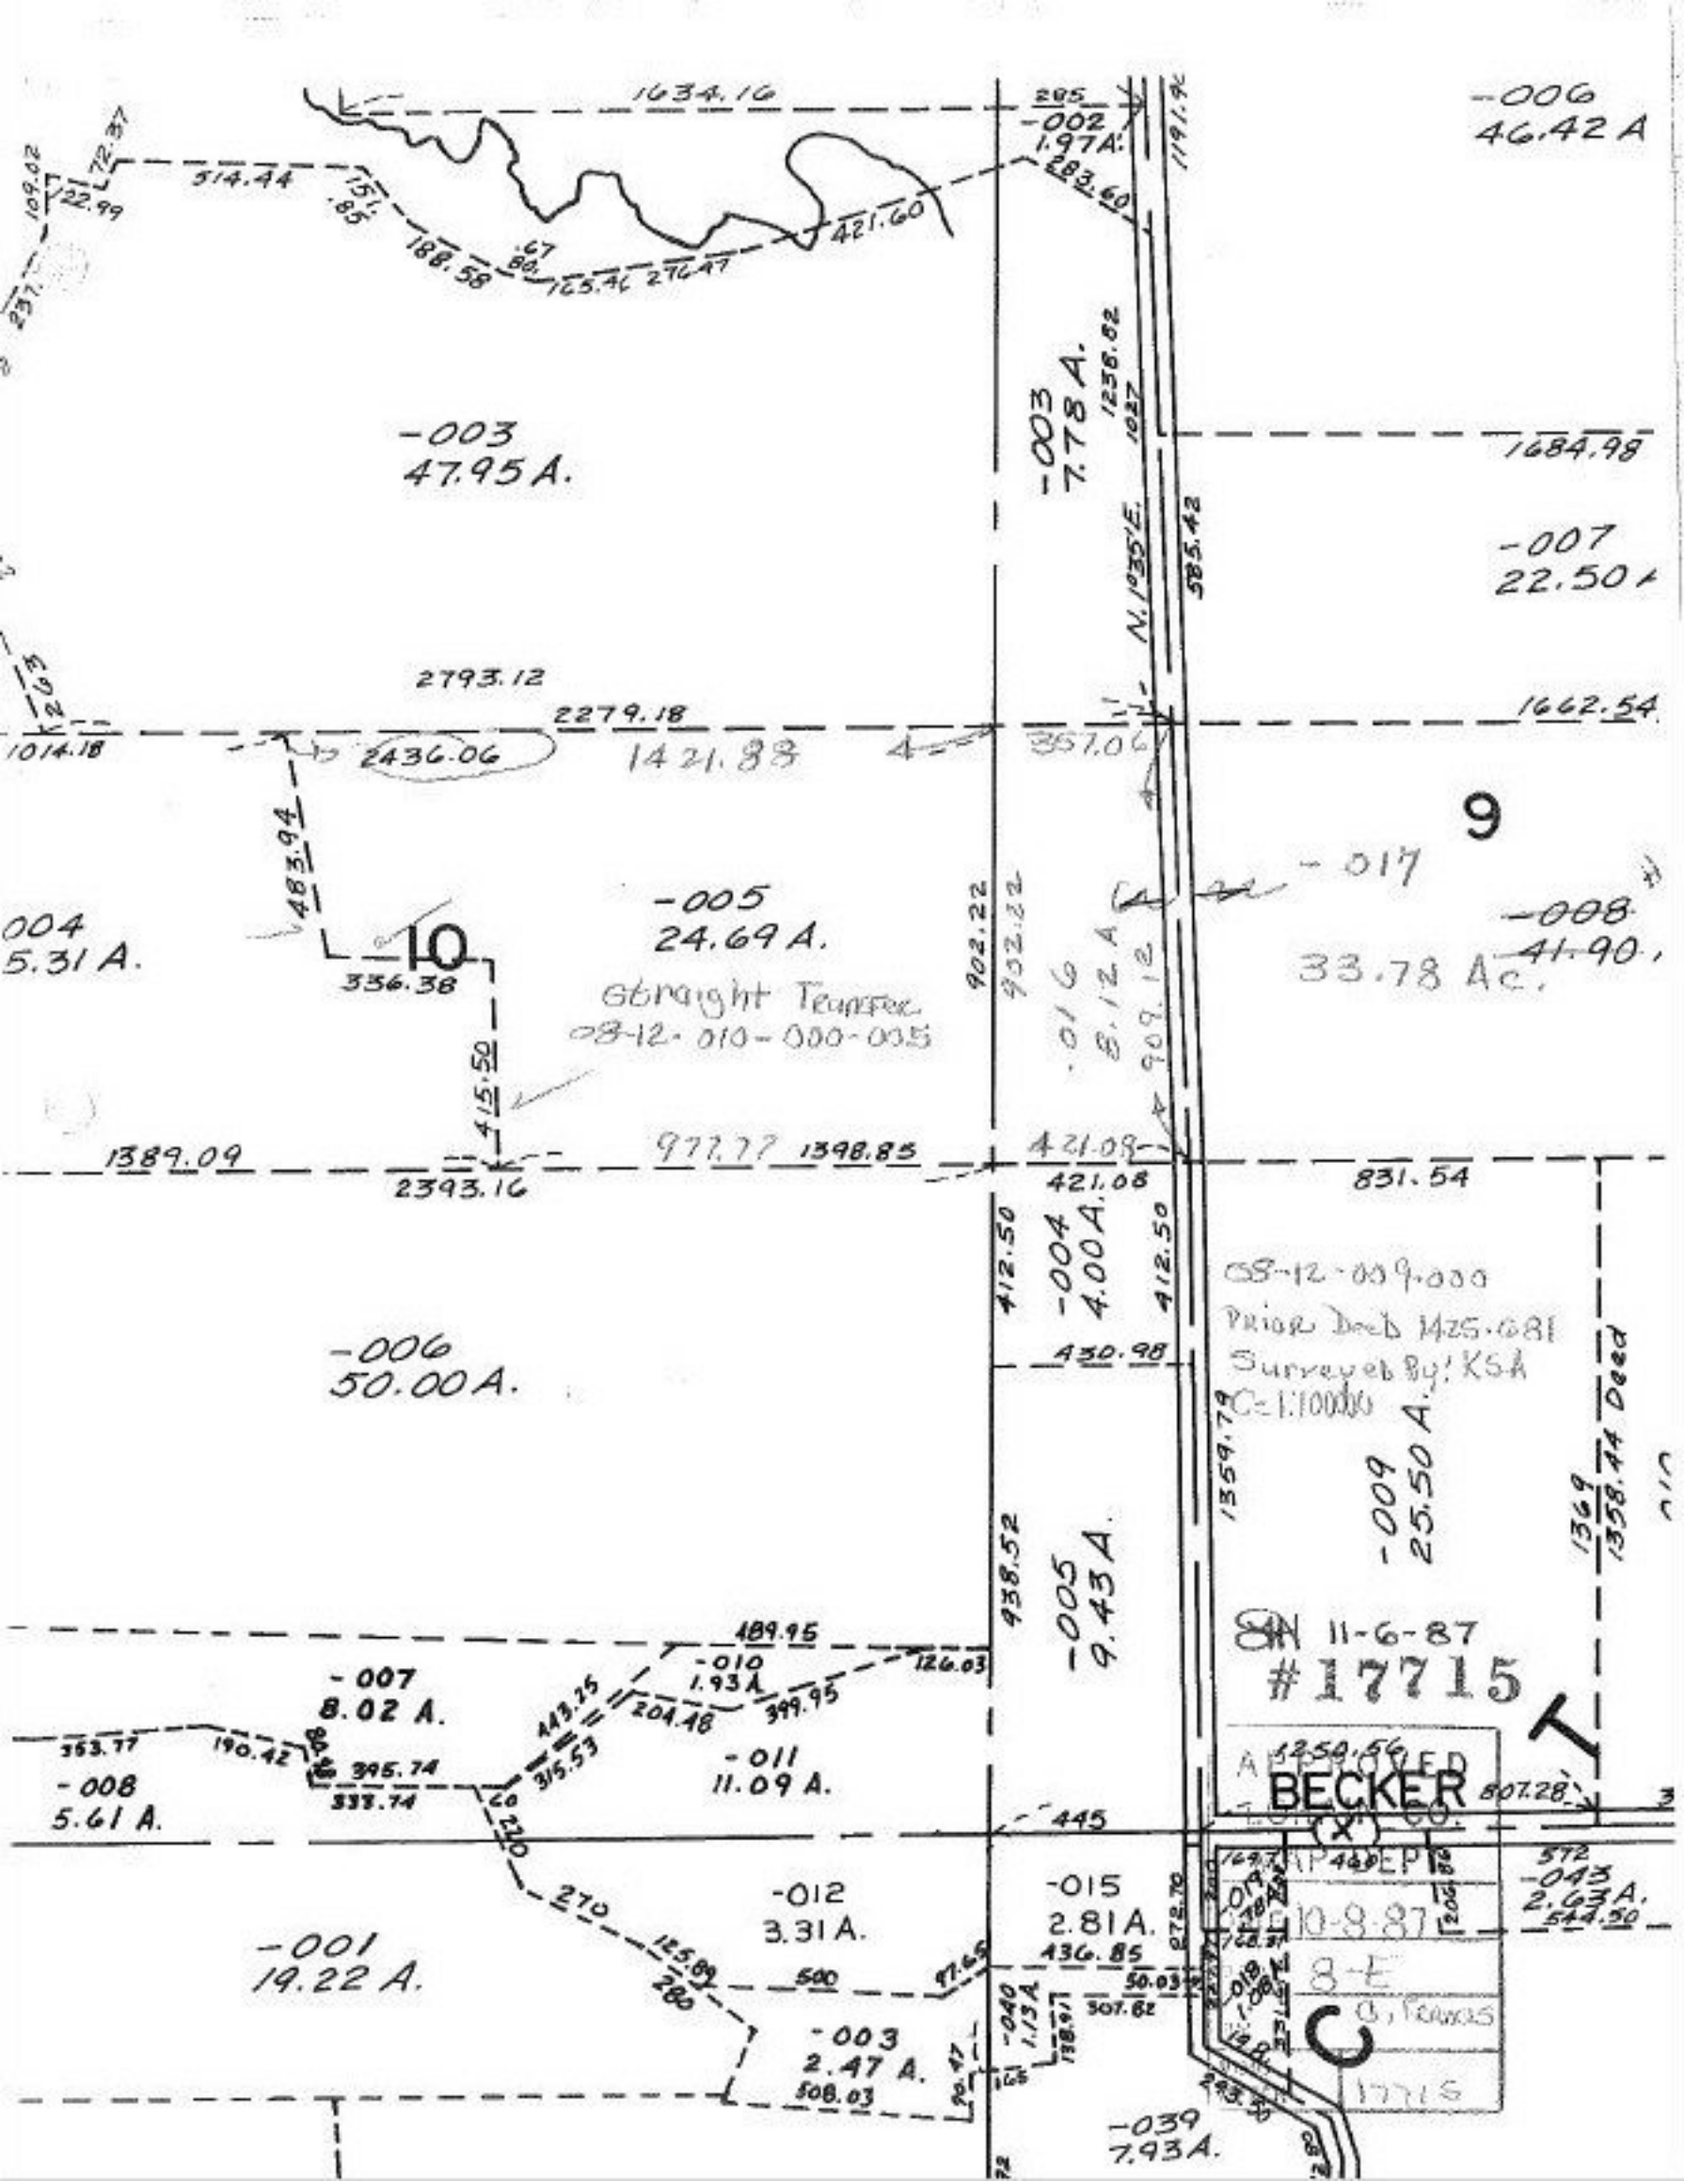
1634.16
-002
1.97A.
283.60
1191.36
-006
46.42 A
514.44
151.85
188.58
67.80
165.46
276.47
421.60
109.02
72.37
22.99
-003
47.95 A.
-003
7.78 A.
1236.62
1027
1684.98
-007
22.50 A
585.42
N. 1°35'E.
2793.12
2279.18
1662.54
1014.18
2436.06
1421.88
357.06
483.94
9
-017
-005
24.69 A.
-008
41.90
33.78 Ac.
004
5.31 A.
10
356.38
902.22
932.22
8.12 A
909.12
Straight Transfer
08-12-010-000-005
415.50
1389.09
977.77
1398.85
421.08
831.54
2393.16
412.50
-004
4.00A.
08-12-009.000
Prior Deed 1425.681
Surveyed By: KSA
C=1:10000
-006
50.00 A.
430.98
1359.79
-009
25.50 A.
1369
1358.44 Deed
938.52
-005
9.43 A.
11-6-87
#17715
189.95
126.03
-010
1.93 A.
-007
8.02 A.
443.25
204.48
399.95
353.77
190.42
395.74
333.74
315.53
-008
5.61 A.
-011
11.09 A.
270
445
BECKER
-012
3.31 A.
-015
2.81A.
436.85
-001
19.22 A.
270
125.89
280
500
307.82
-040
1.13A
-003
2.47 A.
508.03
-039
7.93A.
572
-043
2.63 A.
544.50
10-8-87
8-E
C
17715