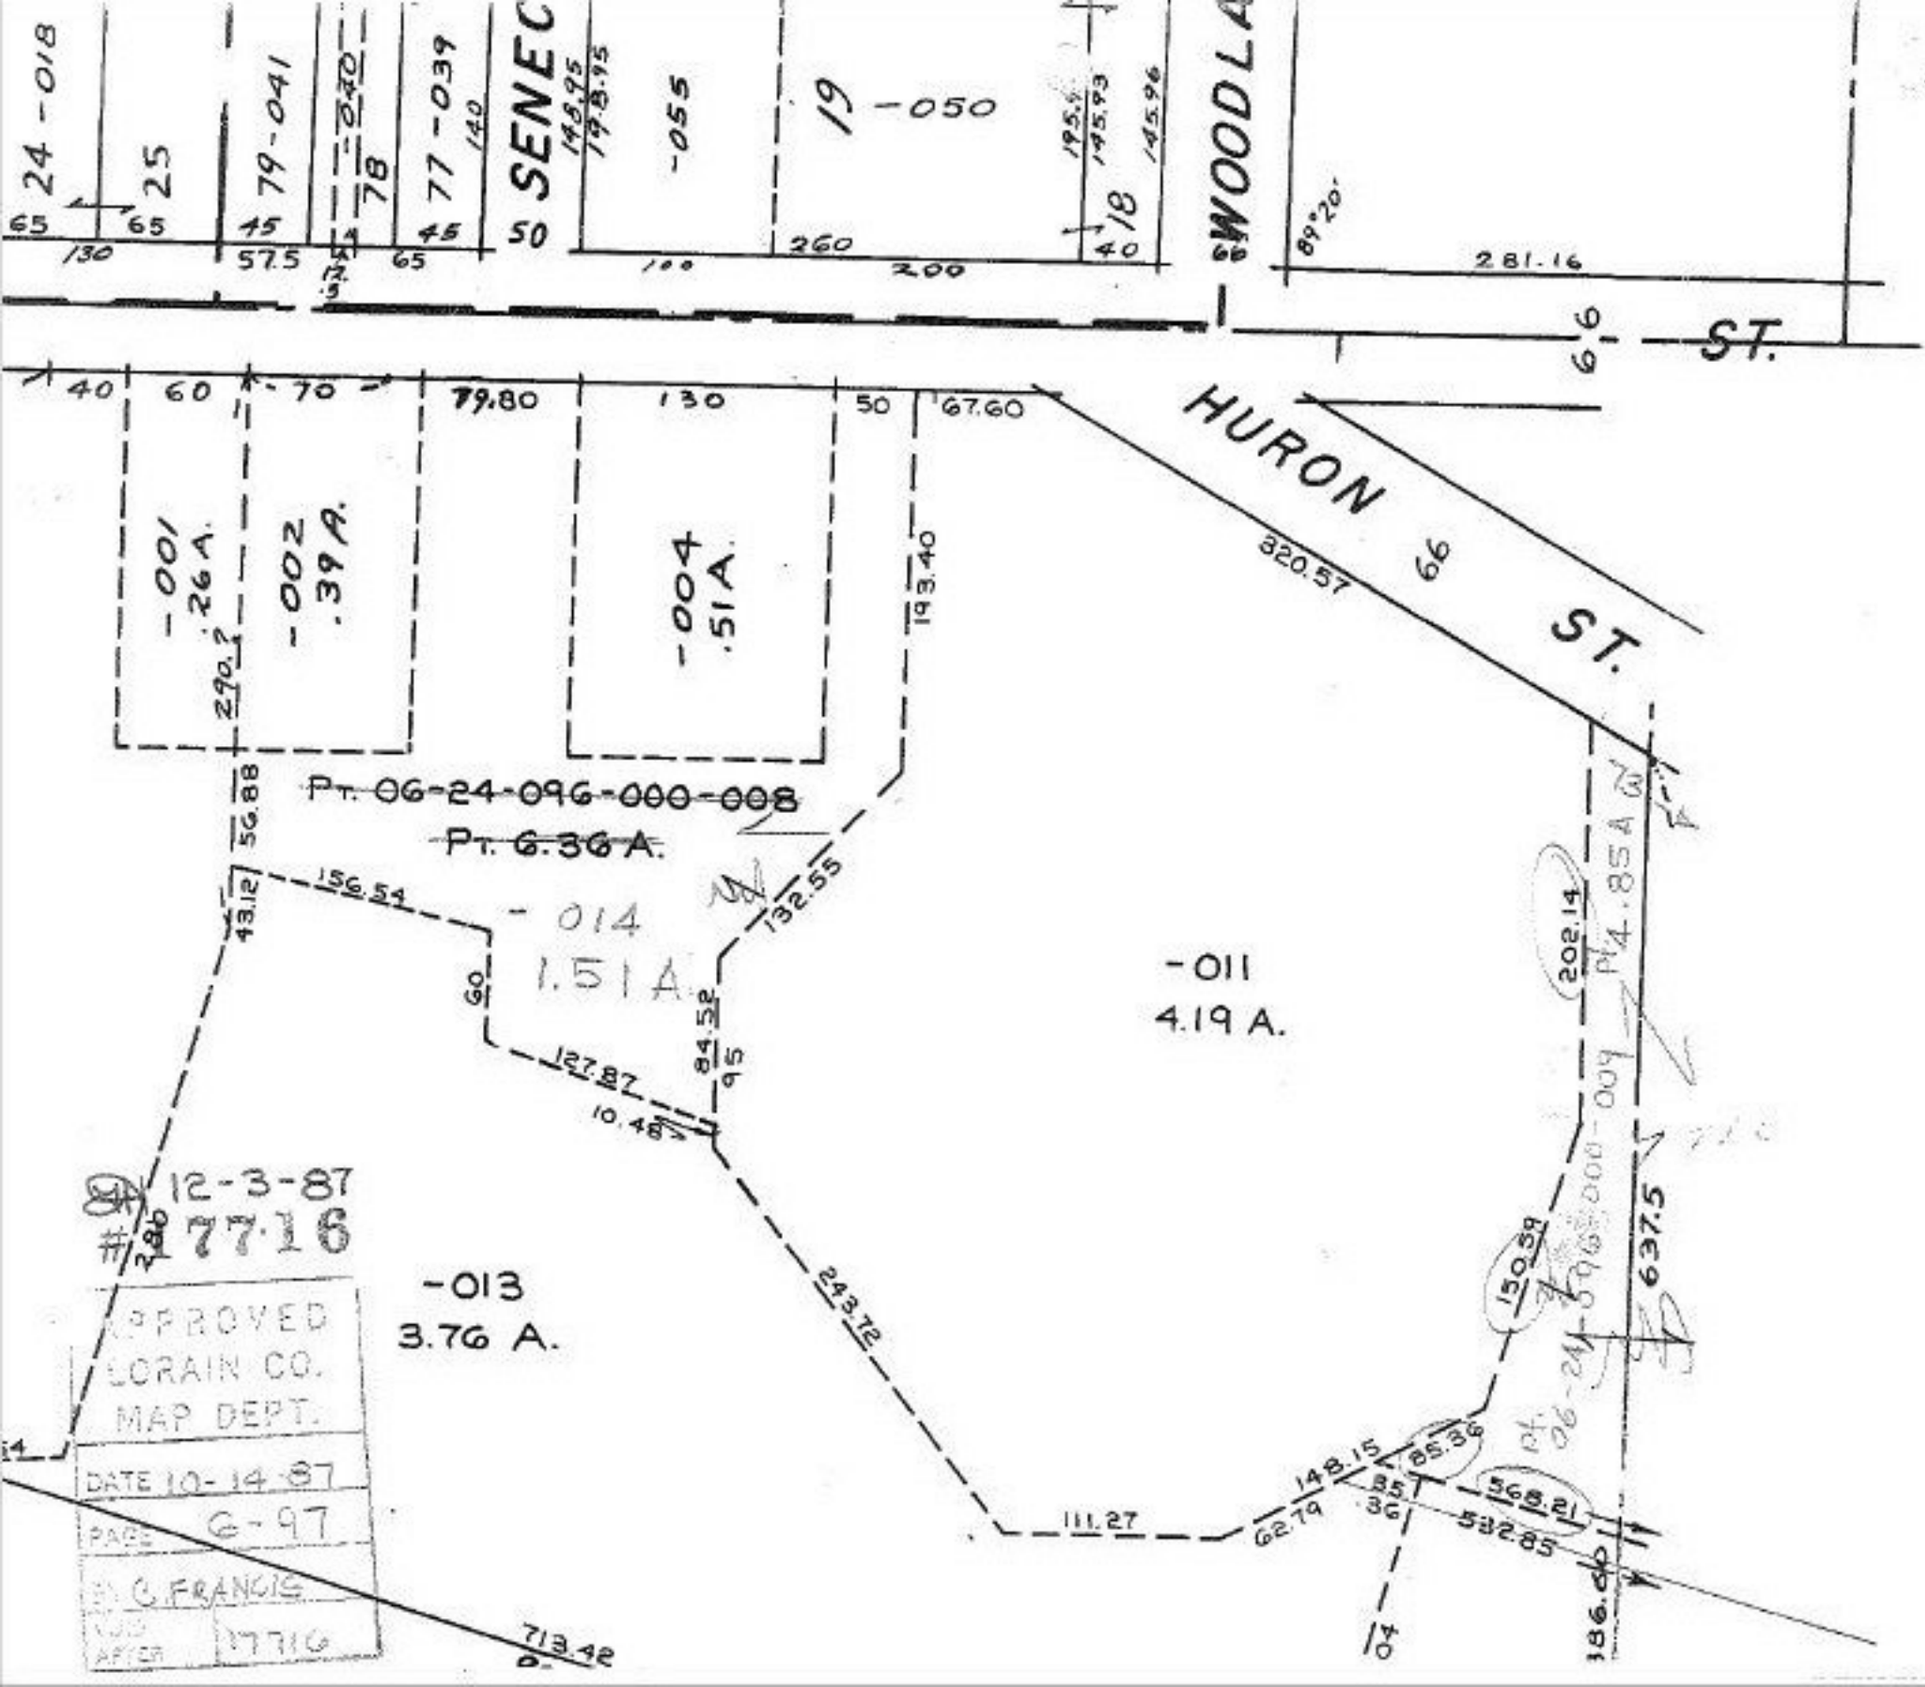
24-018
25
79-041
78
77-039
SENECA
-055
19-050
18
WOODLAND
89°20'
281.16
ST.
HURON
66
ST.
320.57
-001
.26 A.
-002
.39 A.
-004
.51 A.
Pt. 06-24-096-000-008
Pt. 6.36 A.
-014
1.51 A.
-011
4.19 A.
-013
3.76 A.
4.854 AC
06-24-096-000-009
12-3-87
#17716
APPROVED
LORAIN CO.
MAP DEPT.
DATE 10-14-87
PAGE 6-97
BY C. FRANCIS
NOW AFTER 17716
713.42
637.5
532.85
111.27
243.72
193.40
132.55
156.54
127.87
202.14
150.39
148.15
62.79
85.36
568.21
186.40