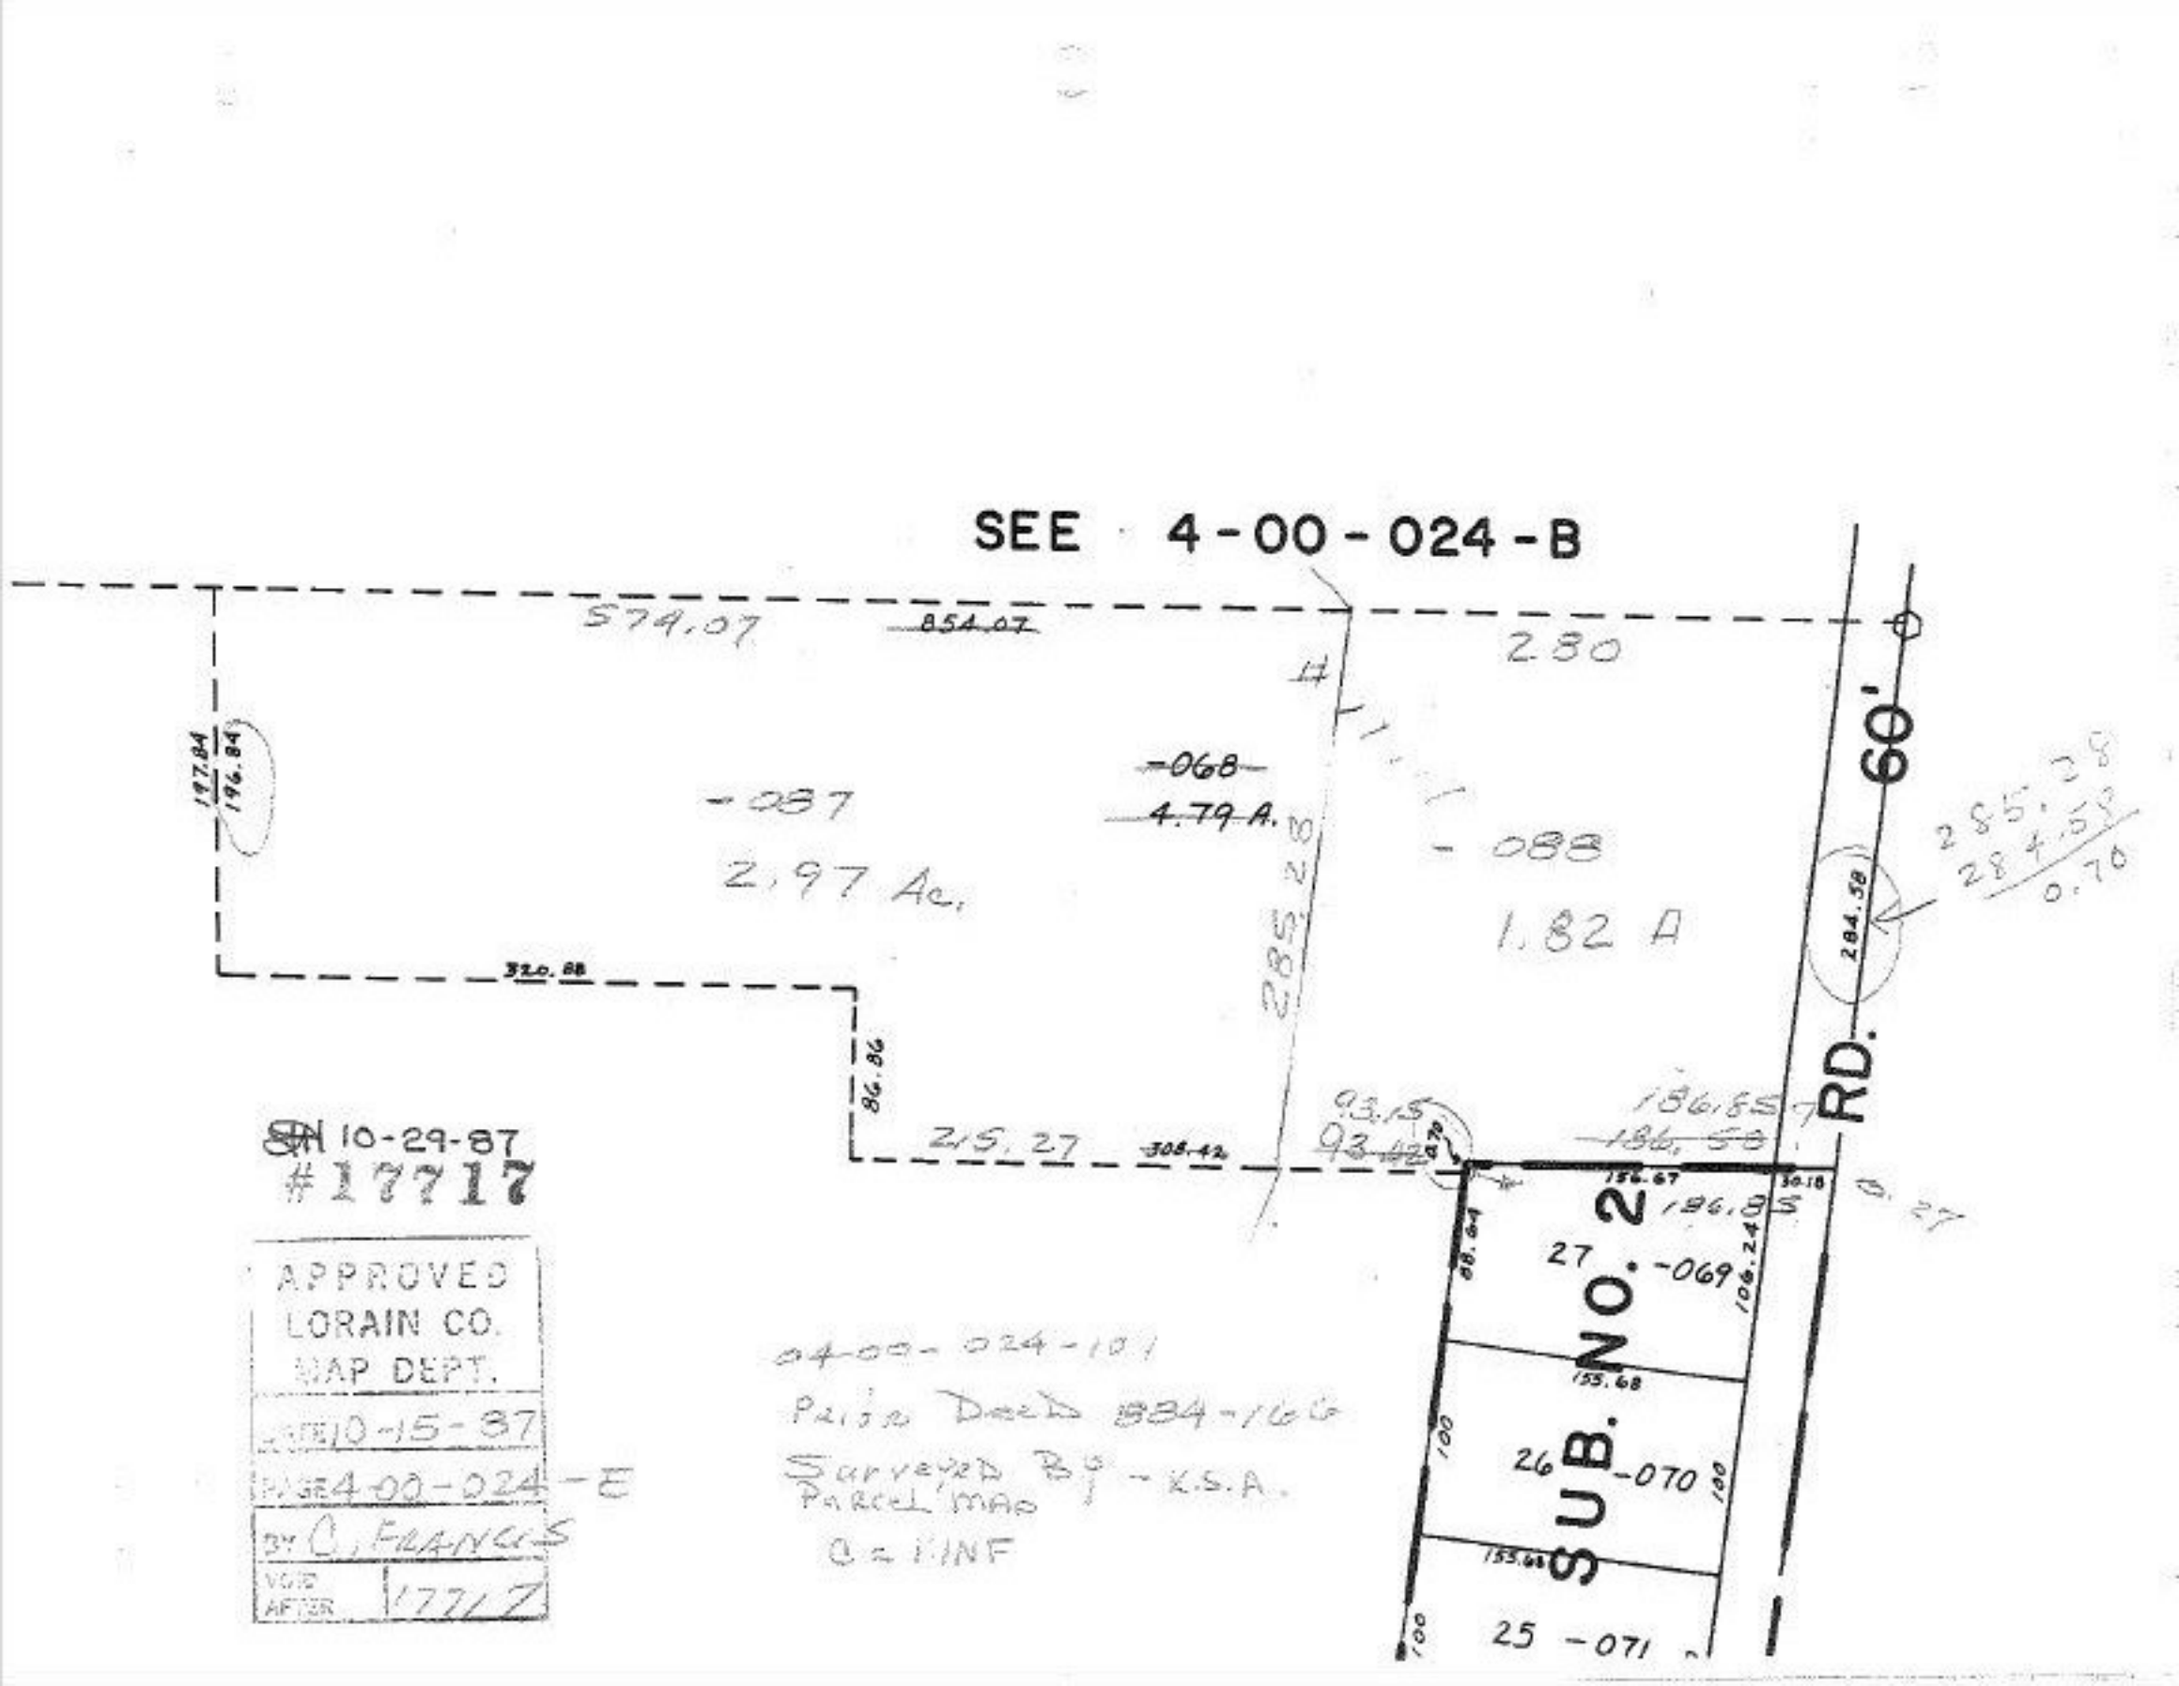
SEE 4-00-024-B
579.07
854.07
280
197.84
196.84
-087
2.97 Ac.
-068
4.79 A.
-088
1.82 A
285.28
284.58
0.70
320.88
86.86
215.27
308.42
93.15
93.42
186.65
186.50
60' RD.
SUB. NO. 2
27 -069
26 -070
25 -071
155.67
196.0
155.68
100
106.24
SN 10-29-87
#17717
APPROVED
LORAIN CO.
MAP DEPT.
DATE 10-15-87
PAGE 4-00-024-E
BY C. FRANCIS
VOID AFTER 1771Z
4-00-024-101
Prior Deed 884-166
Surveyed By - K.S.A.
Parcel MAP
0.27