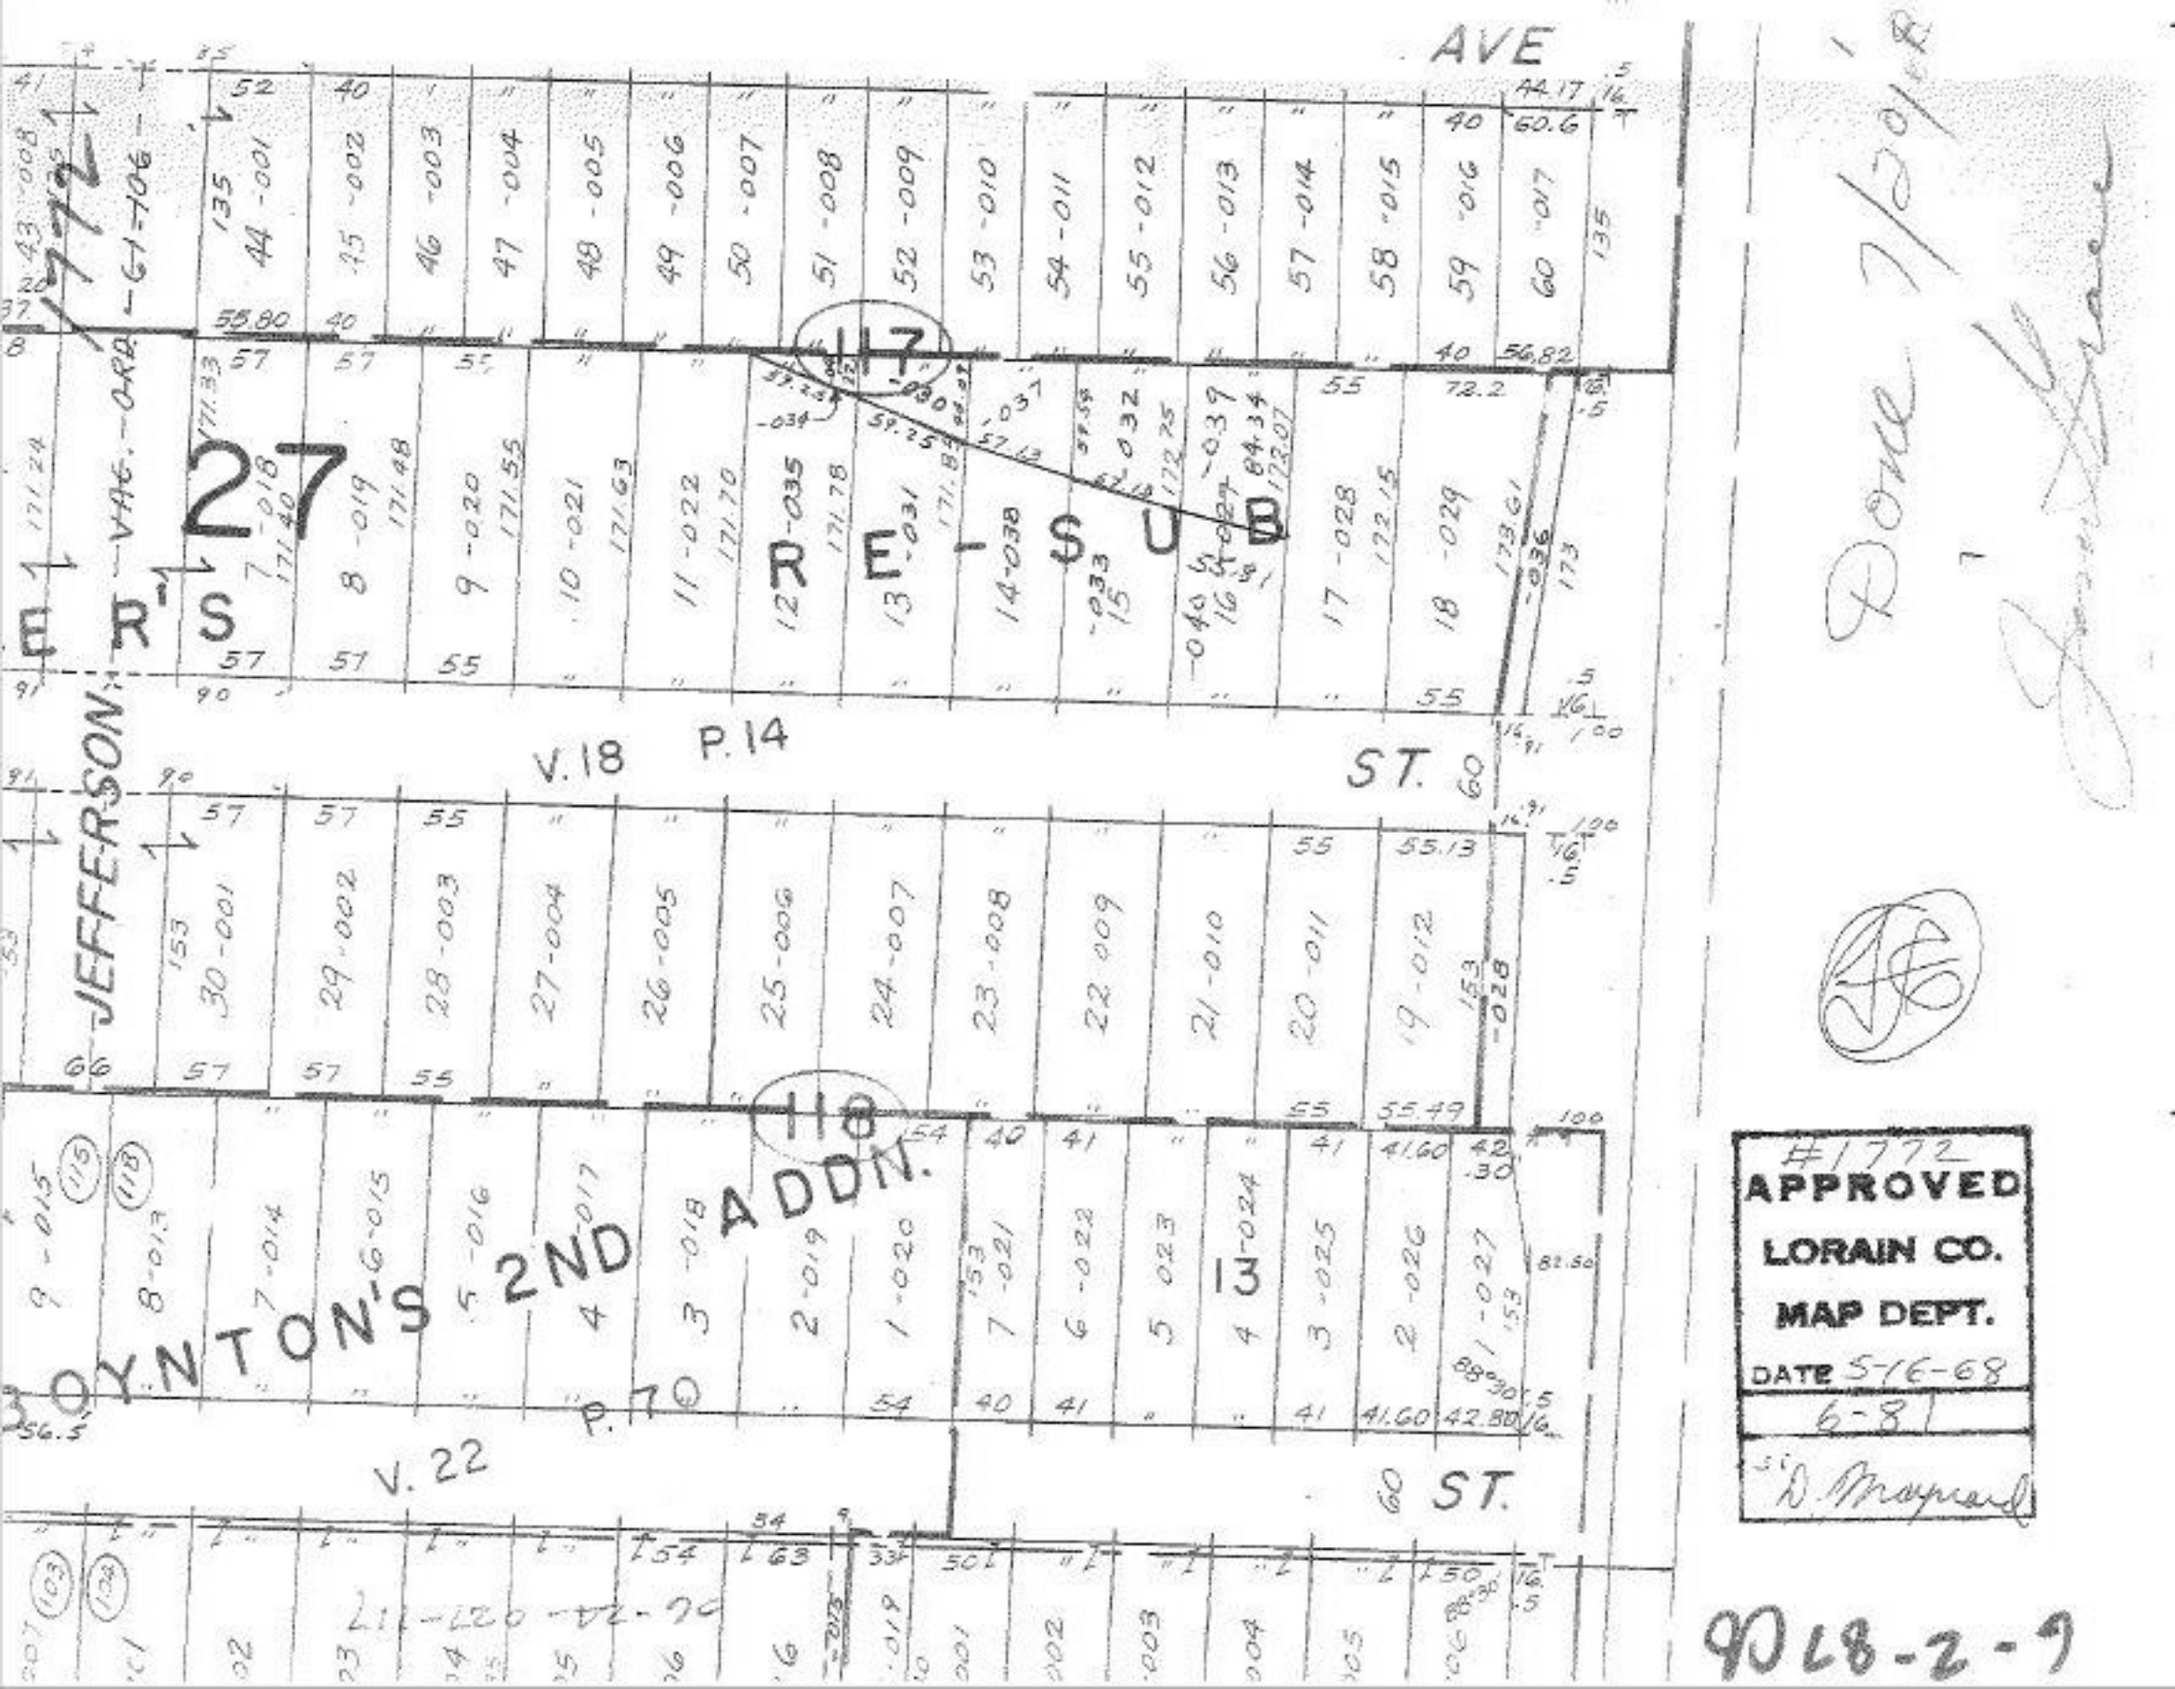
AVE
JEFFERSON
V. 18 P. 14
ST.
V. 22 P. 70
ST.
#1772
APPROVED
LORAIN CO.
MAP DEPT.
DATE 5-16-68
6-81
D. Maynard
Done 7/30/68
9048-2-9