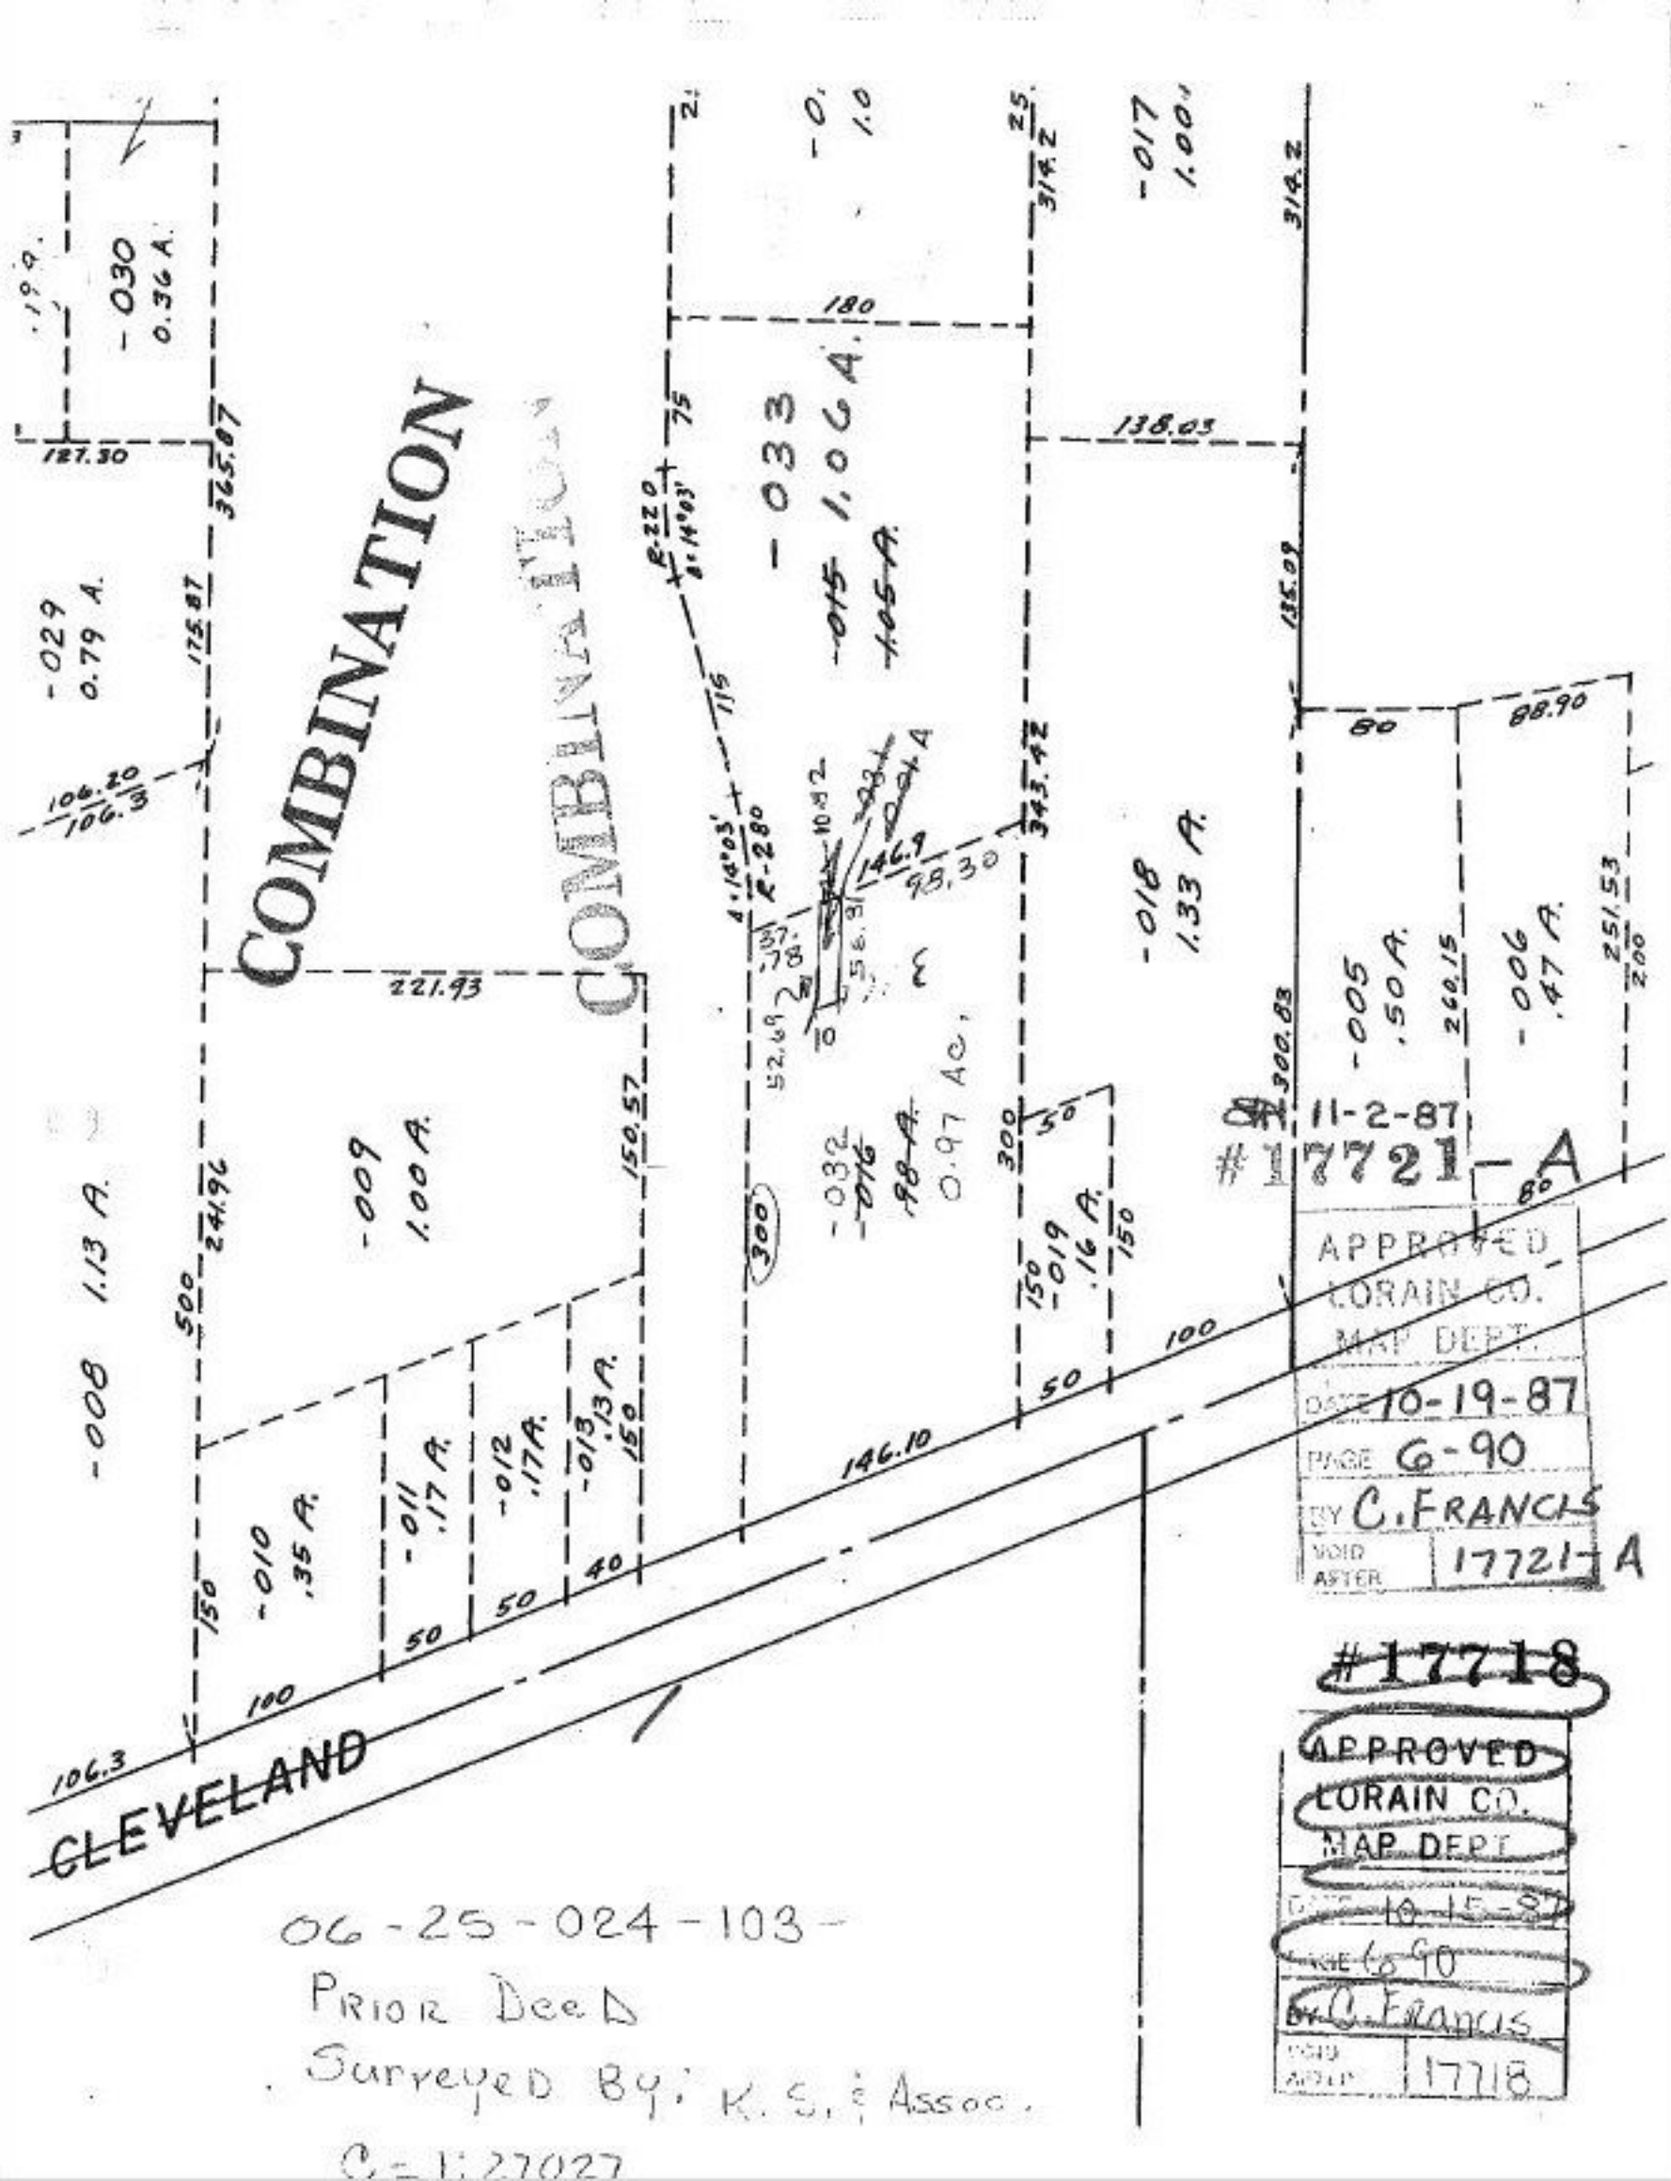

06-25-024-103-

PRIOR DEED

Surveyed By: K. S. & Assoc.

C-1:27027