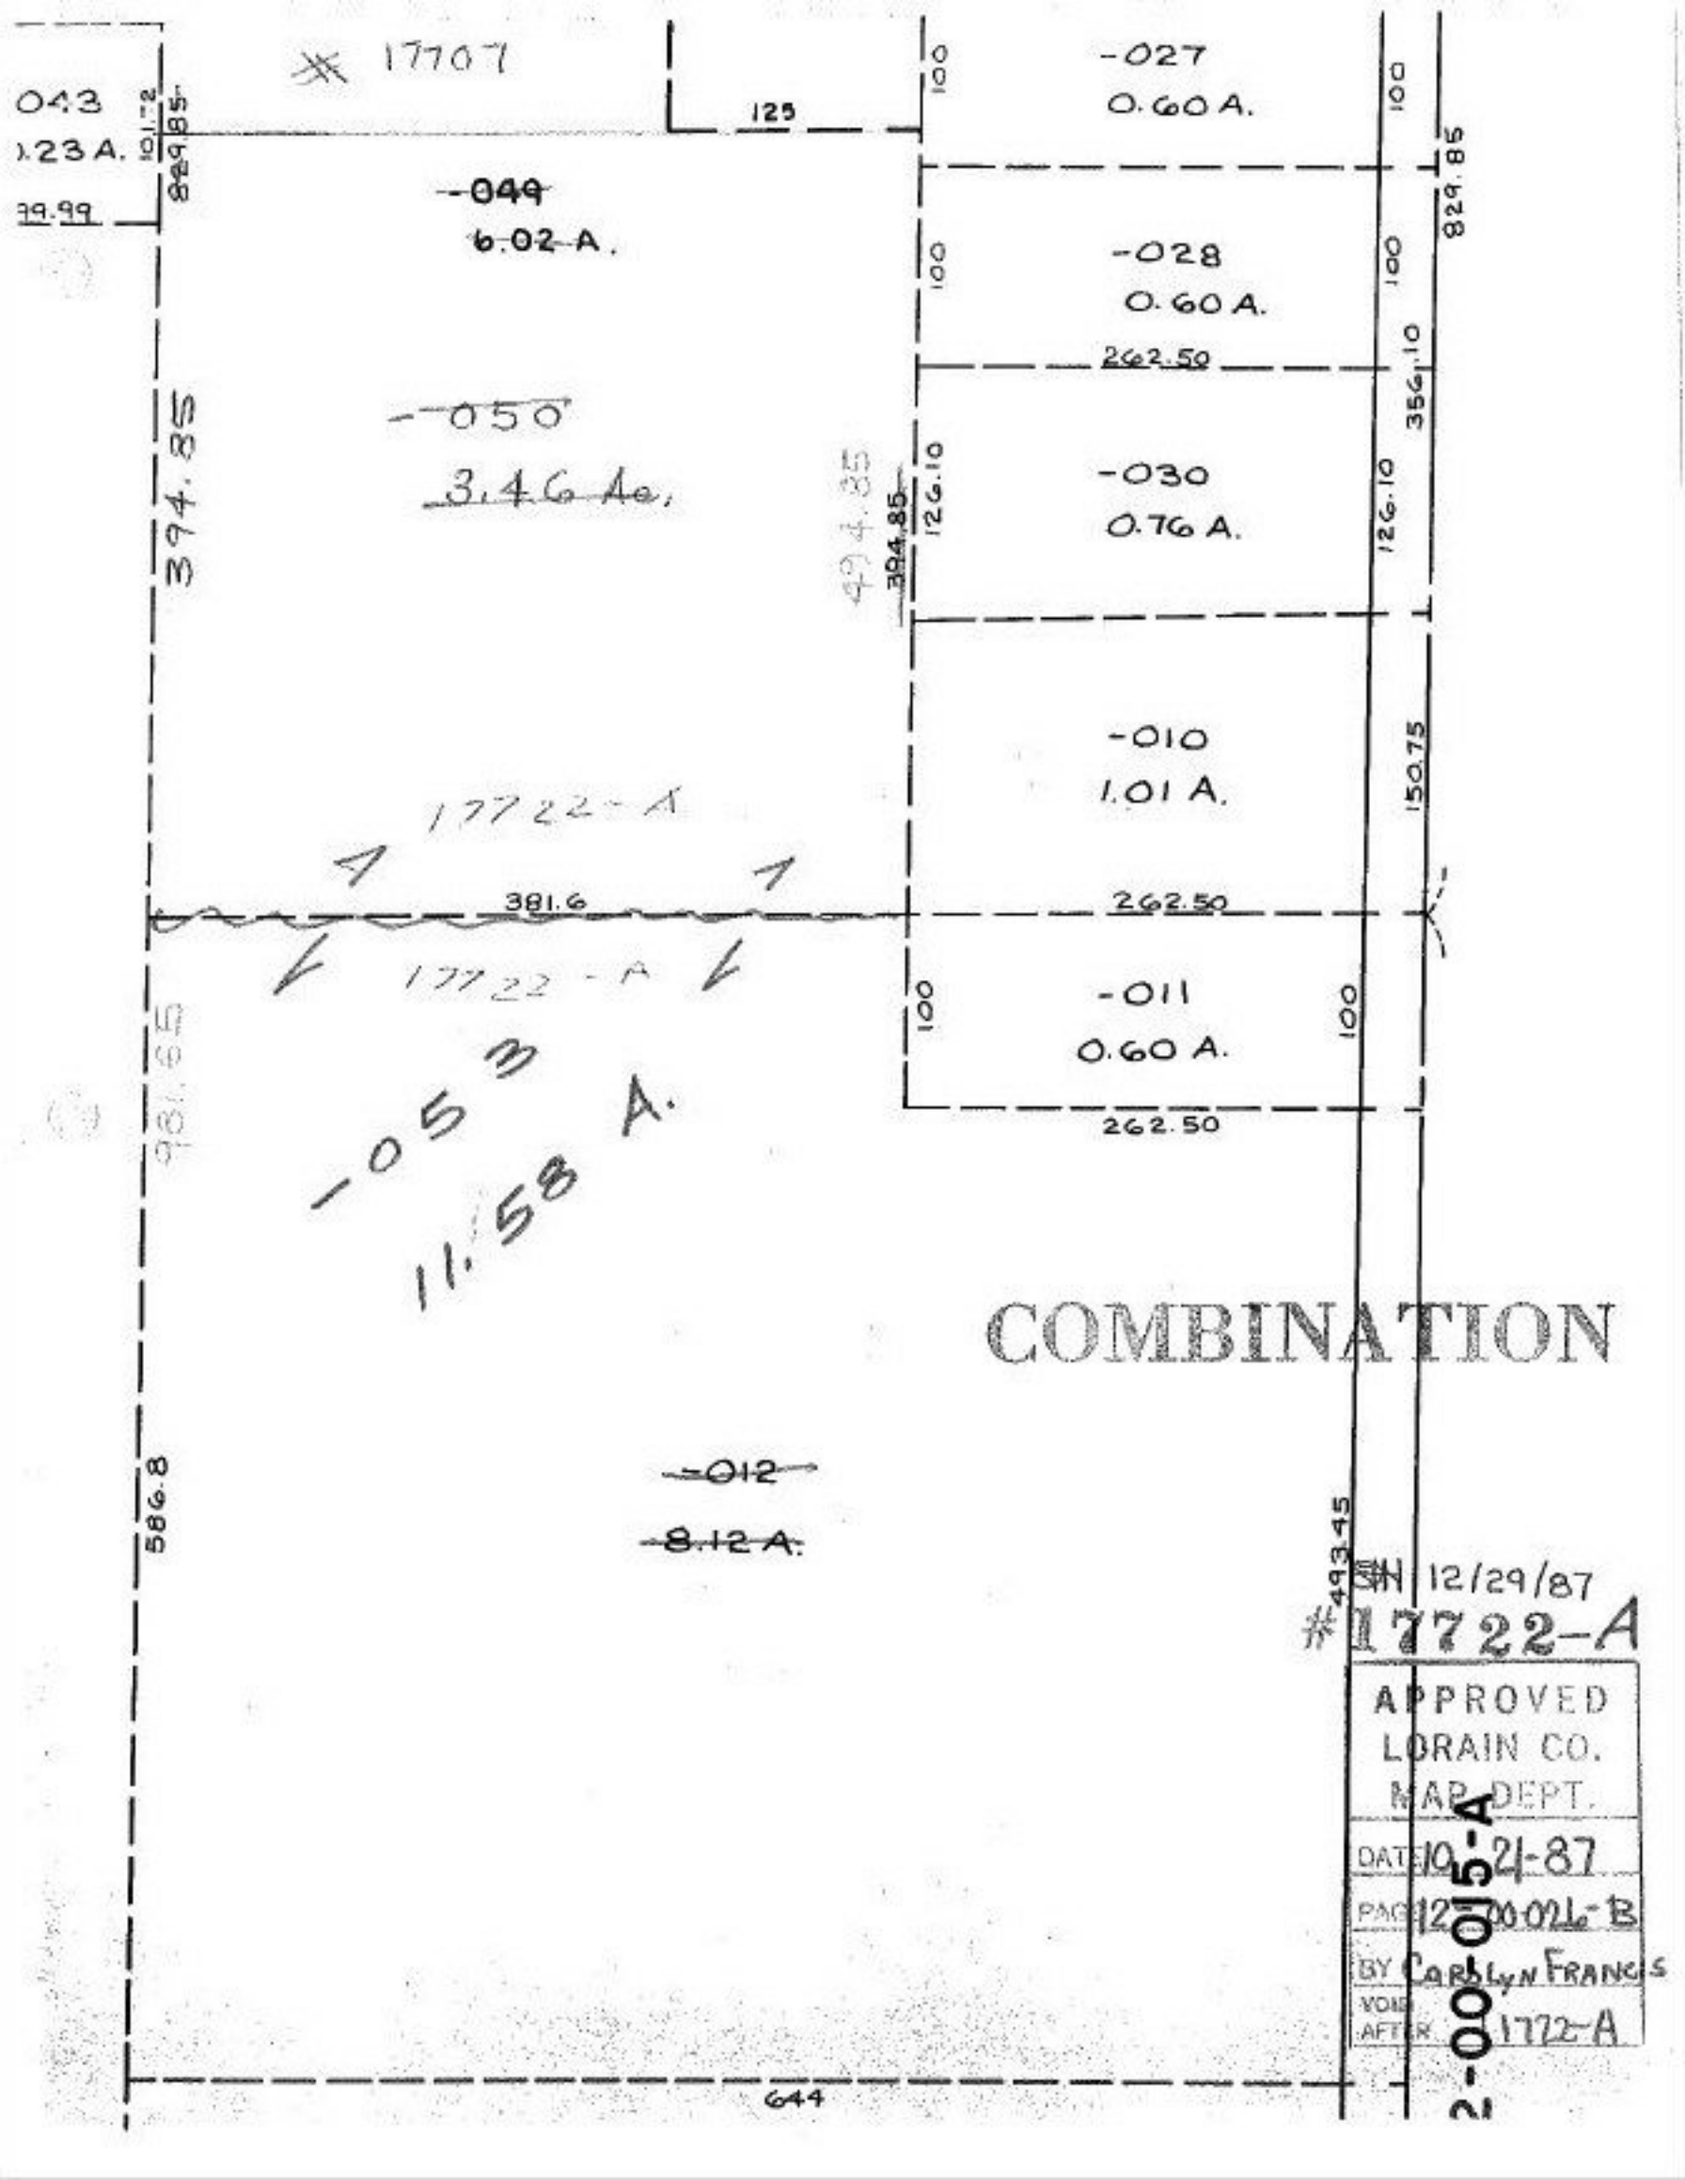

17707
043
.23 A.
99.99
101.72
829.85
125
-049
6.02 A.
-027
0.60 A.
100
-028
0.60 A.
262.50
356.10
-050
3.46 Ac.
394.85
494.85
126.10
-030
0.76 A.
-010
1.01 A.
150.75
17722-A
381.6
262.50
17722-A
-011
0.60 A.
262.50
981.65
-053
11.58 A.
COMBINATION
-012
8.12 A.
586.8
493.45
SH 12/29/87
#17722-A
APPROVED
LORAIN CO.
MAP DEPT.
DATE 10-21-87
PAGE 12-00-026-B
BY Carolyn Francis
VOID AFTER 17722-A
2-00-015-A
644