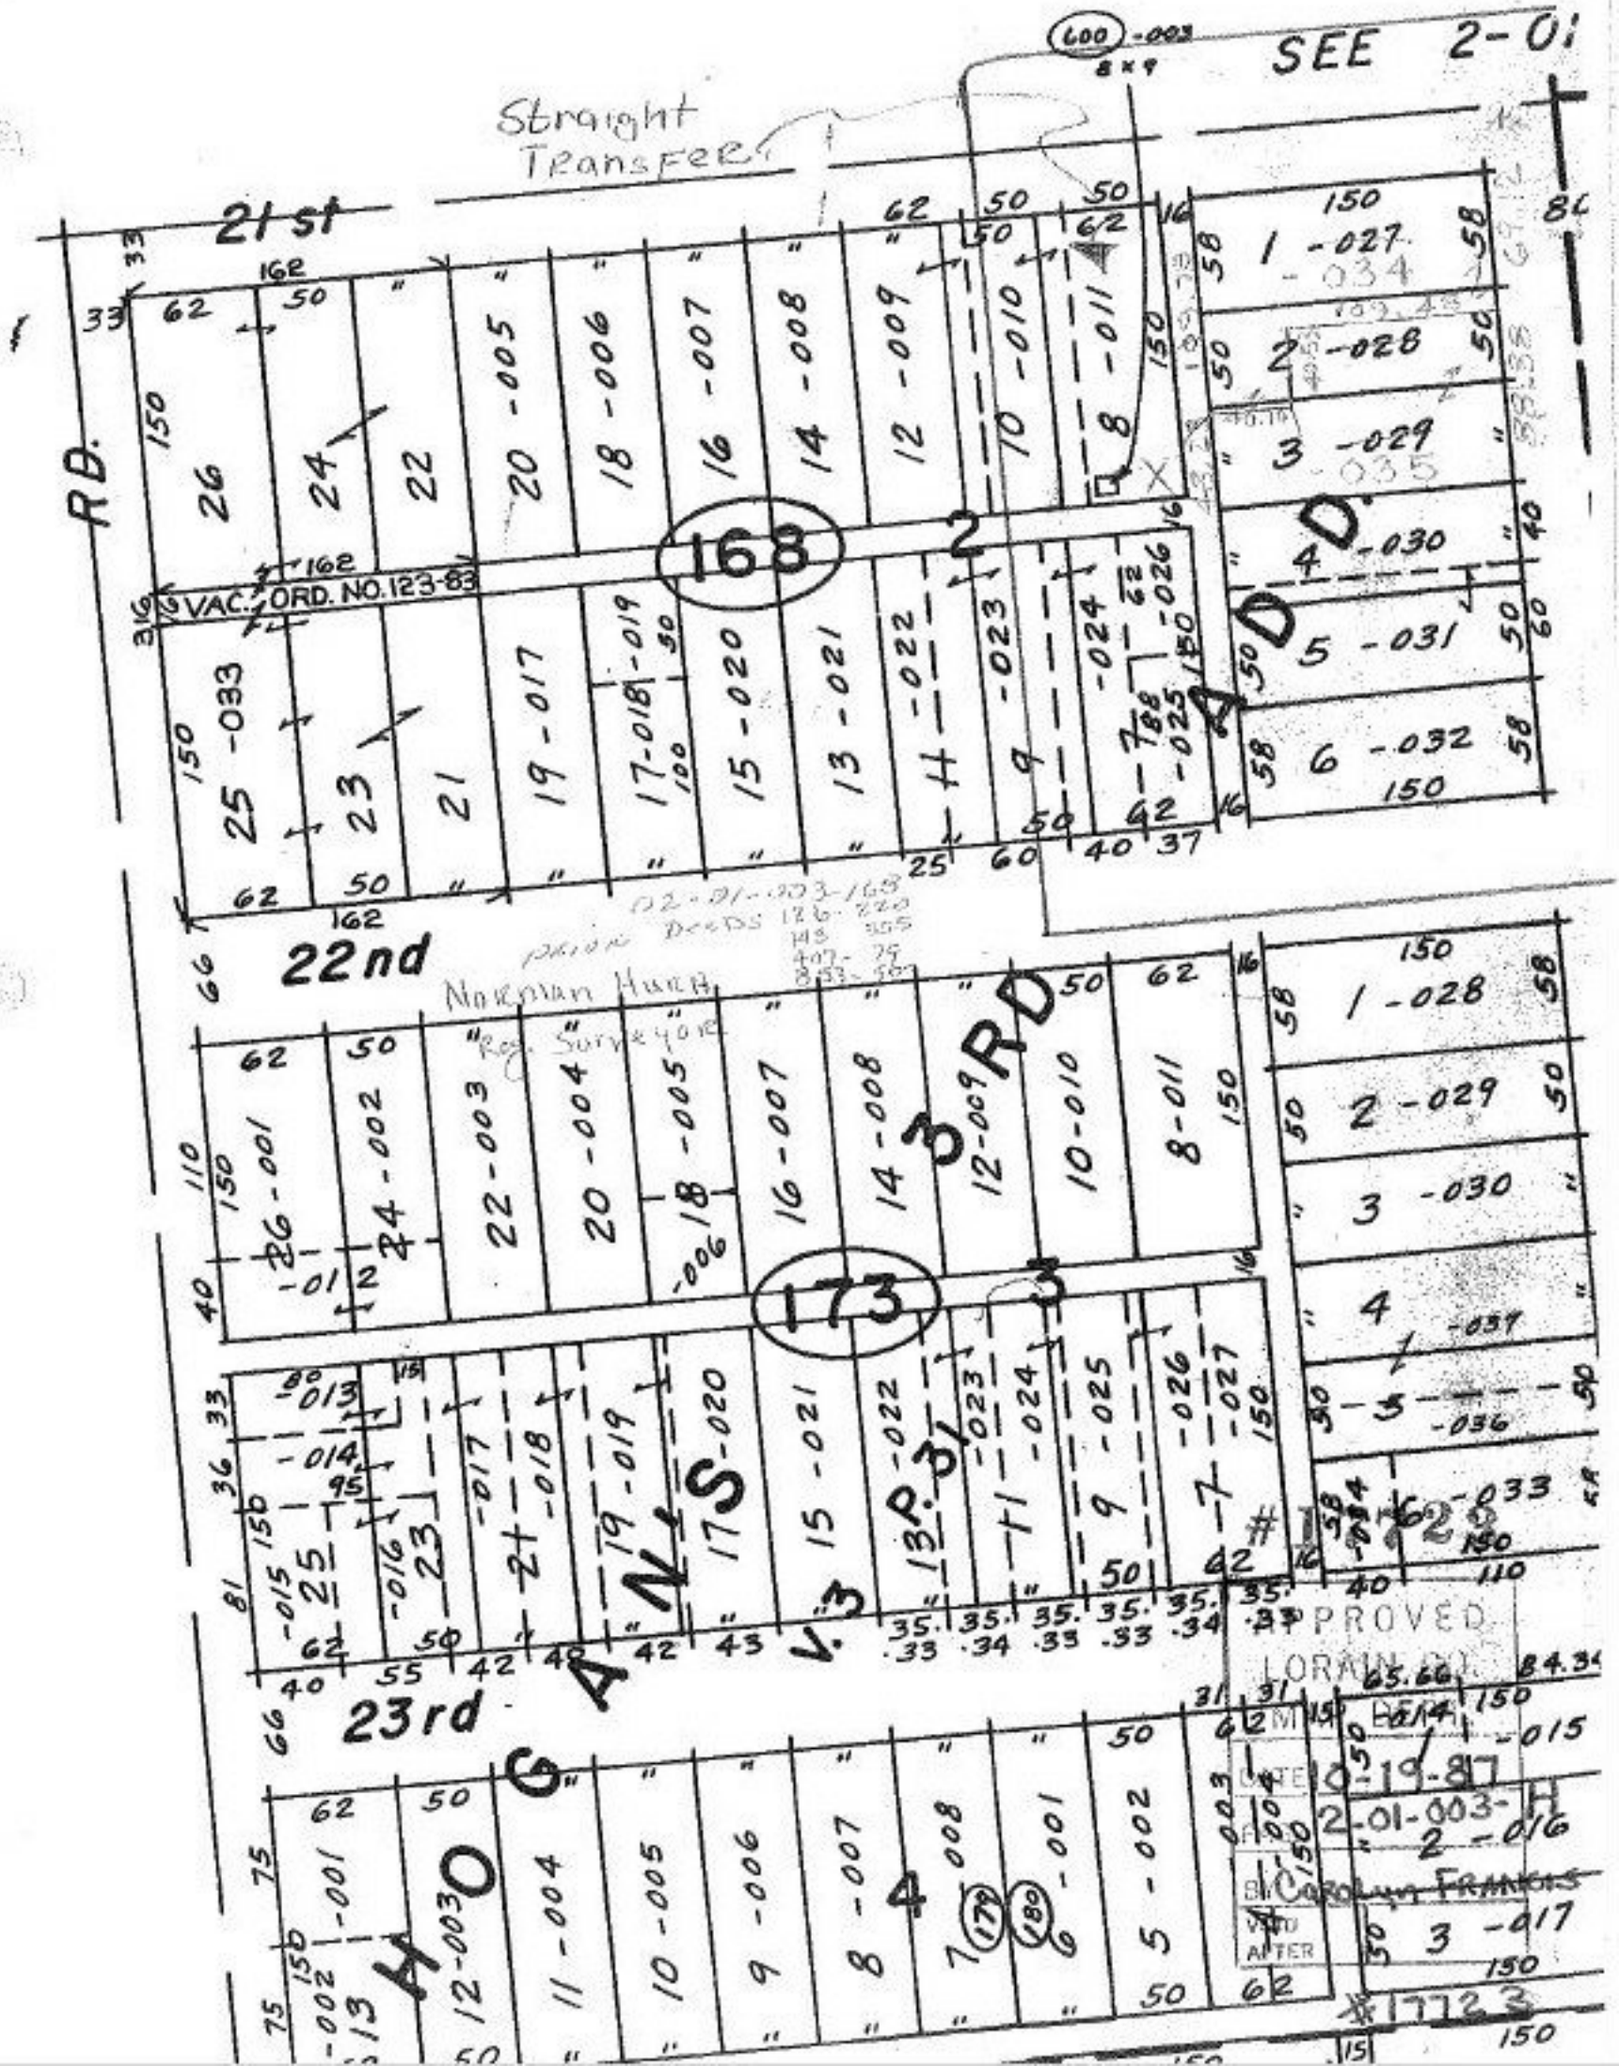

SEE 2-01
Straight Transfer
21st
22nd
23rd
RD.
VAC. ORD. NO. 123-83
168
2
173
3
3 RD
HOGANS
V. 3
ADD.
Norman Hurd
Reg. Surveyor
02-01-003-168
Prior Deeds
#17723
APPROVED
LORAIN CO.
DATE 10-19-87
2-01-003-H
Carolyn Francis