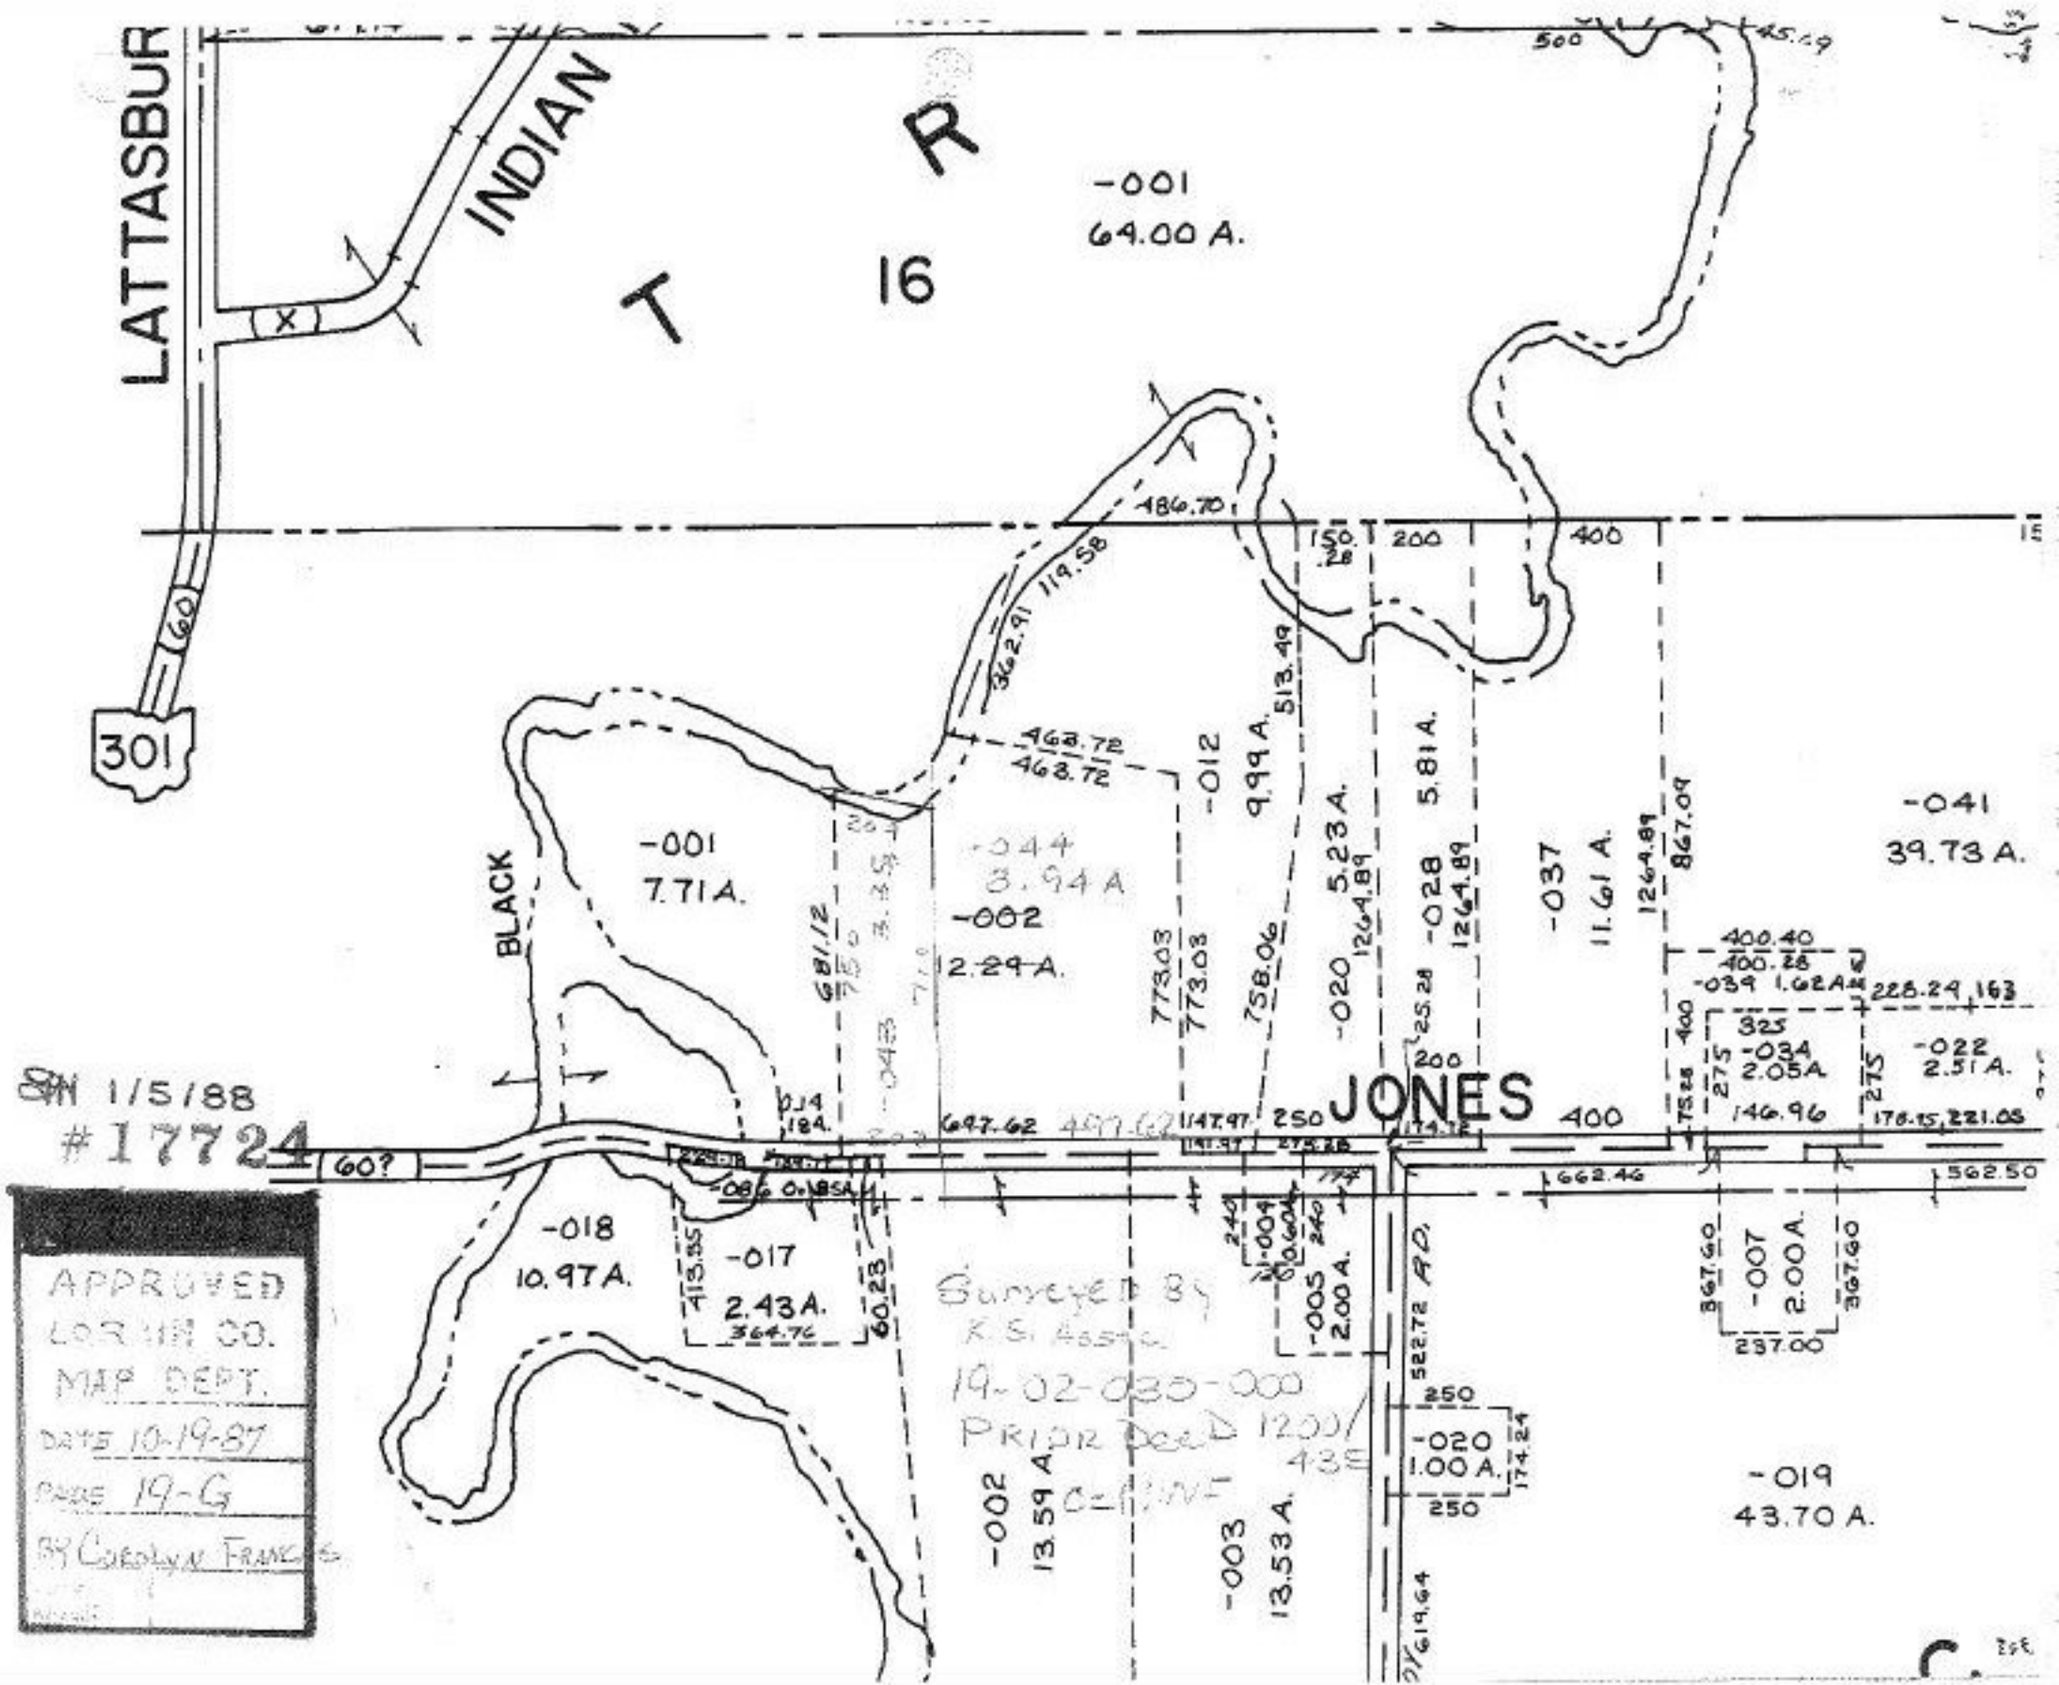
LATTASBUR
INDIAN
T R
16
-001
64.00 A.
301
60
BLACK
-001
7.71 A.
-044
3.94 A
-002
2.29 A.
-012
9.99 A.
-020
5.23 A.
-028
5.81 A.
-037
11.61 A.
-041
39.73 A.
-034
2.05 A.
-022
2.51 A.
JONES
-018
10.97 A.
-017
2.43 A.
-005
2.00 A.
-007
2.00 A.
-020
1.00 A.
-019
43.70 A.
-002
13.59 A.
-003
13.53 A.
Surveyed By
K.S. Assoc.
19-02-030-000
Prior Deed 1200/435
SN 1/5/88
#17724
APPROVED
LORAIN CO.
MAP DEPT.
DATE 10-19-87
PAGE 19-G
BY Carolyn Francis