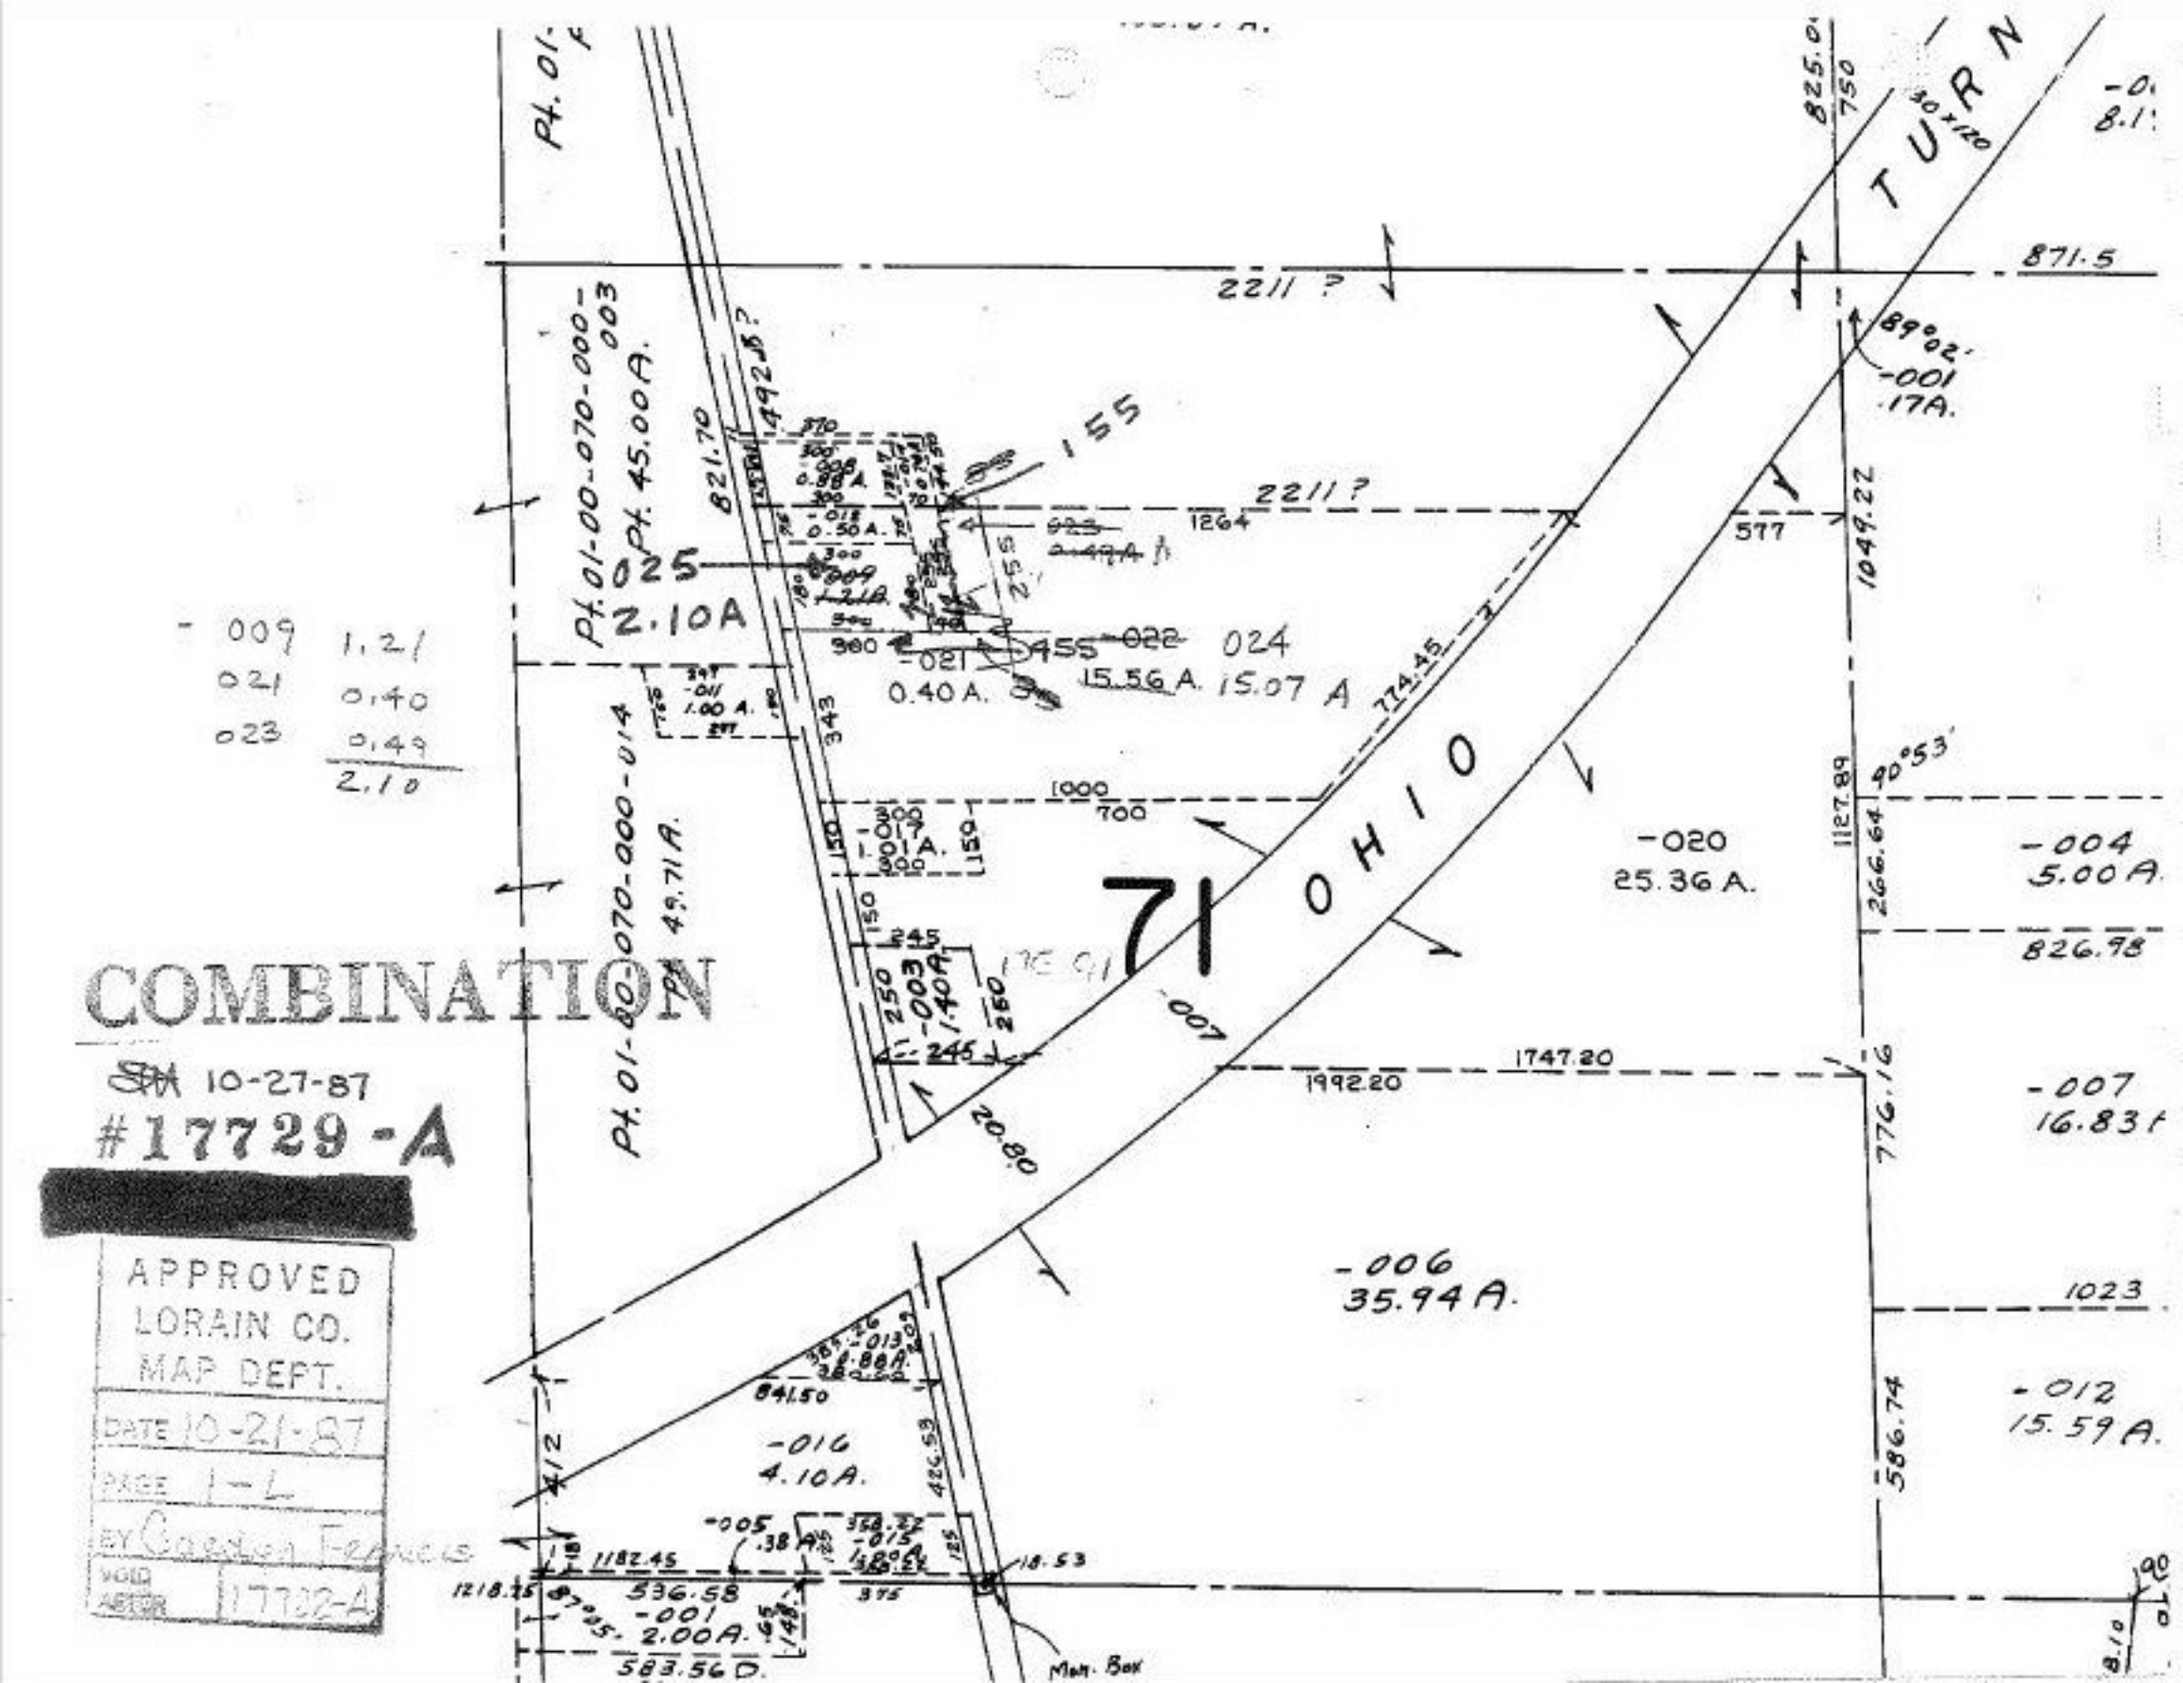
COMBINATION
SM 10-27-87
#17729-A
APPROVED
LORAIN CO.
MAP DEPT.
DATE 10-21-87
PAGE 1-L
BY Carolyn Frances
VOID AFTER 17732-A
Pt. 01-00-070-000-003
Pt. 45.00A.
2.10A
Pt. 01-00-070-000-014
Pt. 49.71A.
-009 1.21
-021 0.40
-023 0.49
2.10
-025
-021
0.40 A.
-022
15.56 A.
-024
15.07 A
-020
25.36 A.
-004
5.00 A.
-007
16.83 A
-006
35.94 A.
-012
15.59 A.
-016
4.10A.
-005
.38 A.
-001
2.00A.
-001
.17A.
-003
1.40A.
71
OHIO
TURN
2211 ?
1747.20
1992.20
1049.22
871.5
825.01
750
821.70
1492.58?
774.45
1127.89
266.64
826.98
776.16
1023
586.74
1182.45
536.58
583.56 D.
1218.25
841.50
426.53
412
Mon. Box