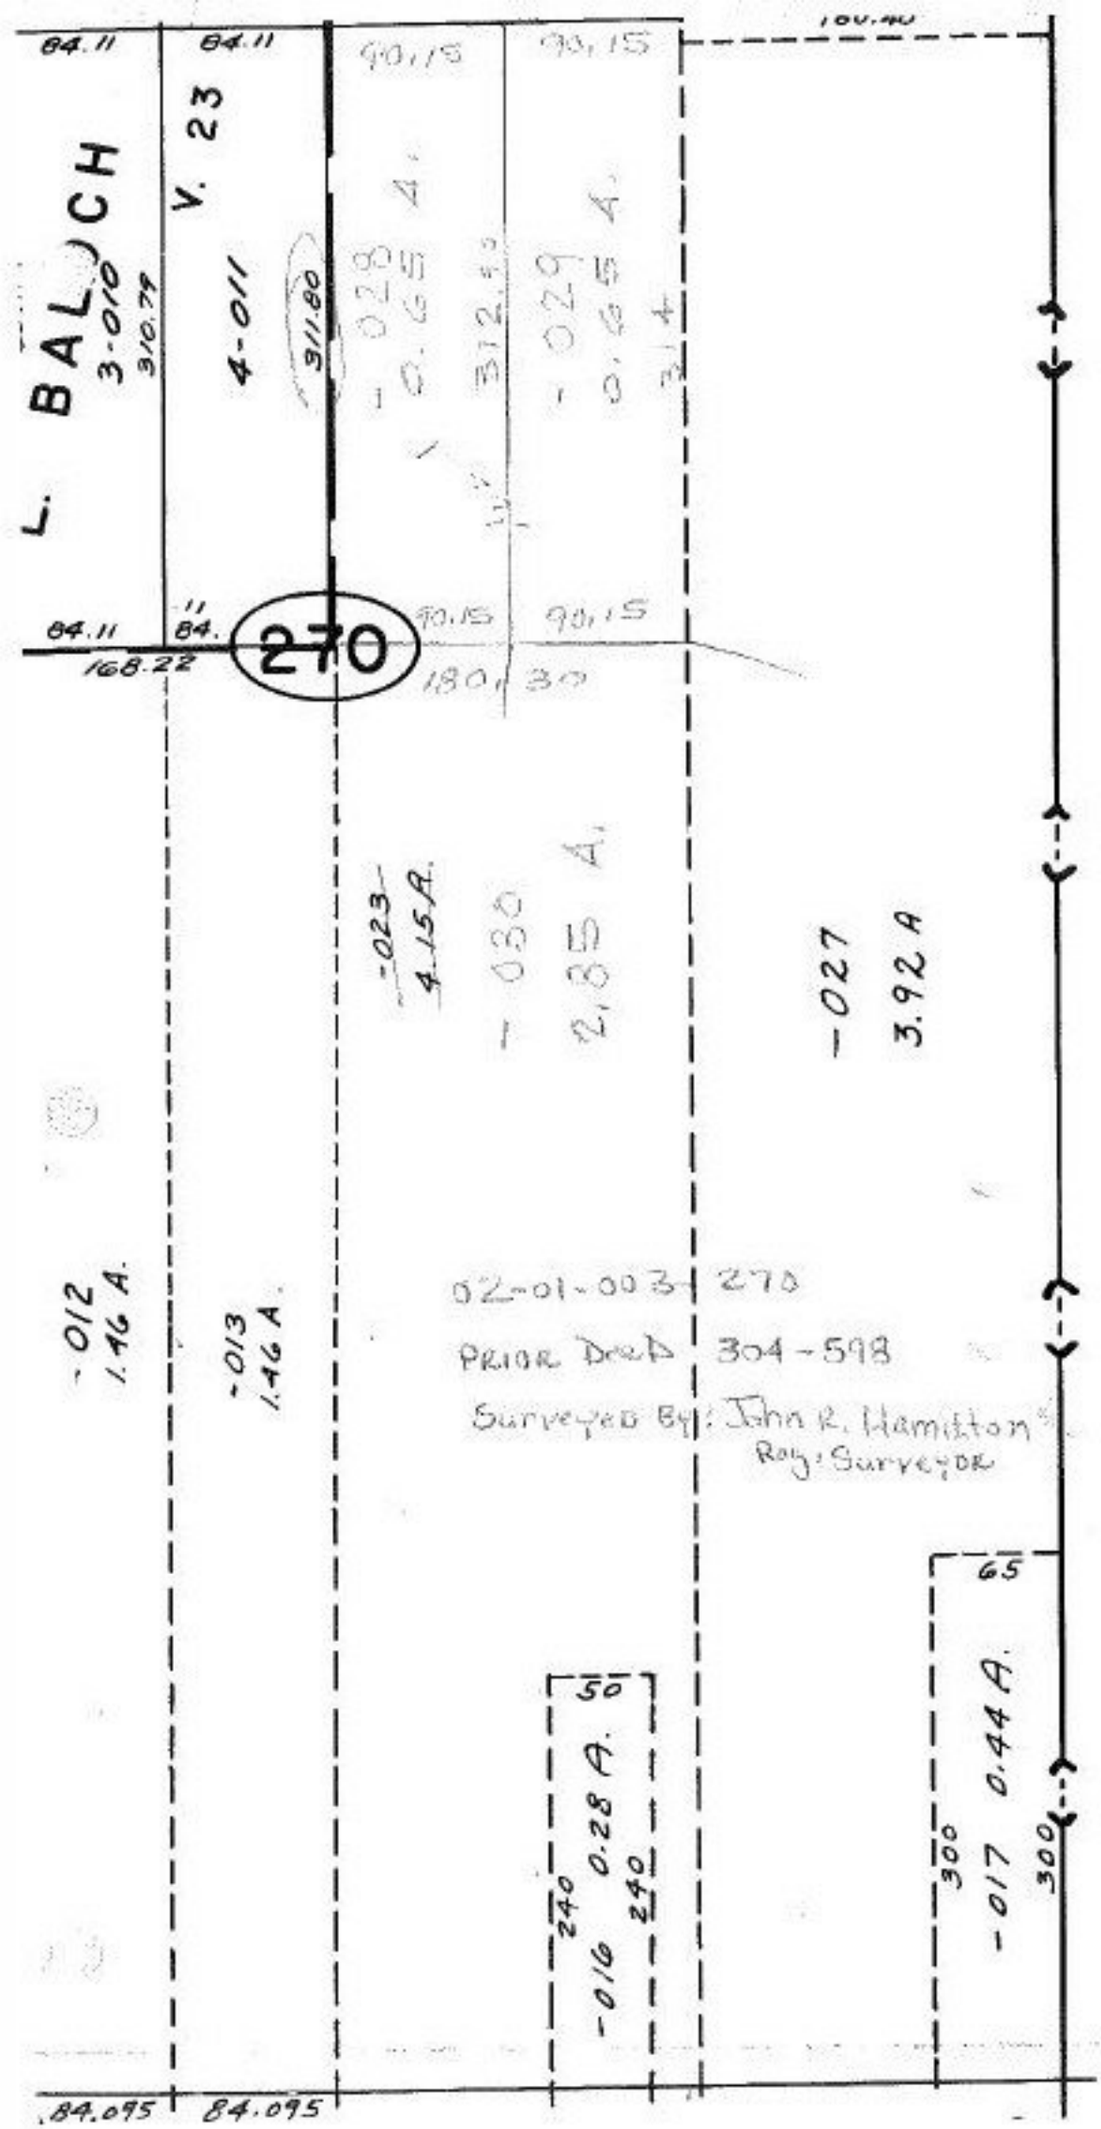


#17730

APPROVED
LORAIN CO.
MAP DEPT.
DATE 10-20-87
PAGE 2-01-003N
BY C. Francis
VOID AFTER 17730