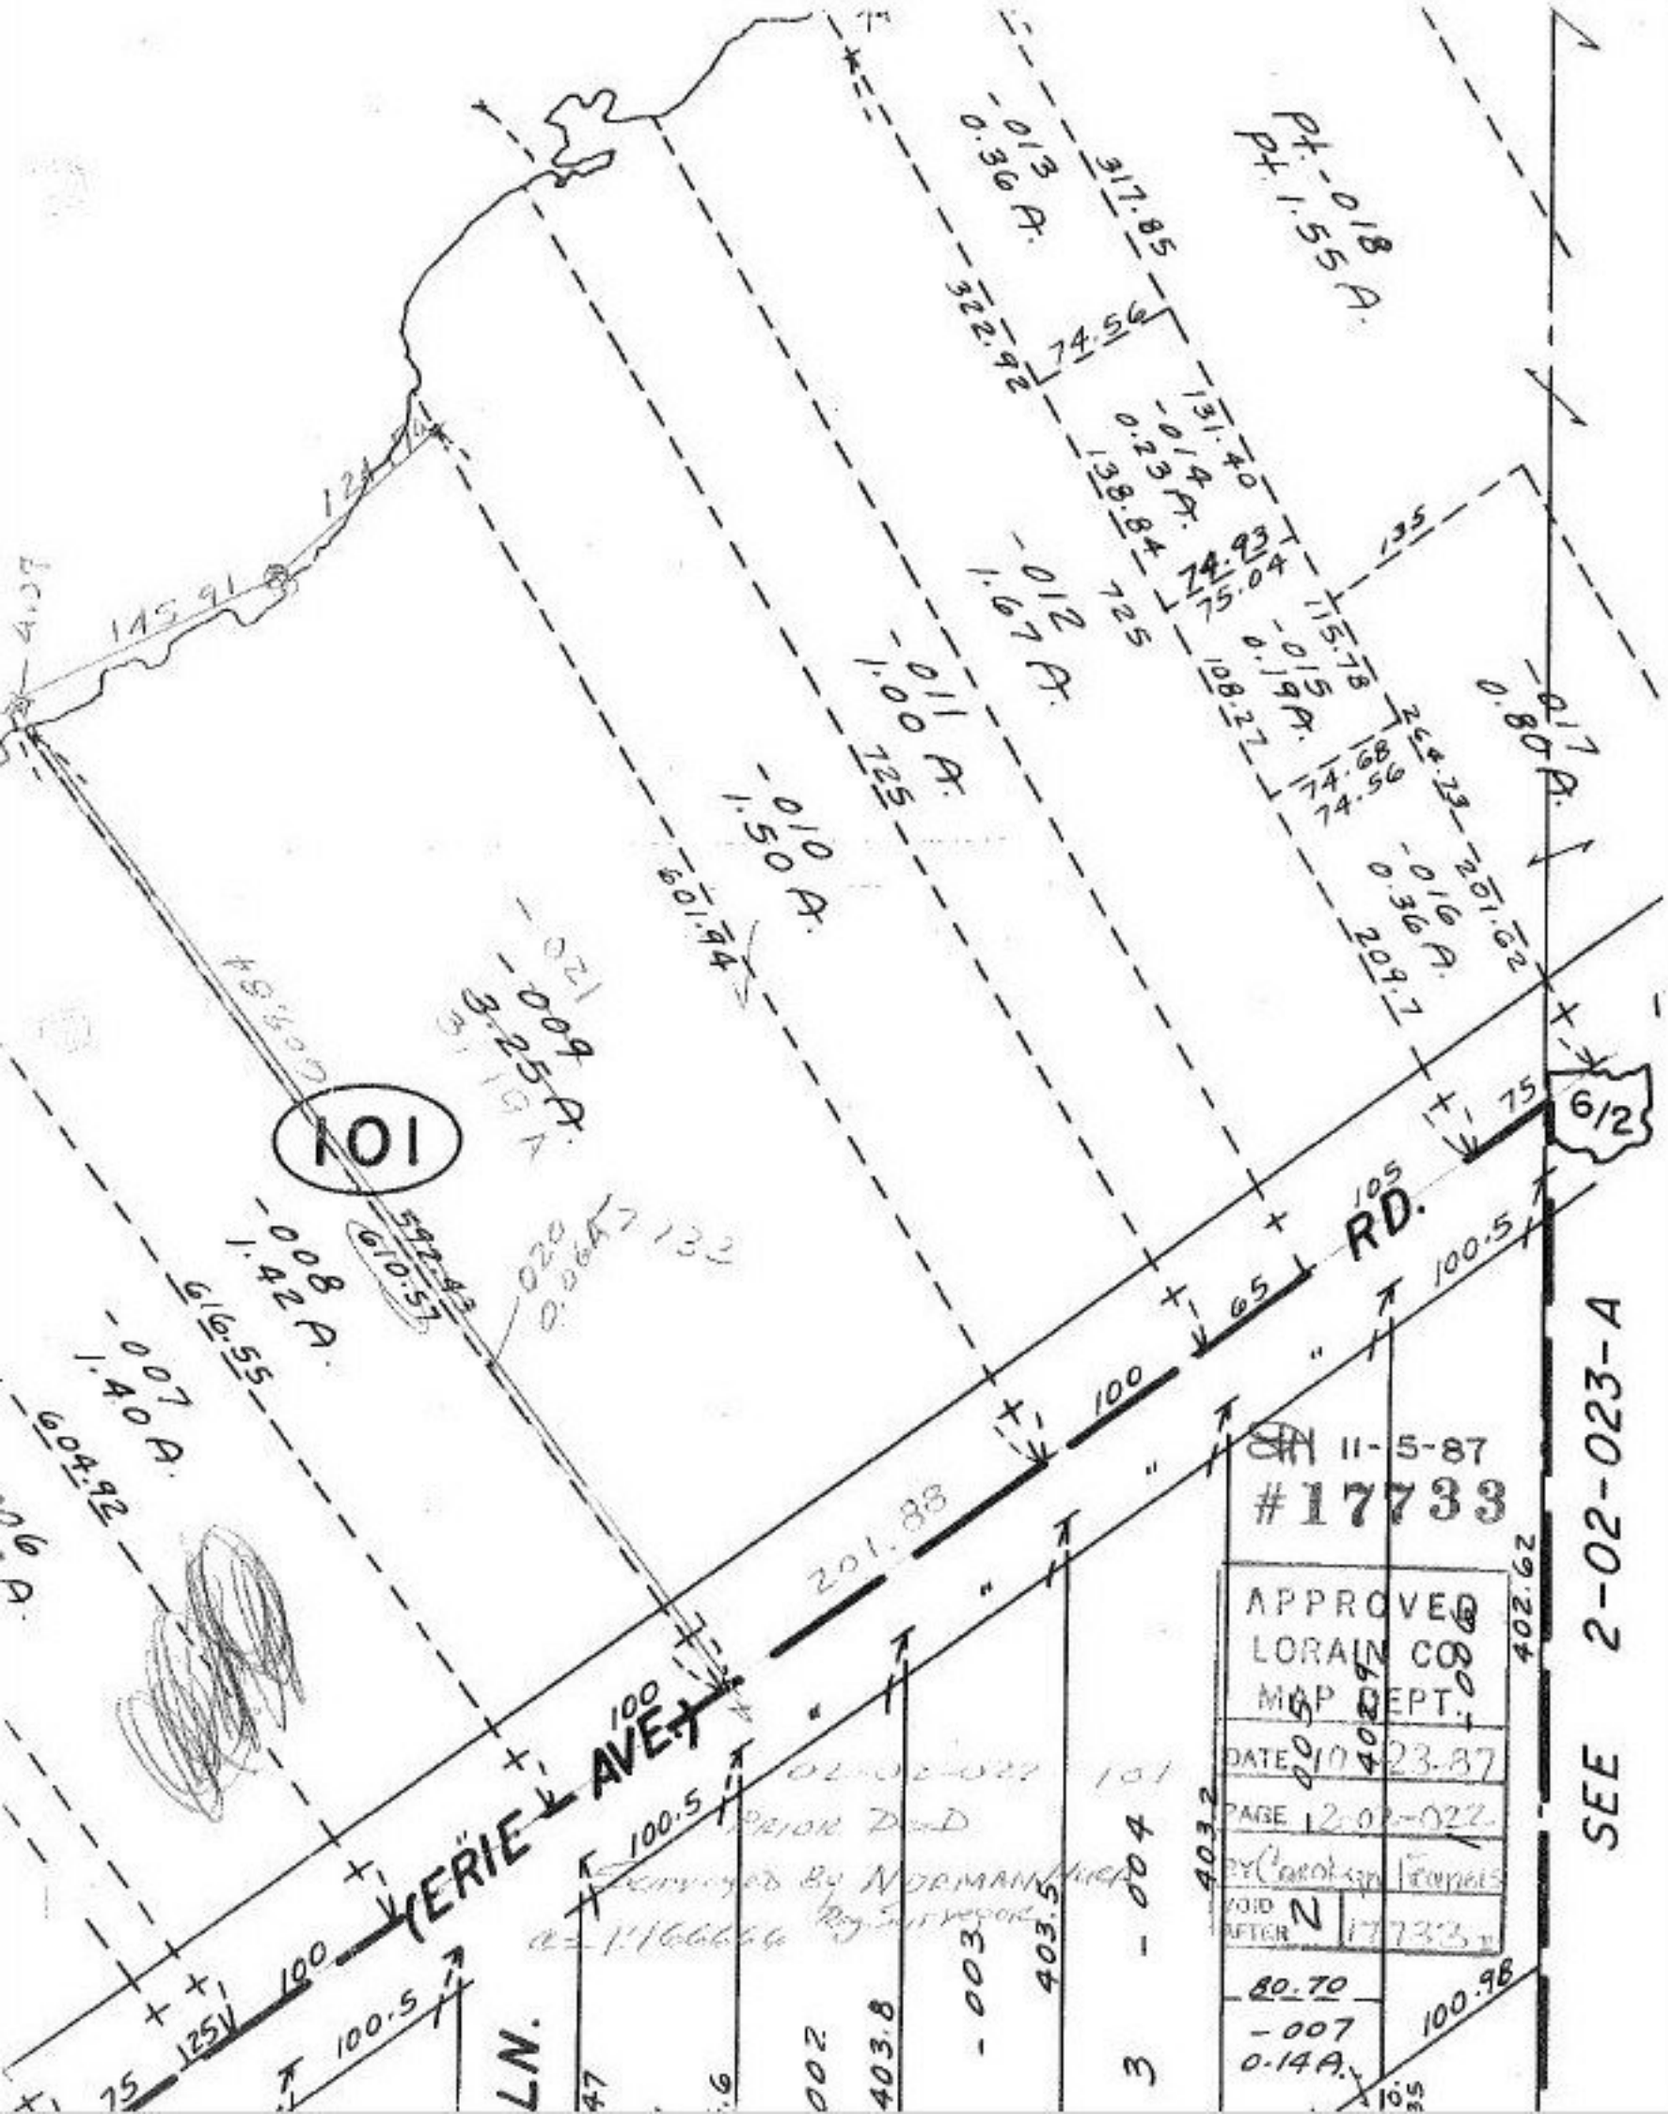

101
6/2
RD.
ERIE AVE.
LN.
SEE 2-02-023-A
Pt. -018
Pt. 1.55 A.
-013
0.36 A.
-014
0.23 A.
-015
0.19 A.
-016
0.36 A.
-017
0.80 A.
-012
1.67 A.
-011
1.00 A.
-010
1.50 A.
-009
3.25 A.
-008
1.42 A.
-007
1.40 A.
-007
0.14 A.
-004
-003
-002
-006
-005
317.85
322.92
74.56
131.40
138.84
74.93
75.04
725
115.78
108.27
74.68
74.56
264.23
201.62
209.7
601.94
592.43
610.57
616.55
604.92
145.91
121.76
201.88
100.5
100.98
402.62
403.2
403.5
403.8
80.70
11-5-87
#17733
APPROVED
LORAIN CO.
MAP DEPT.
DATE 10-23-87
PAGE 2-02-022
BY Carolyn Francis
VOID AFTER 17733