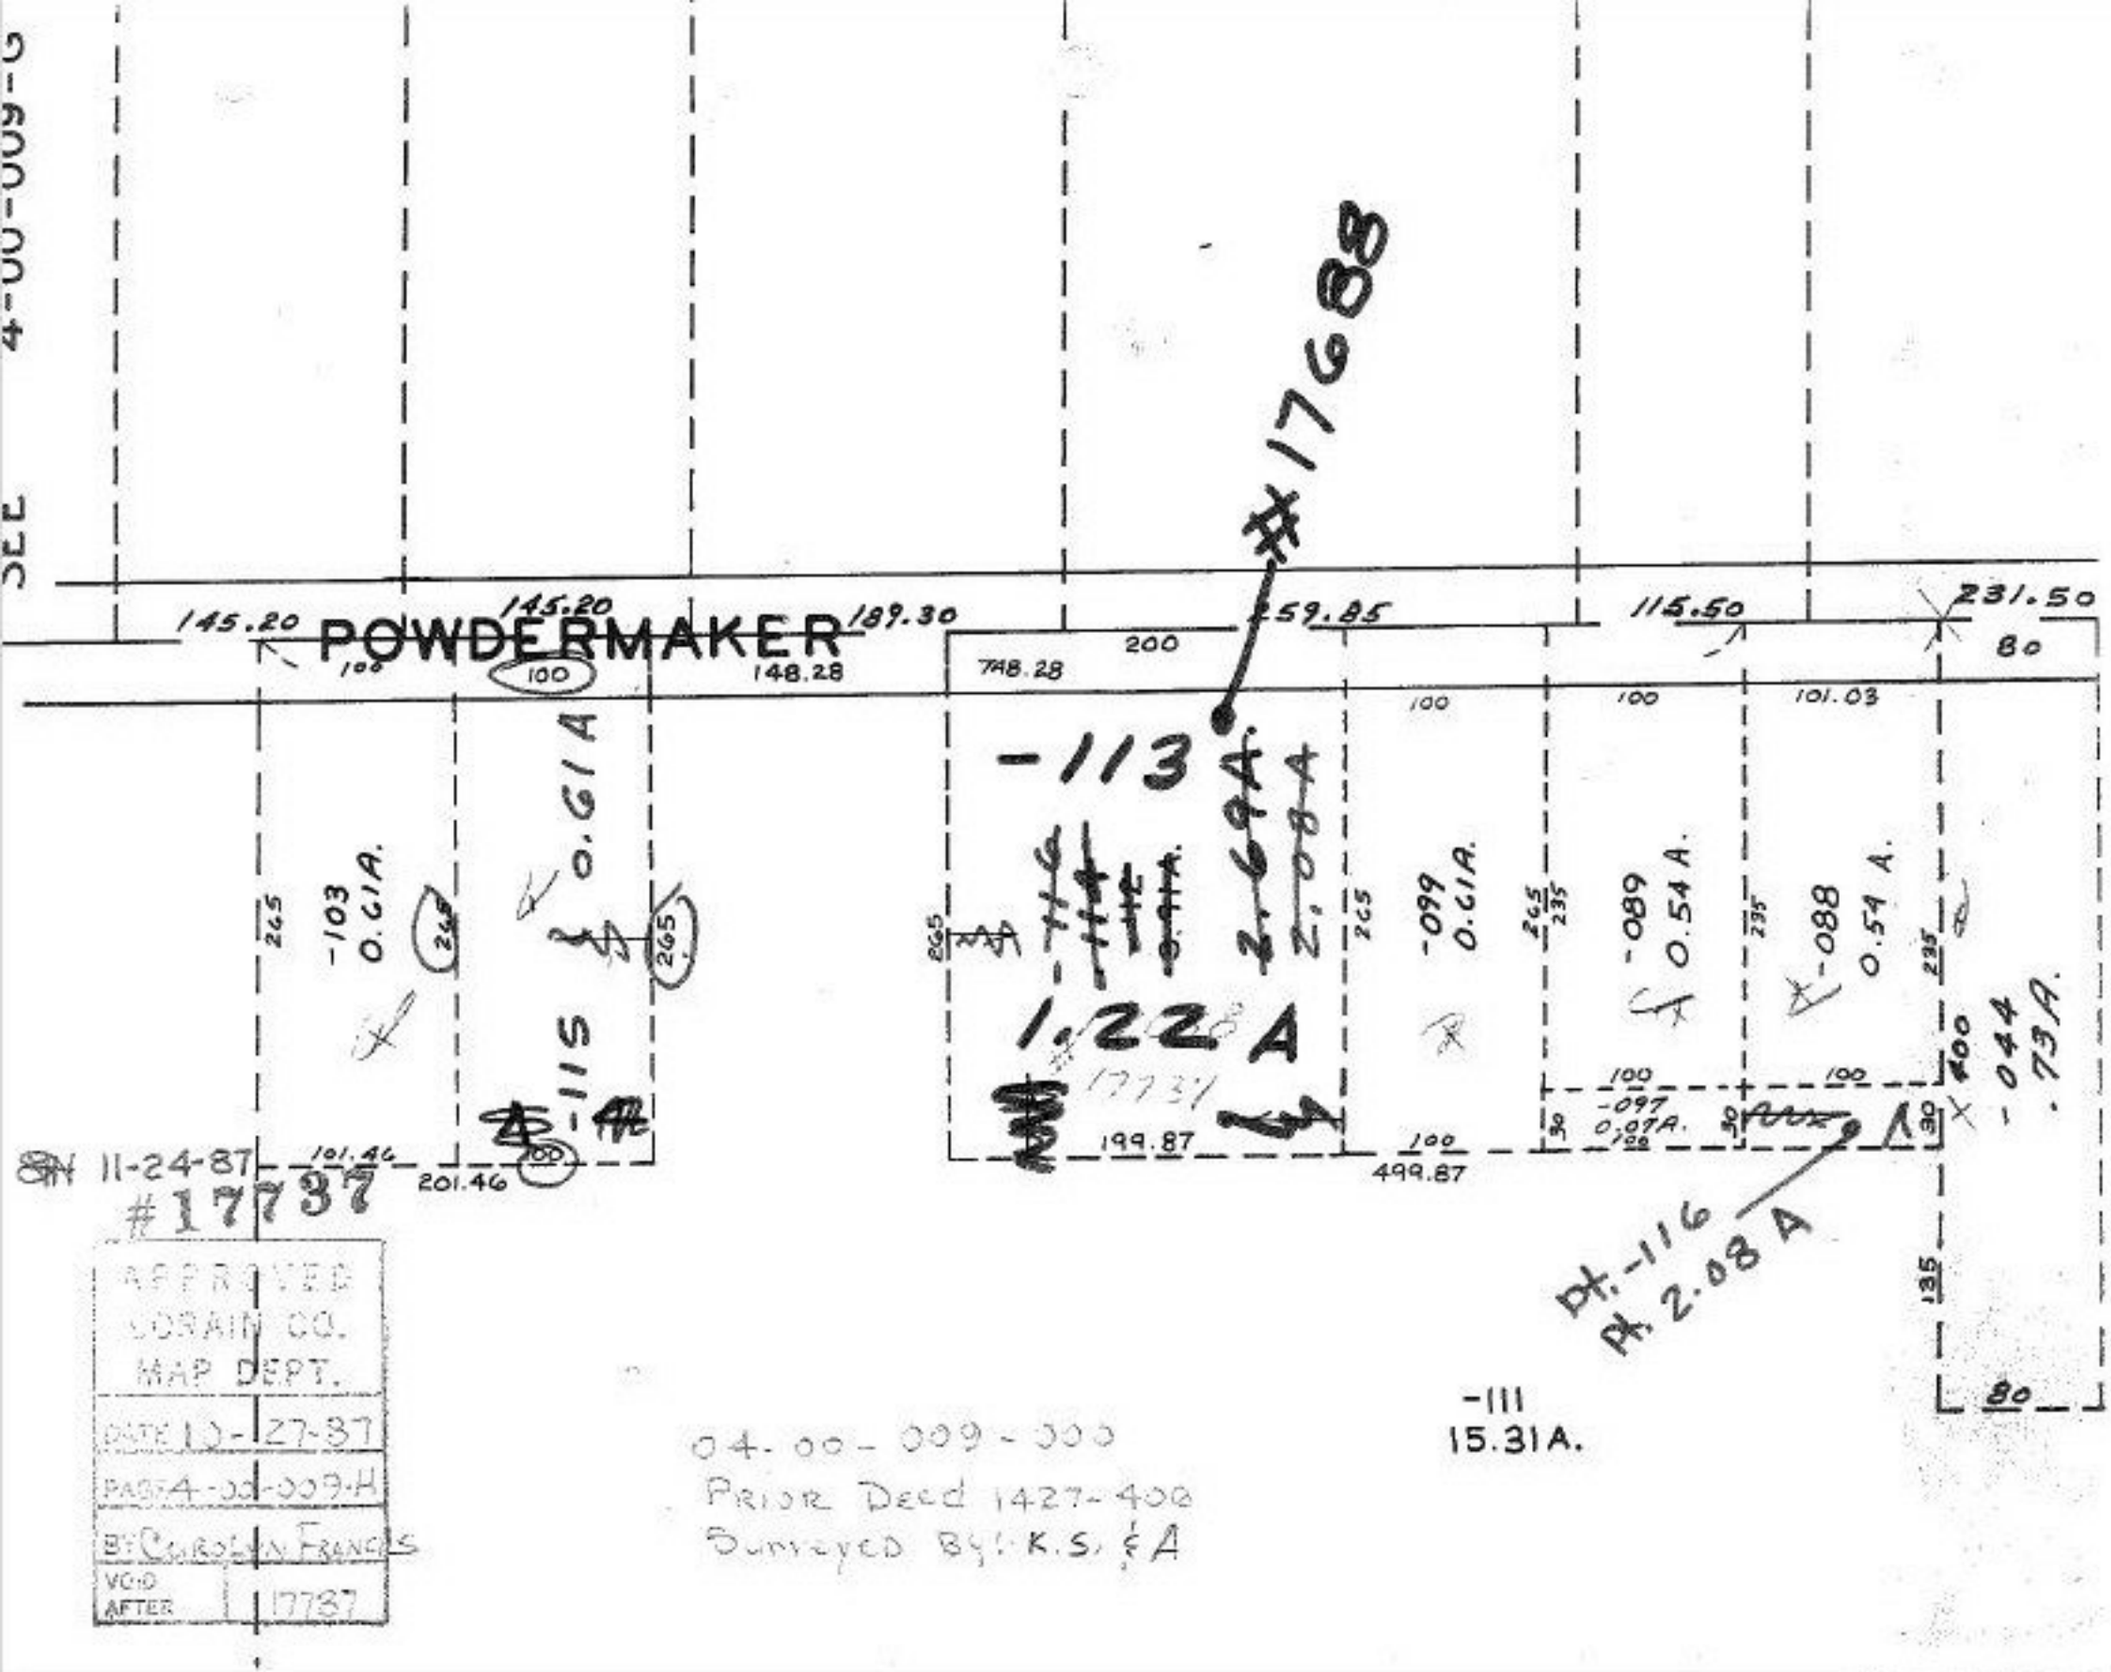
4-00-009-0
SEE
#17688
145.20
145.20
POWDERMAKER
189.30
259.85
115.50
231.50
100
100
148.28
748.28
200
80
100
100
101.03
-113
2.694A.
2.084
-103
0.61A.
-115
0.61A
-116
1.228A
17737
-099
0.61A.
-089
0.54 A.
-088
0.54 A.
-044
.73A.
-097
0.07A.
265
235
400
199.87
499.87
101.46
201.46
135
80
Pt. -116
Pt. 2.08 A
-111
15.31A.
11-24-87
#17737
APPROVED
LORAIN CO.
MAP DEPT.
DATE 12-27-87
PAGE 4-00-009-H
BY: Carolyn Francis
VOID AFTER 17737
04-00-009-000
Prior Deed 1427-400
Surveyed By: K.S. & A