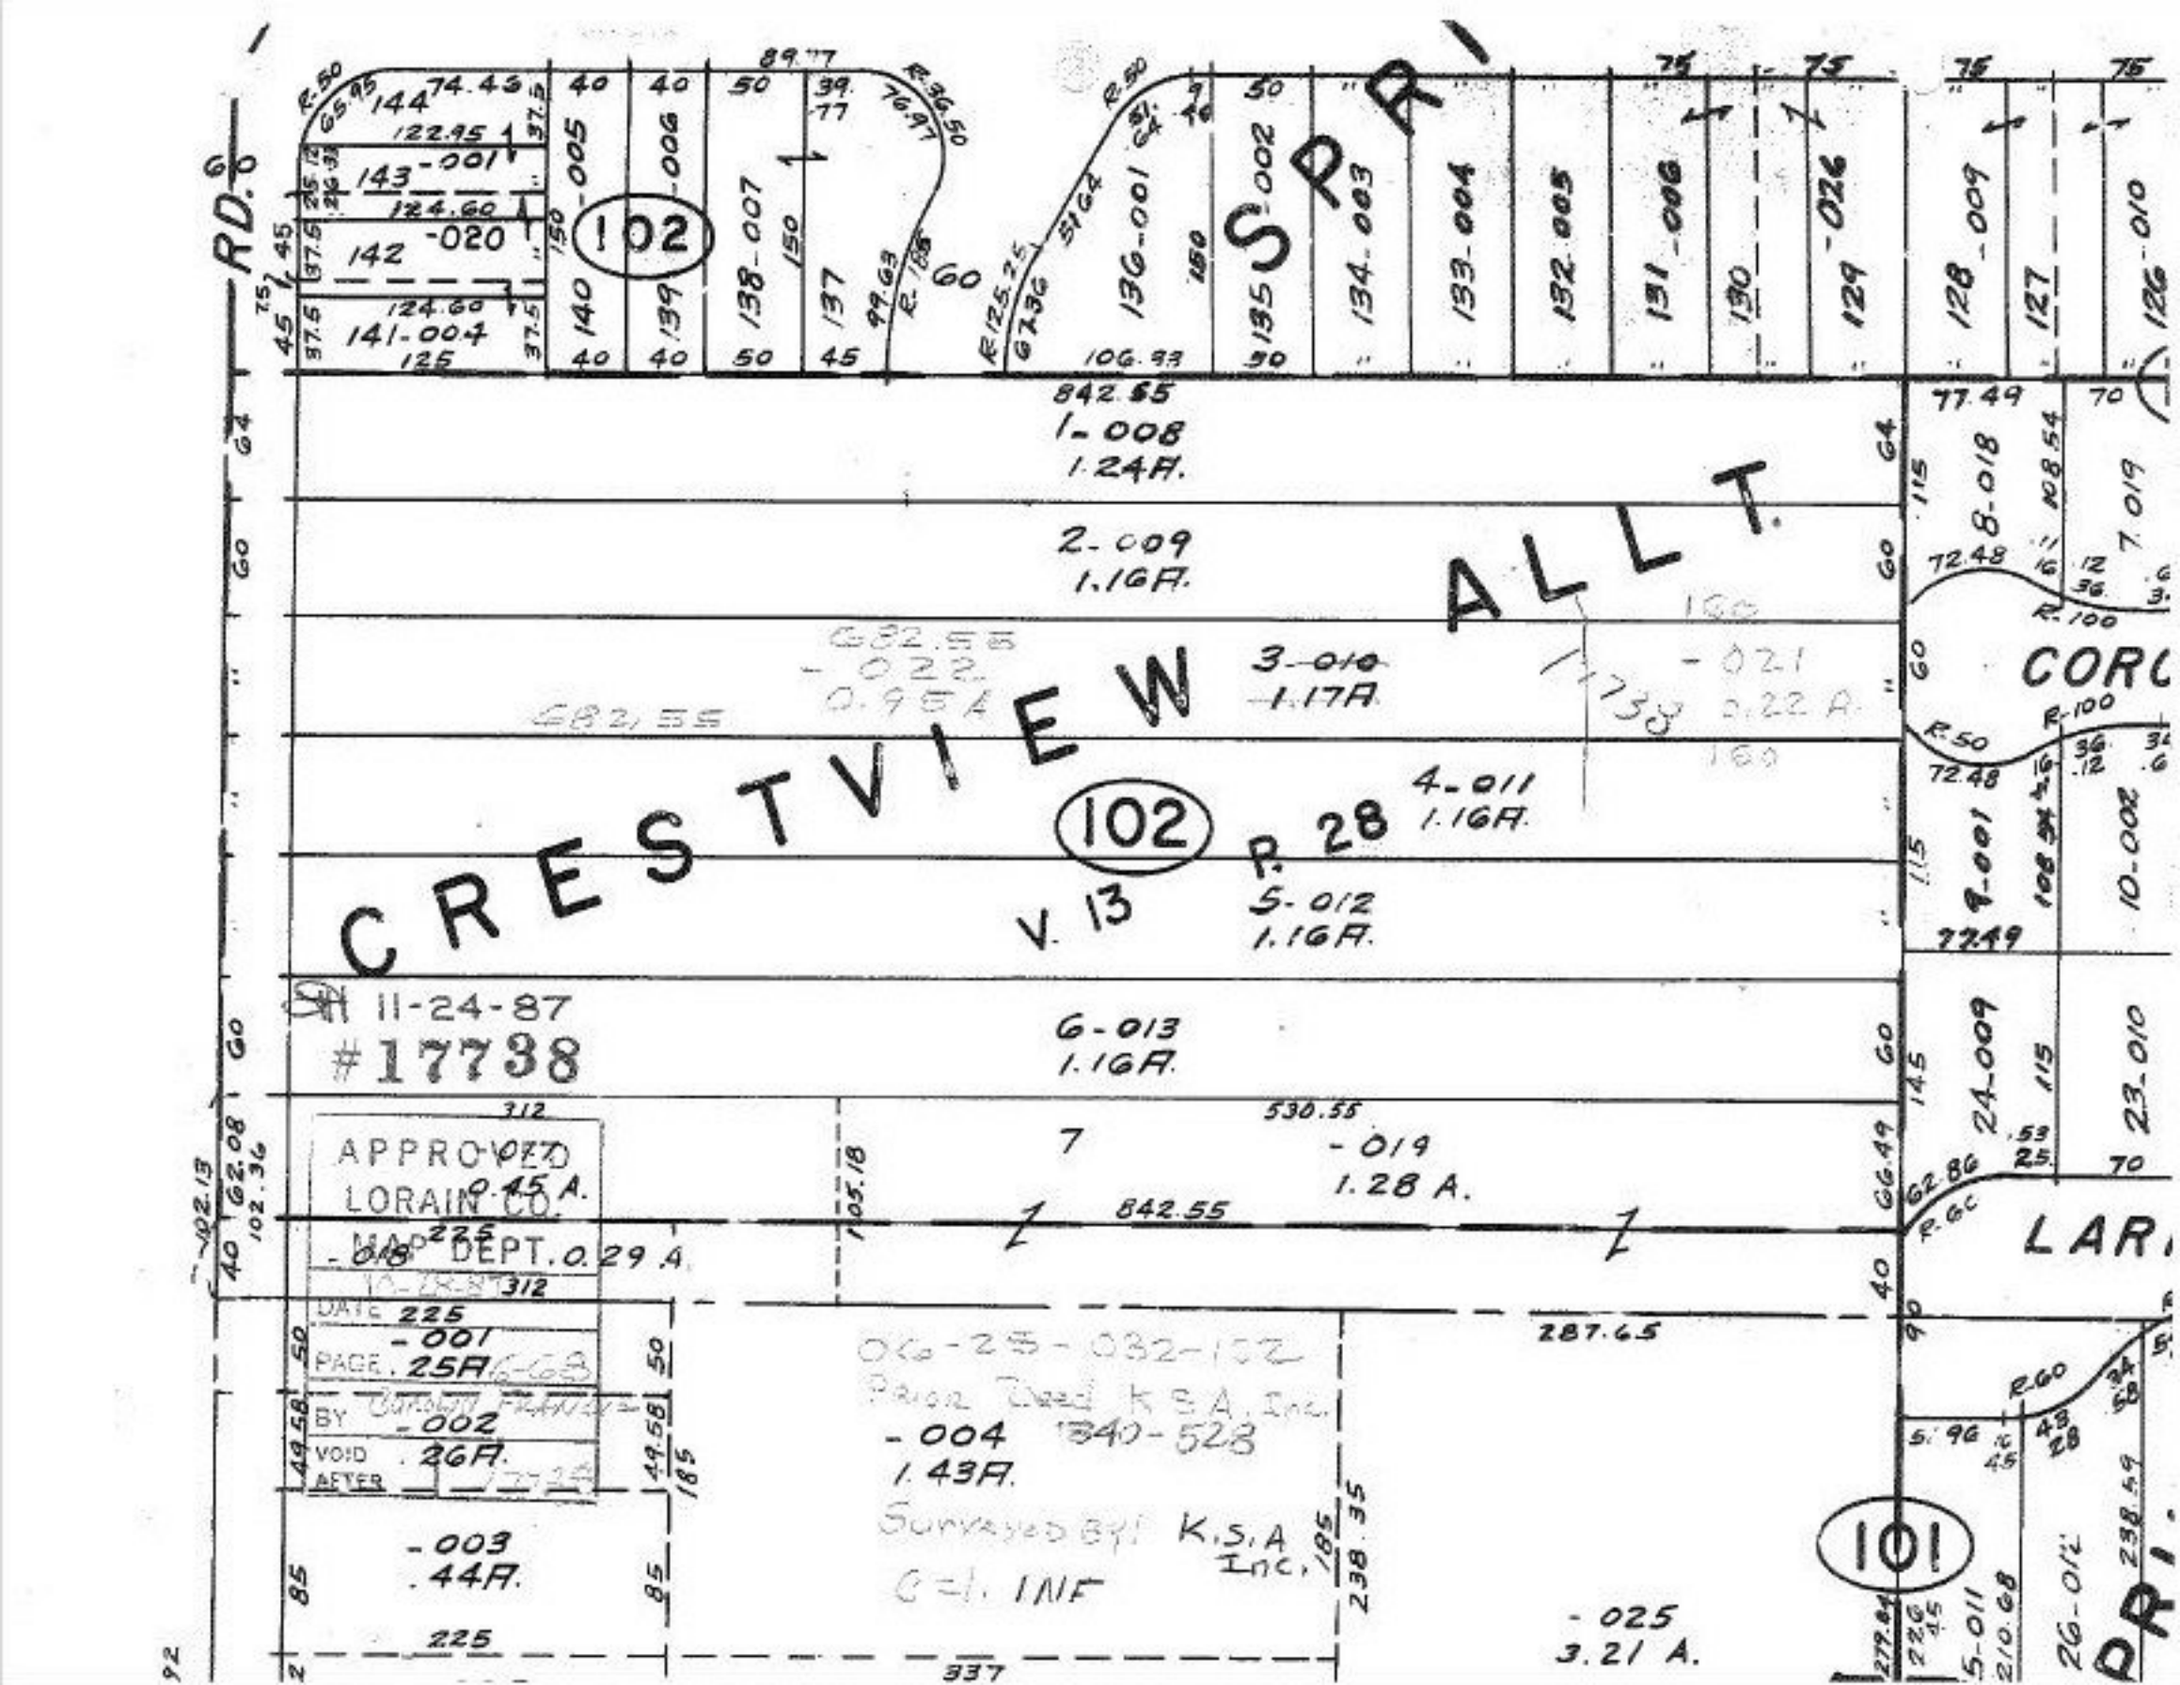

CRESTVIEW ALLT.
SPRI
RD.
102
101
V. 13
P. 28
1-008
1.24A.
2-009
1.16A.
3-010
1.17A.
4-011
1.16A.
5-012
1.16A.
6-013
1.16A.
7
-019
1.28 A.
-004
1.43A.
-003
.44A.
-025
3.21 A.
-001
.25A.
-002
.26A.
-018
0.29 A.
-017
0.45 A.
-022
0.95 A.
-021
0.22 A.
682.55
842.55
530.55
287.65
11-24-87
#17738
APPROVED
LORAIN CO.
MAP DEPT.
DATE
PAGE
BY
VOID
AFTER
06-25-032-102
Prior Deed K.S.A. Inc.
340-528
Surveyed By: K.S.A Inc.
C=1. INF
CORO
LAR