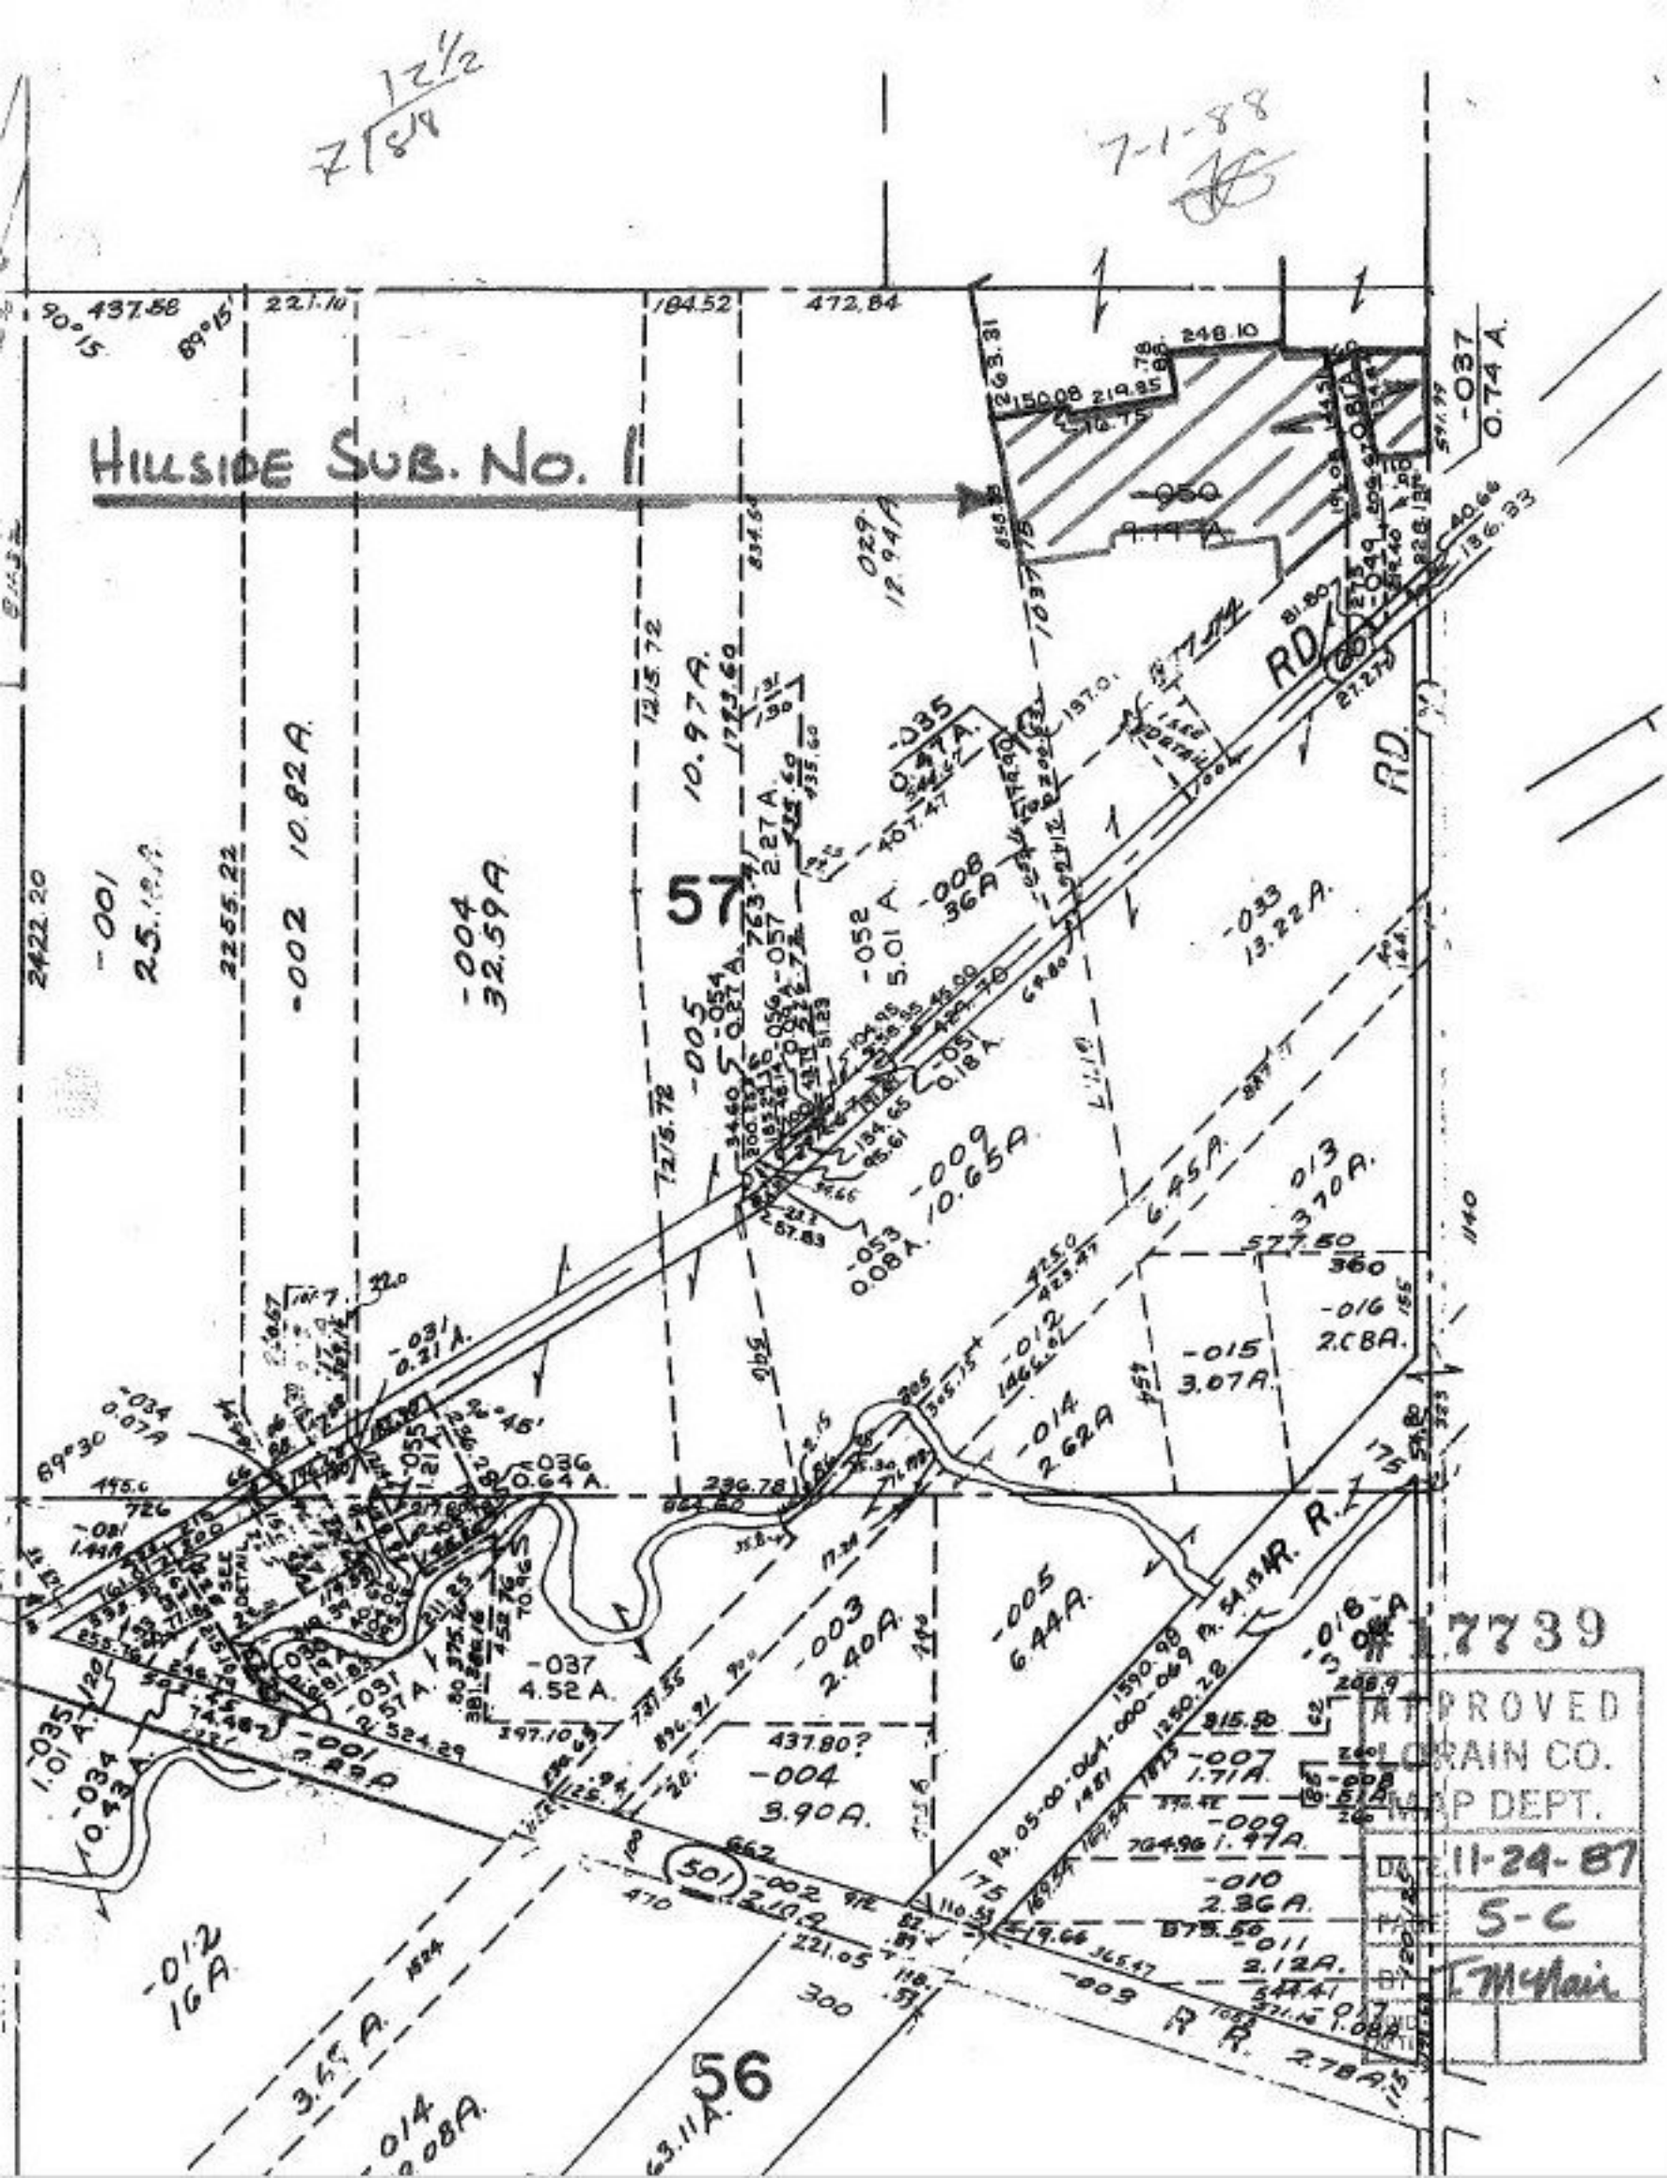
HILLSIDE SUB. NO. 1
RD.
RD.
57
56
501
7-1-88
APPROVED
LORAIN CO.
MAP DEPT.
DATE 11-24-87
PAGE 5-C
BY L. McClain
17739