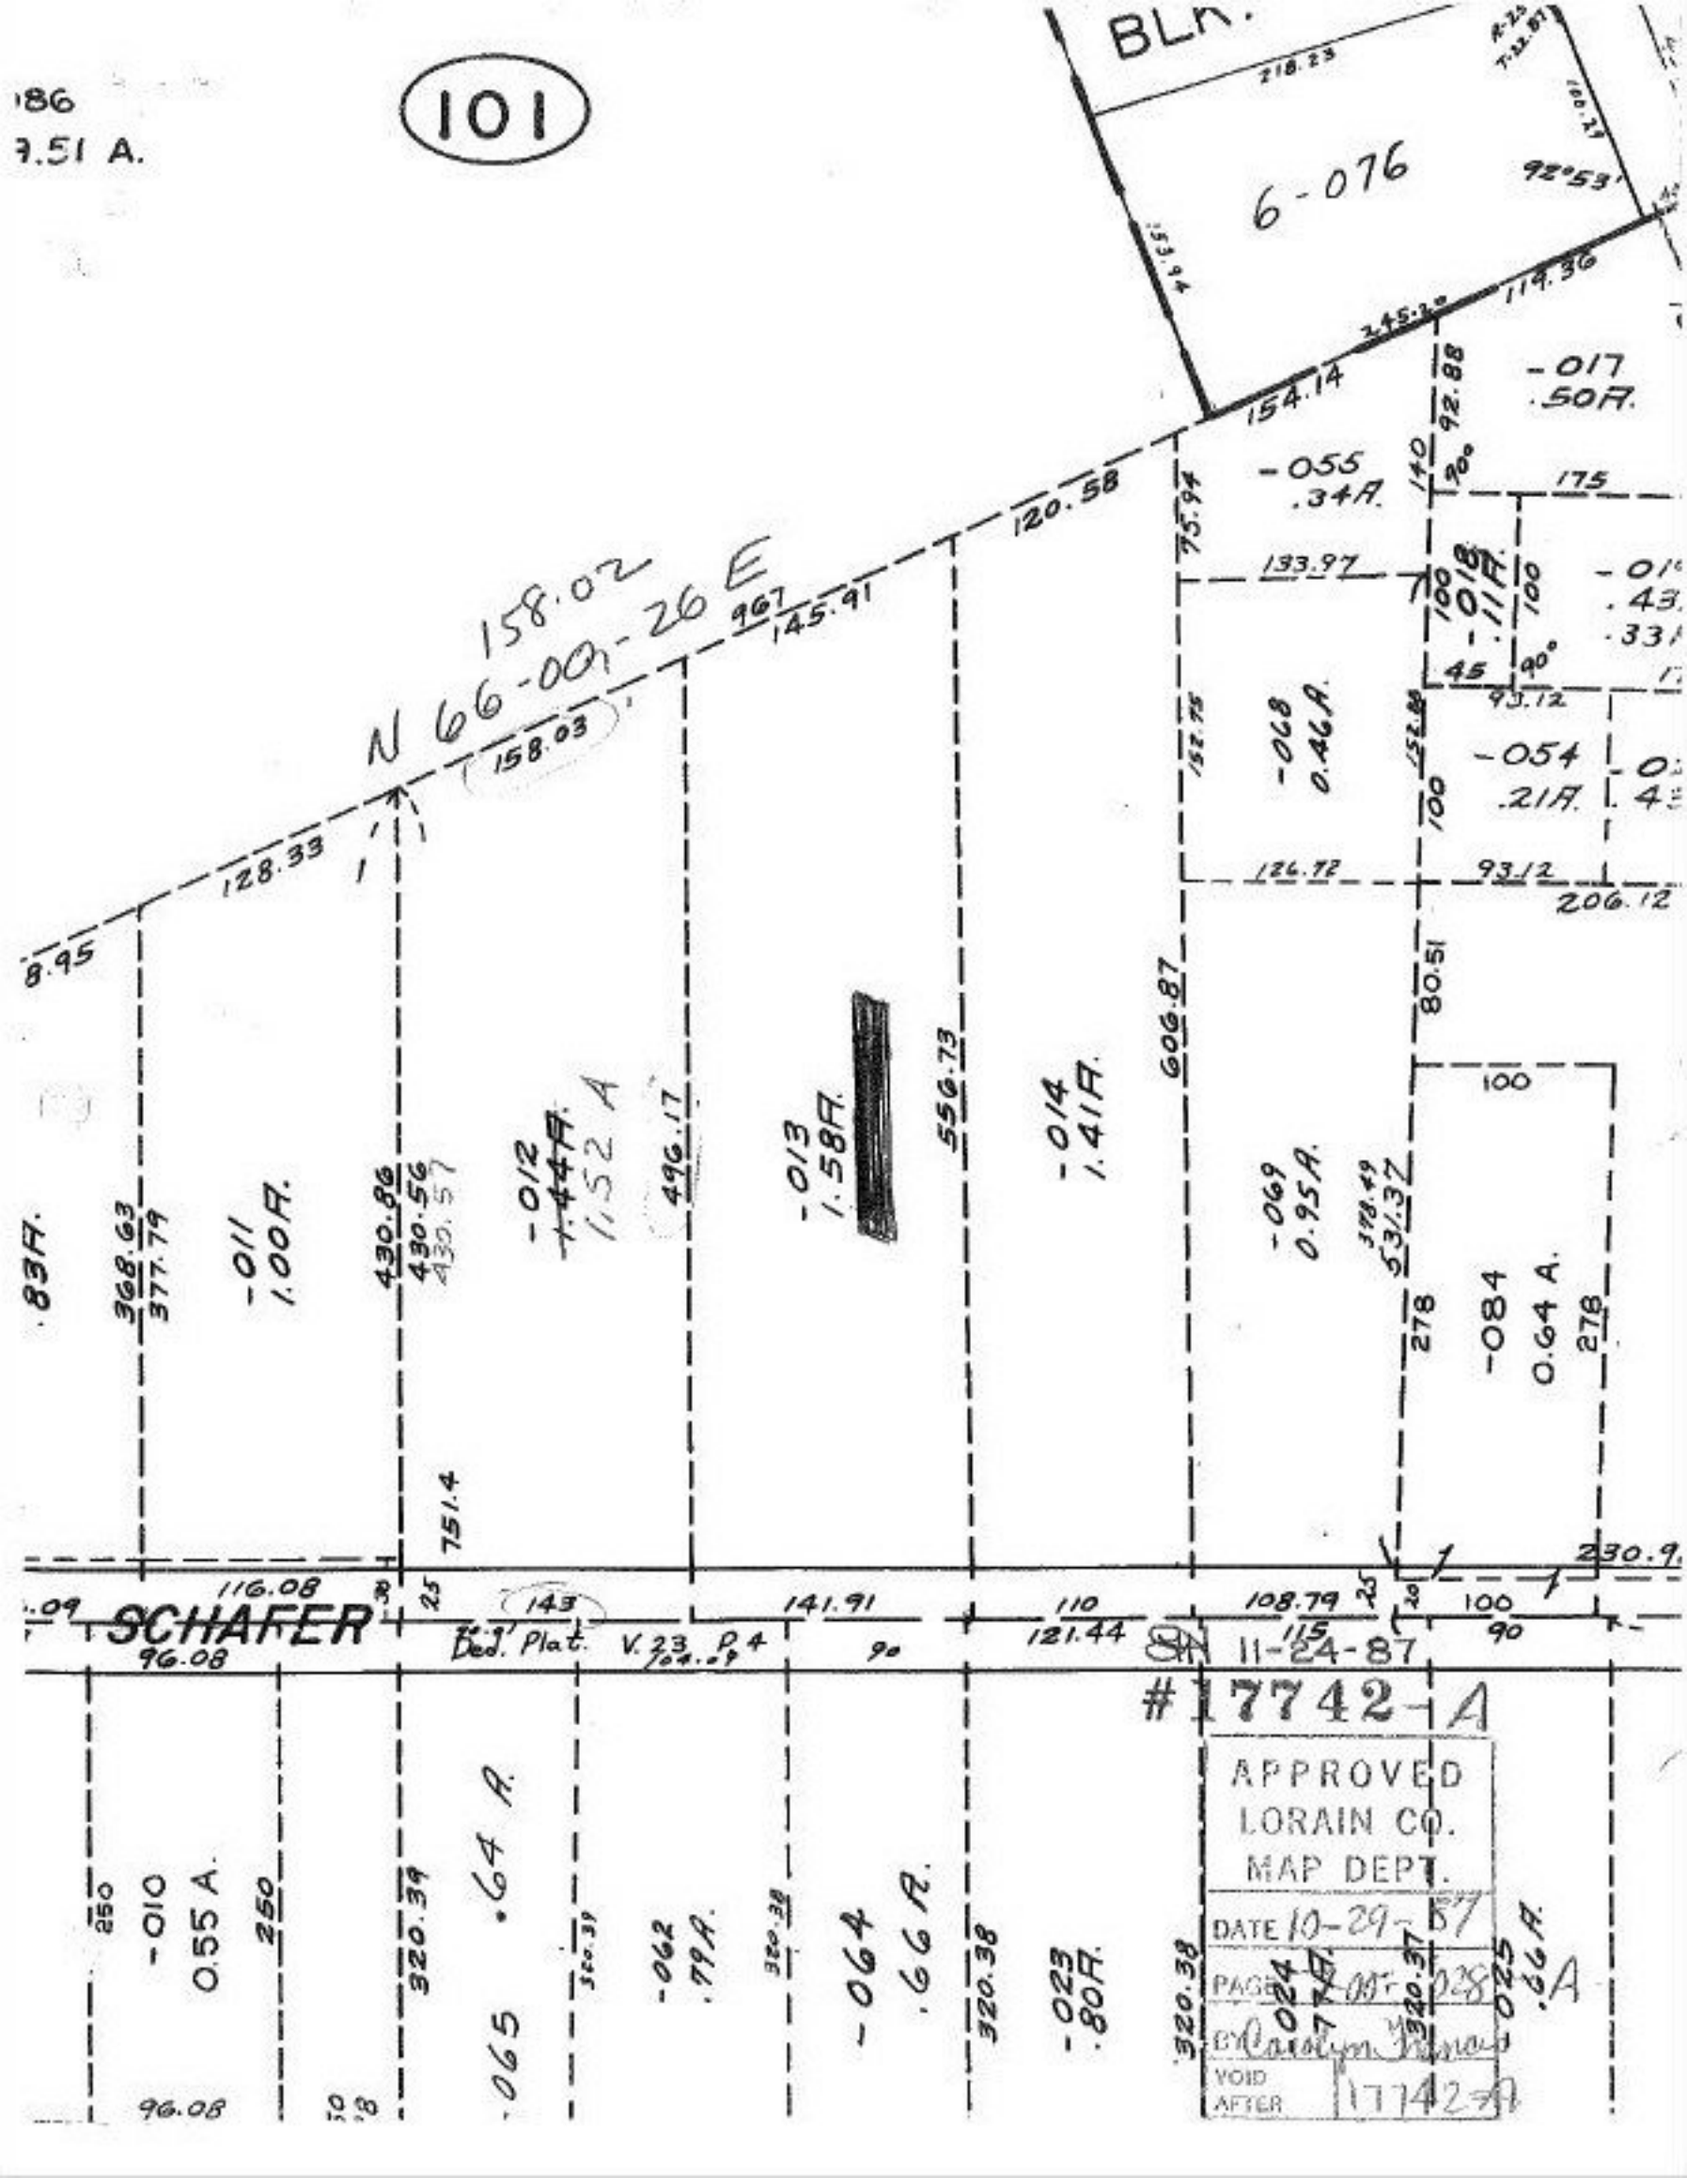
101
BLK.
6-076
N 66-00-26 E
158.02
158.03
145.91
120.58
154.14
114.36
-017
.50A.
-055
.34A.
-018
.11A.
-068
0.46A.
-054
.21A.
-011
1.00A.
-012
1.52A
-013
1.58A.
-014
1.41A.
-069
0.95A.
-084
0.64 A.
SCHAFER
Bed. Plat V. 23 P. 4
11-24-87
#17742-A
APPROVED
LORAIN CO.
MAP DEPT.
DATE 10-29-87
PAGE 005-028
BY Carolyn Yanos
VOID
AFTER 17742-A