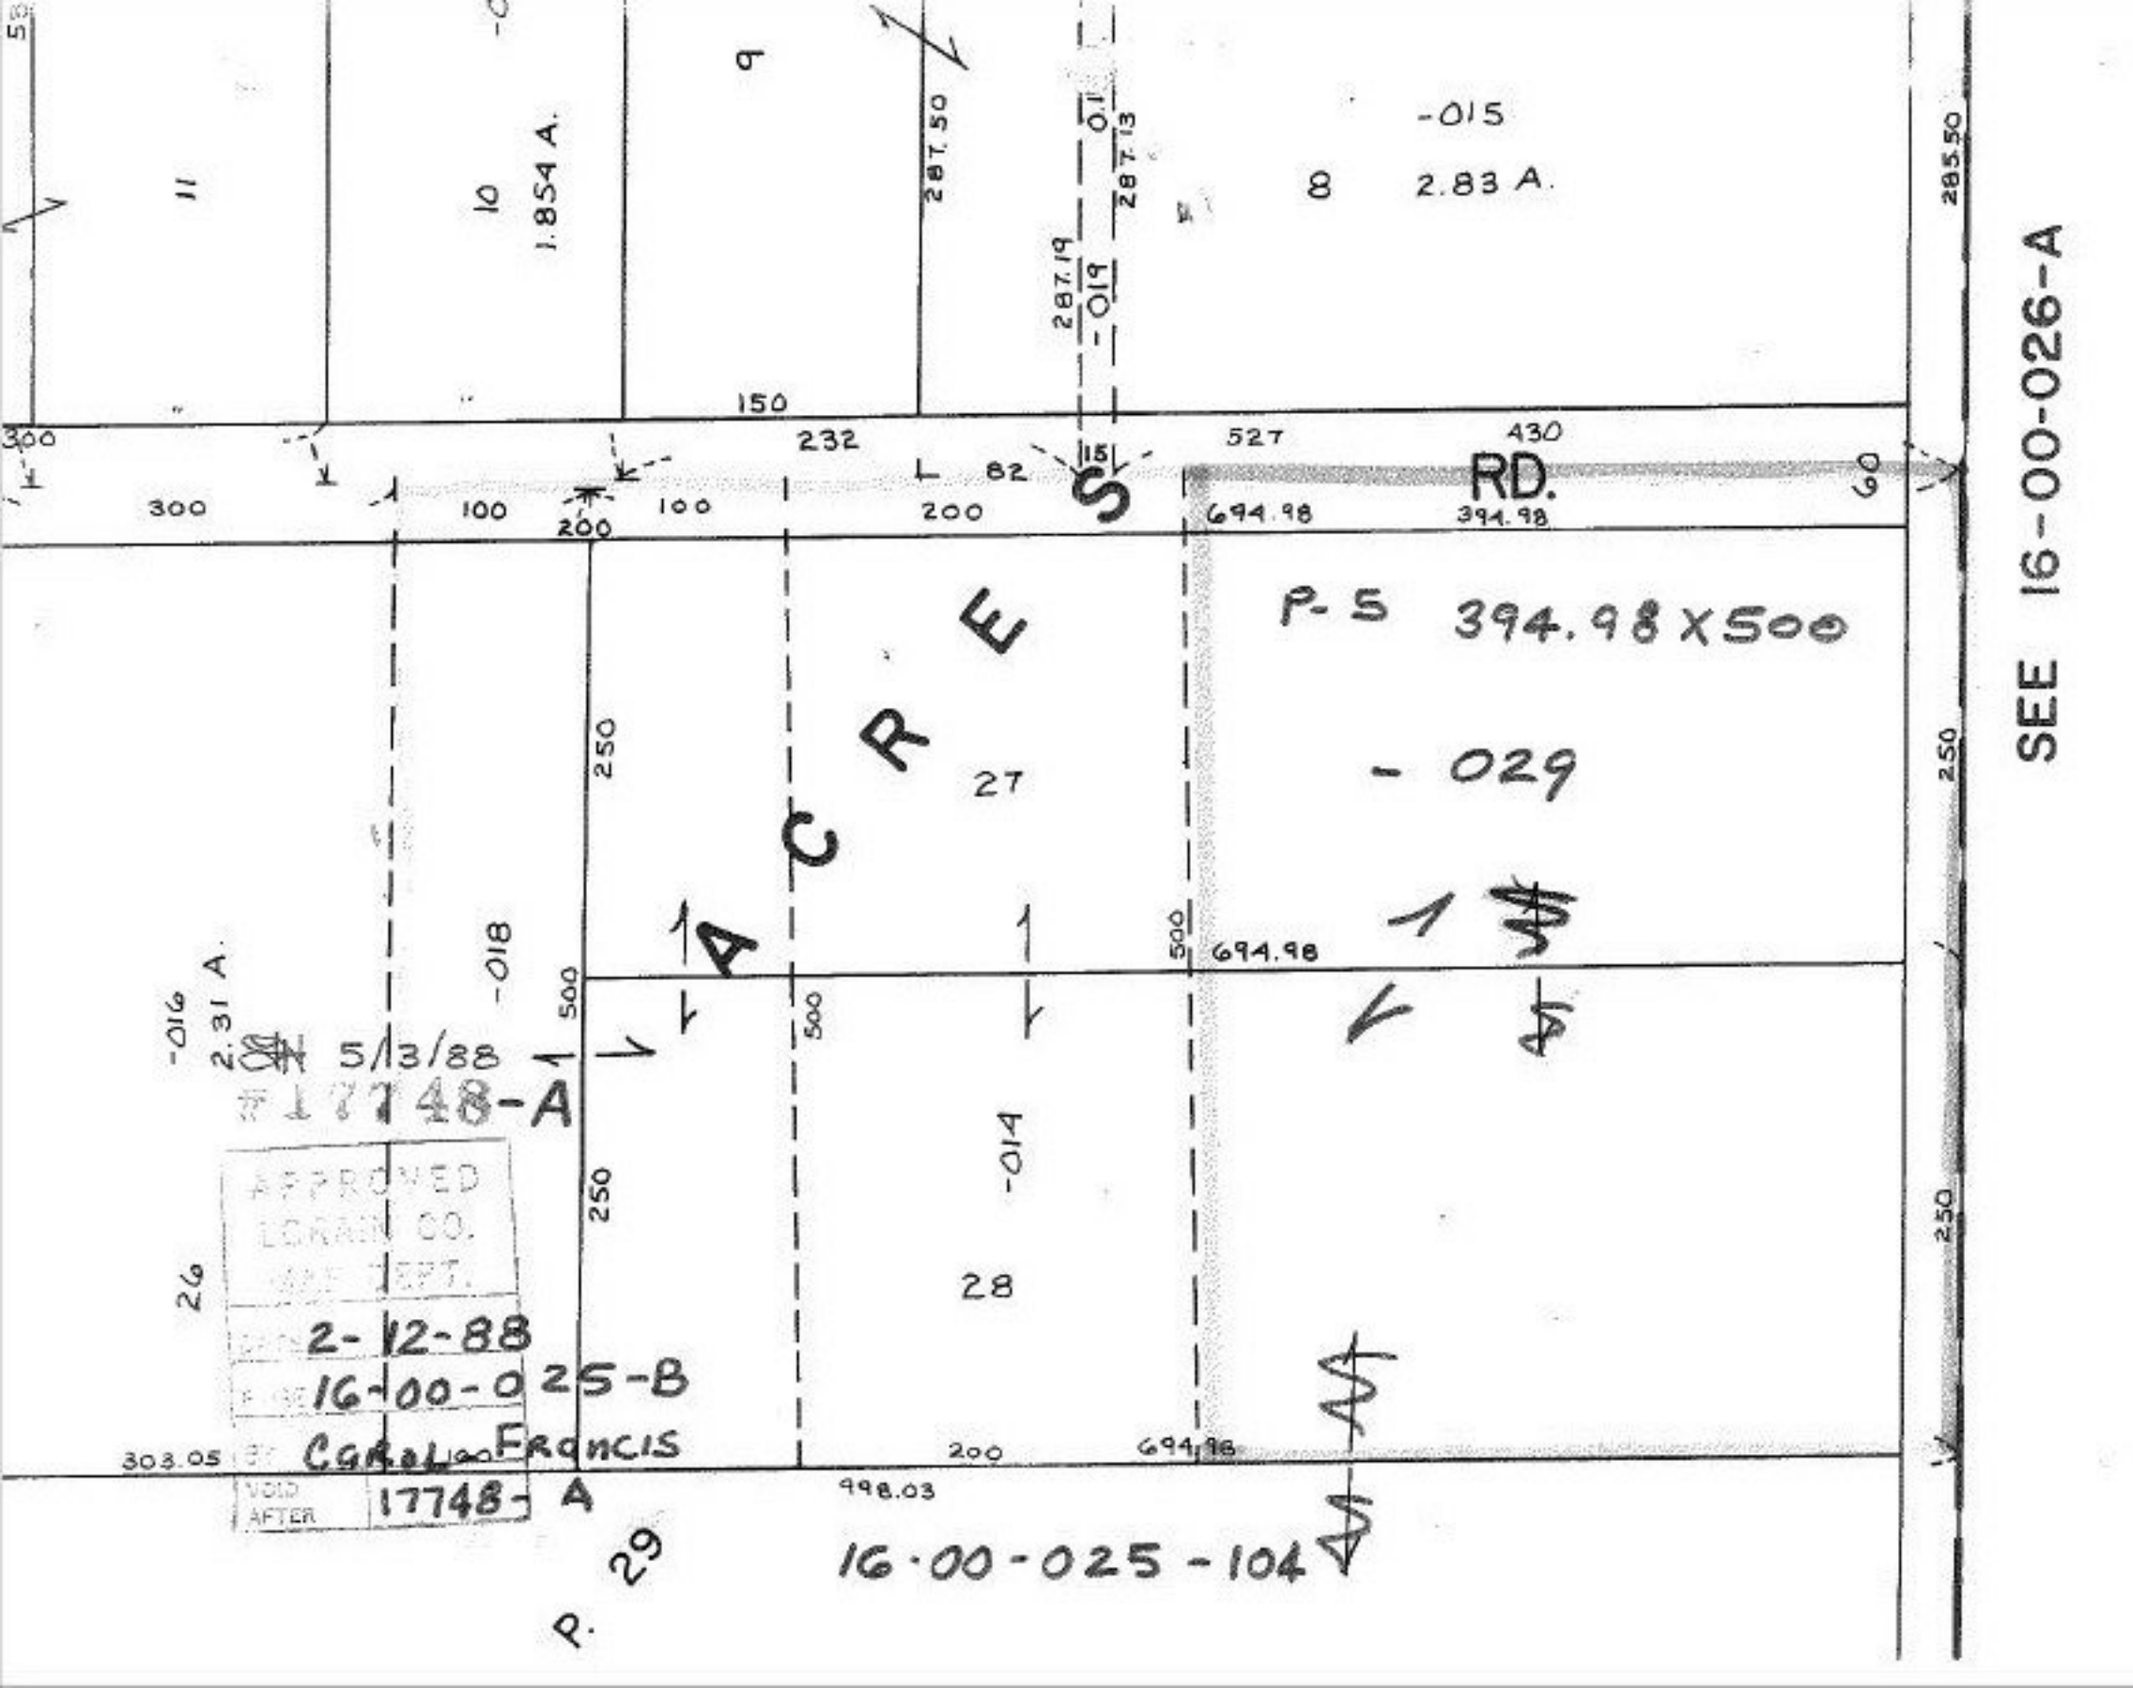
11
10
1.854 A.
9
287.50
287.19
-019
287.13
0.1
-015
8
2.83 A.
285.50
300
150
232
82
15
527
430
RD.
60
300
100
200
100
200
694.98
394.98
P-5 394.98 X 500
-029
1 ACRE
27
250
500
694.98
-018
-016
2.31 A.
5/3/88
#17748-A
APPROVED
LORAIN CO.
ENGR. DEPT.
2-12-88
16-00-025-B
CGR & FRANCIS
VOID AFTER
17748-A
-014
28
26
303.05
200
694.98
998.03
29
P.
16·00-025-104
SEE 16-00-026-A