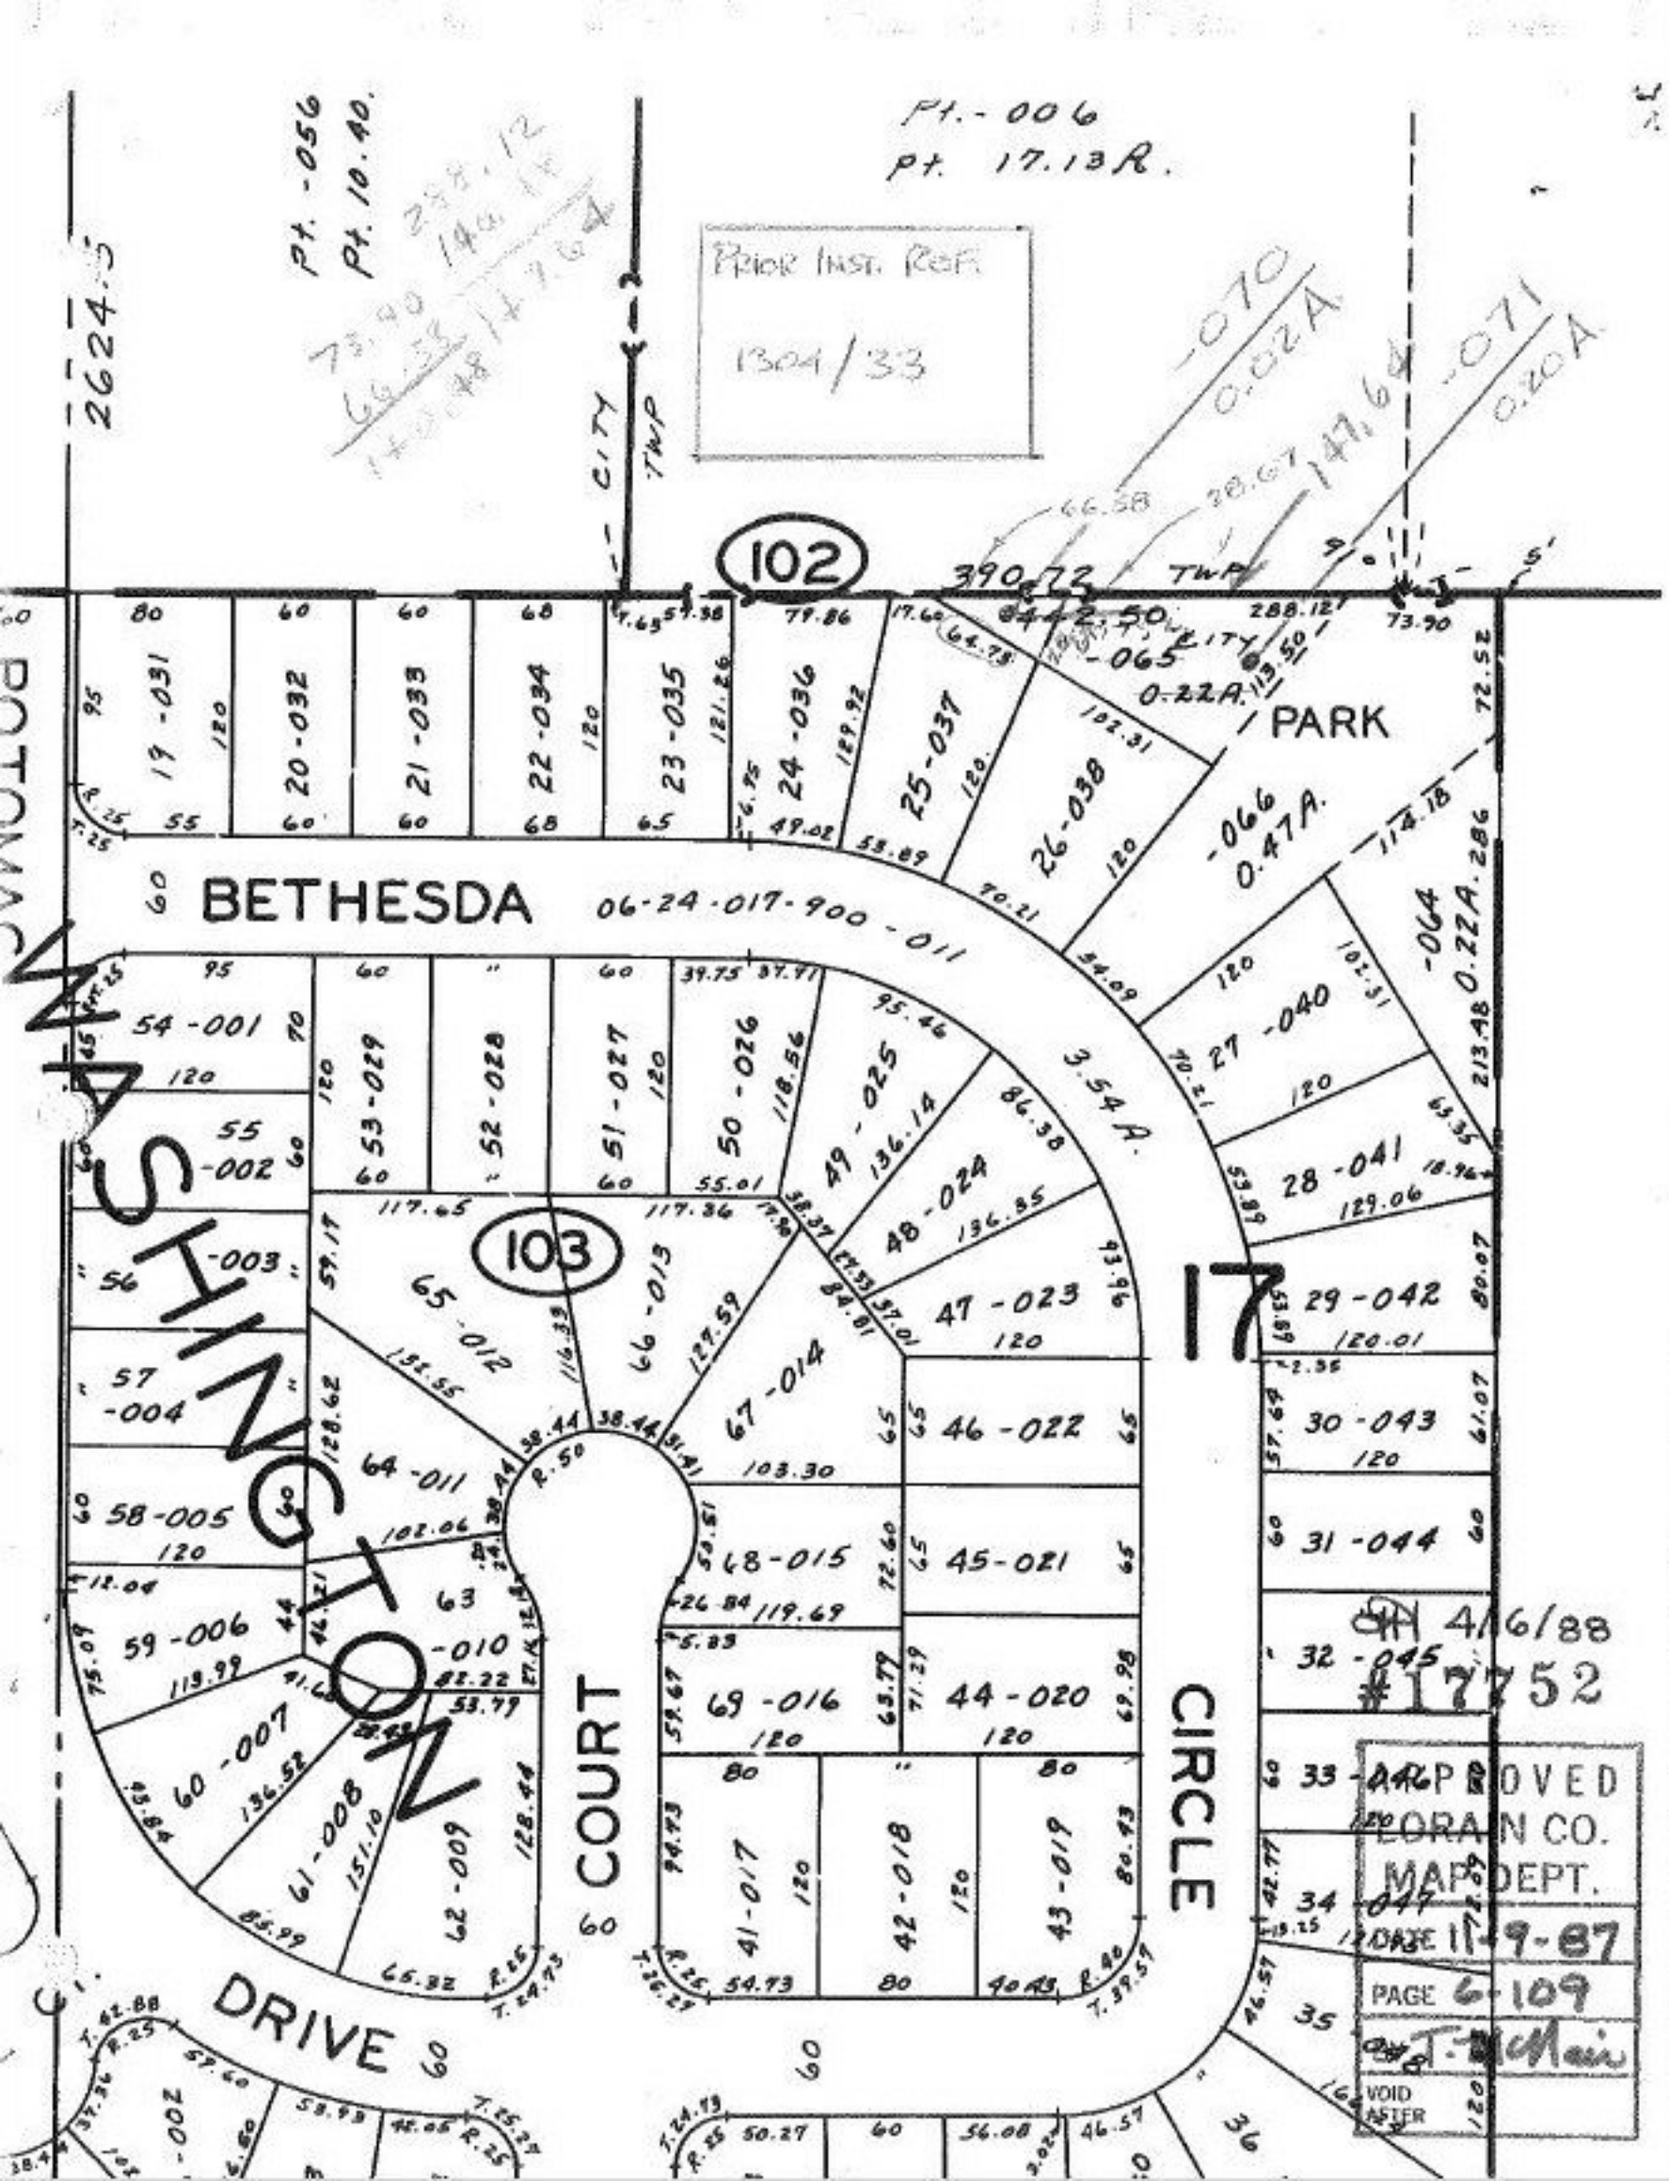
Pt. - 006
Pt. 17.13R.
Pt. - 056
Pt. 10.40.
2624.3
PRIOR INST. REF.
1304/33
CITY
TWP
-070
0.02A
-071
0.20A
102
390.72
442.50
-065
0.22A.
PARK
-066
0.47A.
-064
0.22A.
BETHESDA
06-24-017-900-011
3.54 A.
WASHINGTON
COURT
CIRCLE
DRIVE
103
17
54-001
55-002
56-003
57-004
58-005
59-006
60-007
61-008
62-009
63-010
64-011
65-012
66-013
67-014
68-015
69-016
41-017
42-018
43-019
44-020
45-021
46-022
47-023
48-024
49-025
50-026
51-027
52-028
53-029
19-031
20-032
21-033
22-034
23-035
24-036
25-037
26-038
27-040
28-041
29-042
30-043
31-044
32-045
33-046
34-047
35
36
4/6/88
#17752
APPROVED
LORAIN CO.
MAP DEPT.
DATE 11-9-87
PAGE 6-109
VOID AFTER