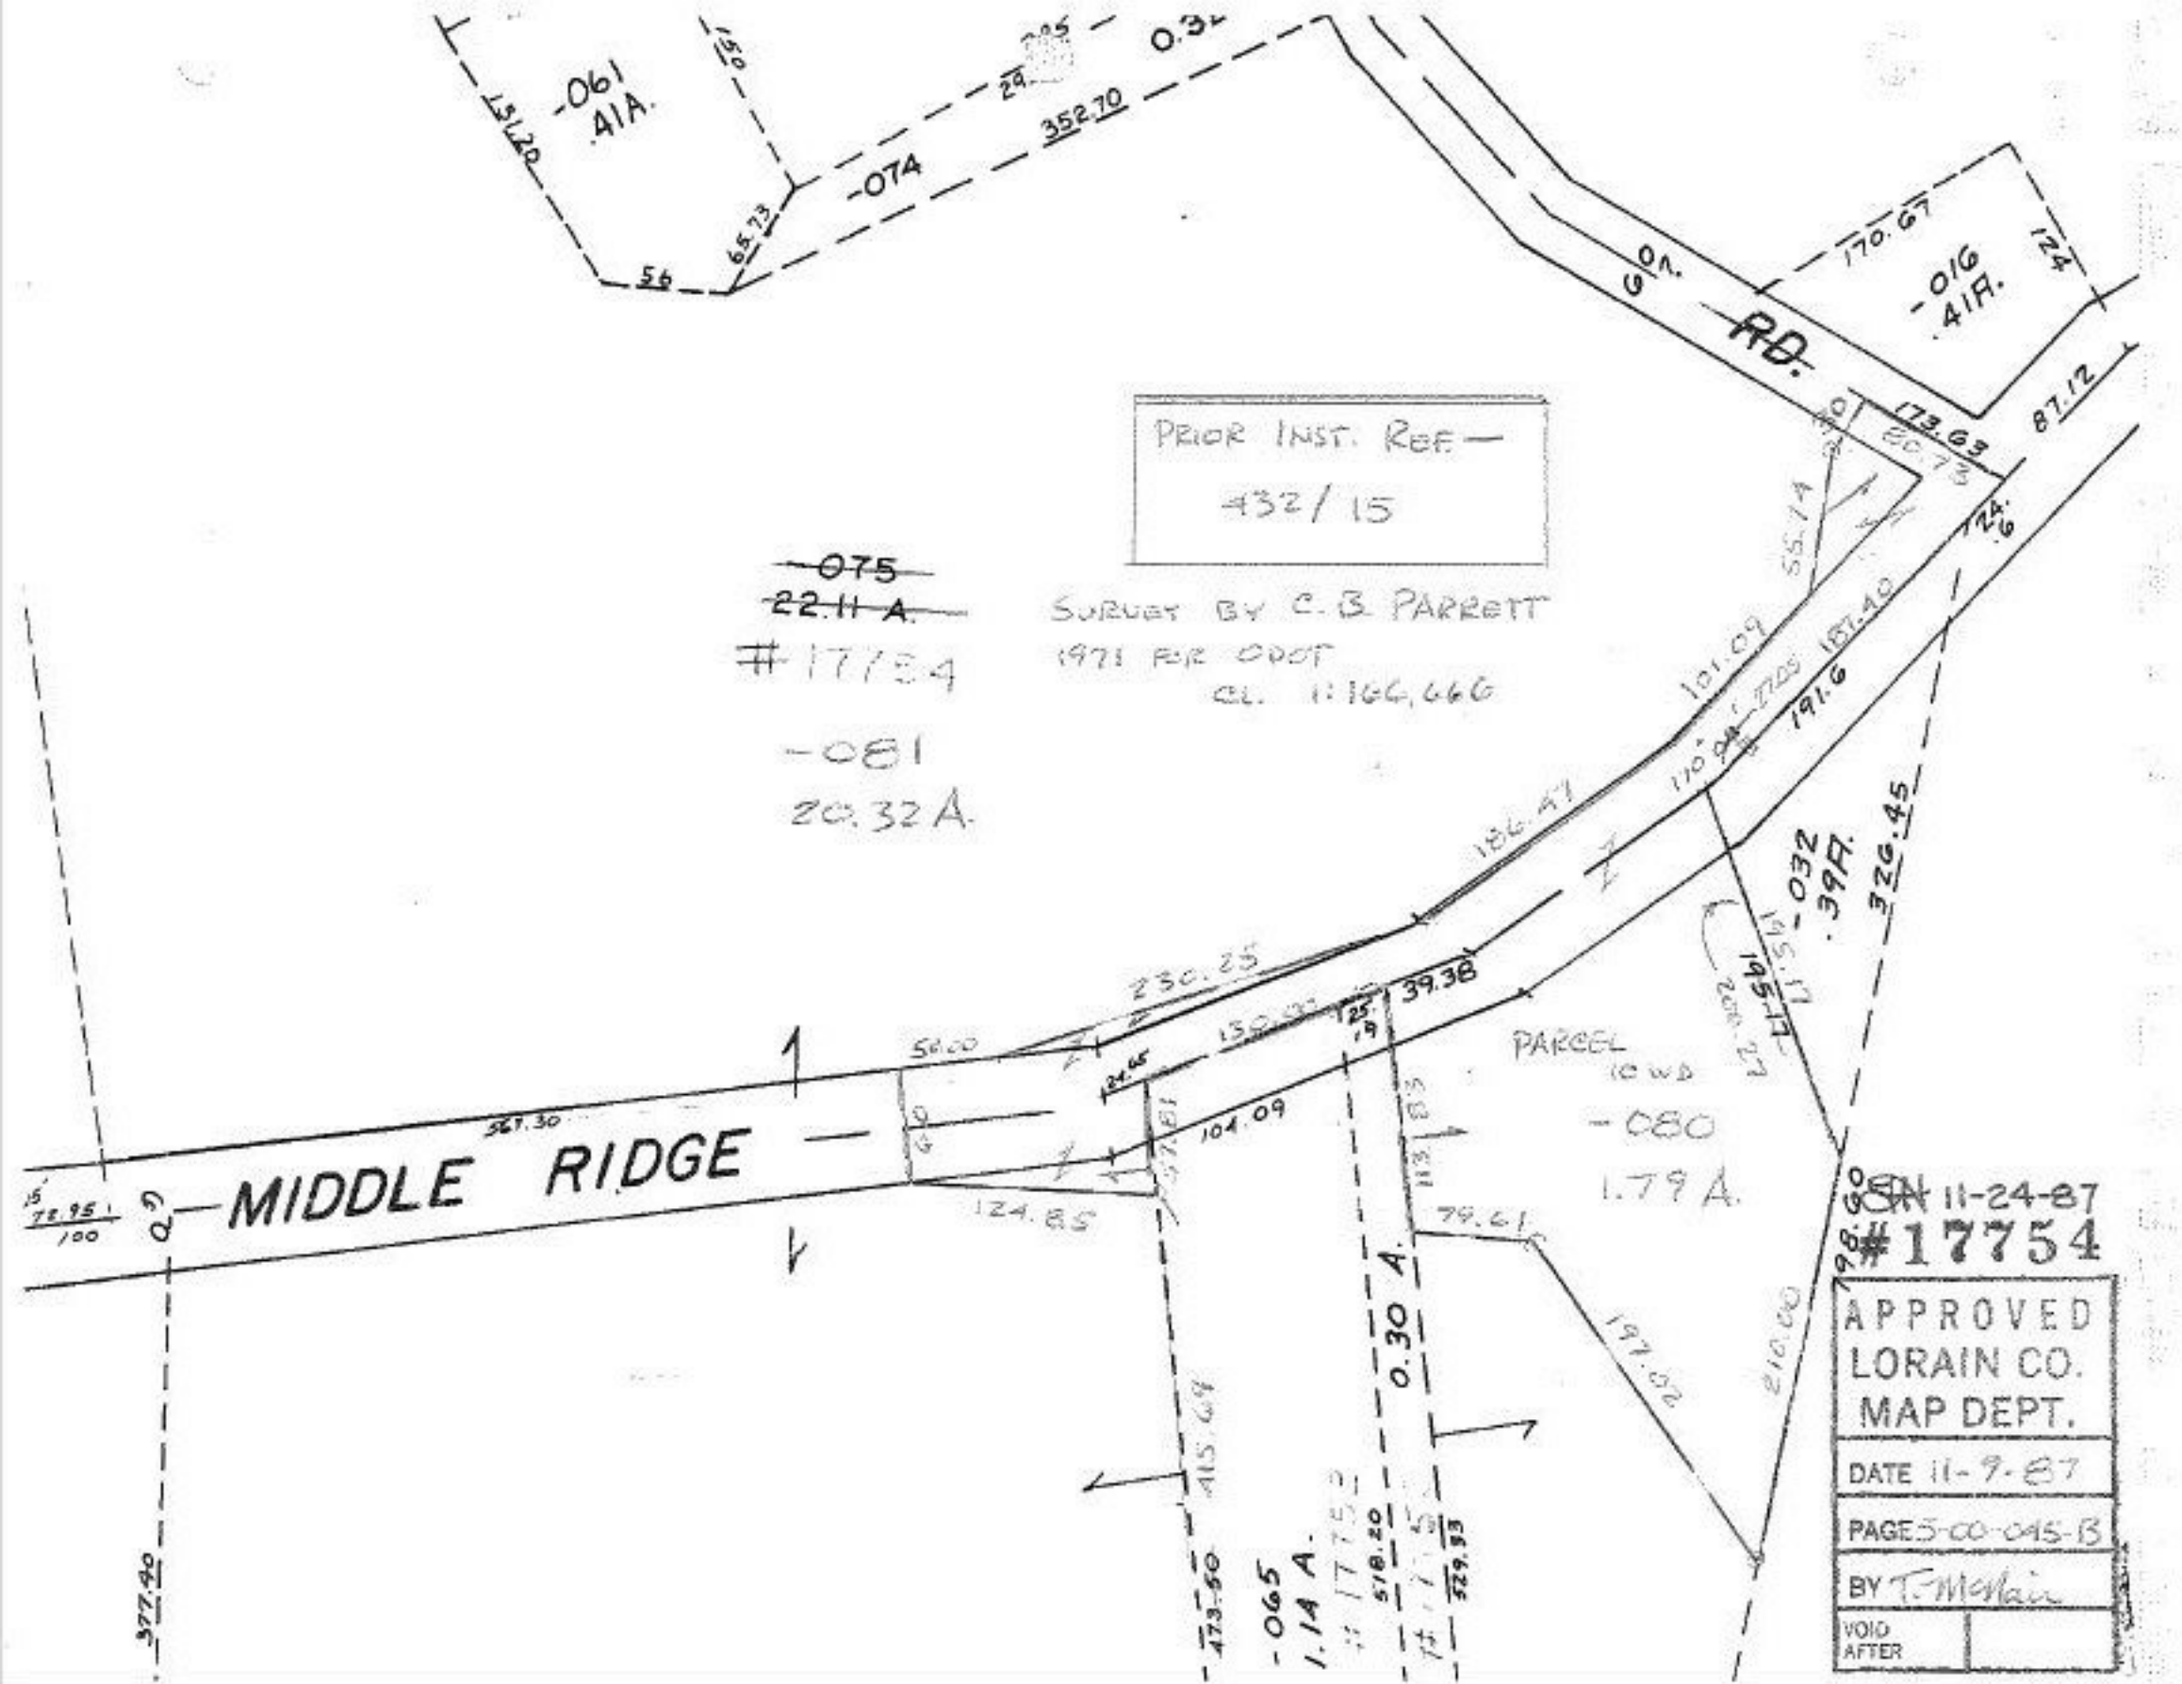

PRIOR INST. REF —
432/15
~~-075~~
~~22.11 A.~~
#17754
-081
20.32 A.
SURVEY BY C. B. PARRETT
1971 FOR ODOT
CL. 1:166,666
-061
.41A.
-074
352.70
-016
.41A.
170.67
RD.
173.63
87.12
101.09
187.40
191.6
186.47
230.25
39.38
104.09
124.85
79.61
197.02
210.00
-032
.39A.
326.45
PARCEL
10 WD
-080
1.79 A.
MIDDLE RIDGE
0.30 A.
-065
1.14 A.
377.40
415.69
518.20
529.33
SN 11-24-87
#17754
APPROVED
LORAIN CO.
MAP DEPT.
DATE 11-9-87
PAGE 5-00-045-B
BY T. McNair
VOID
AFTER