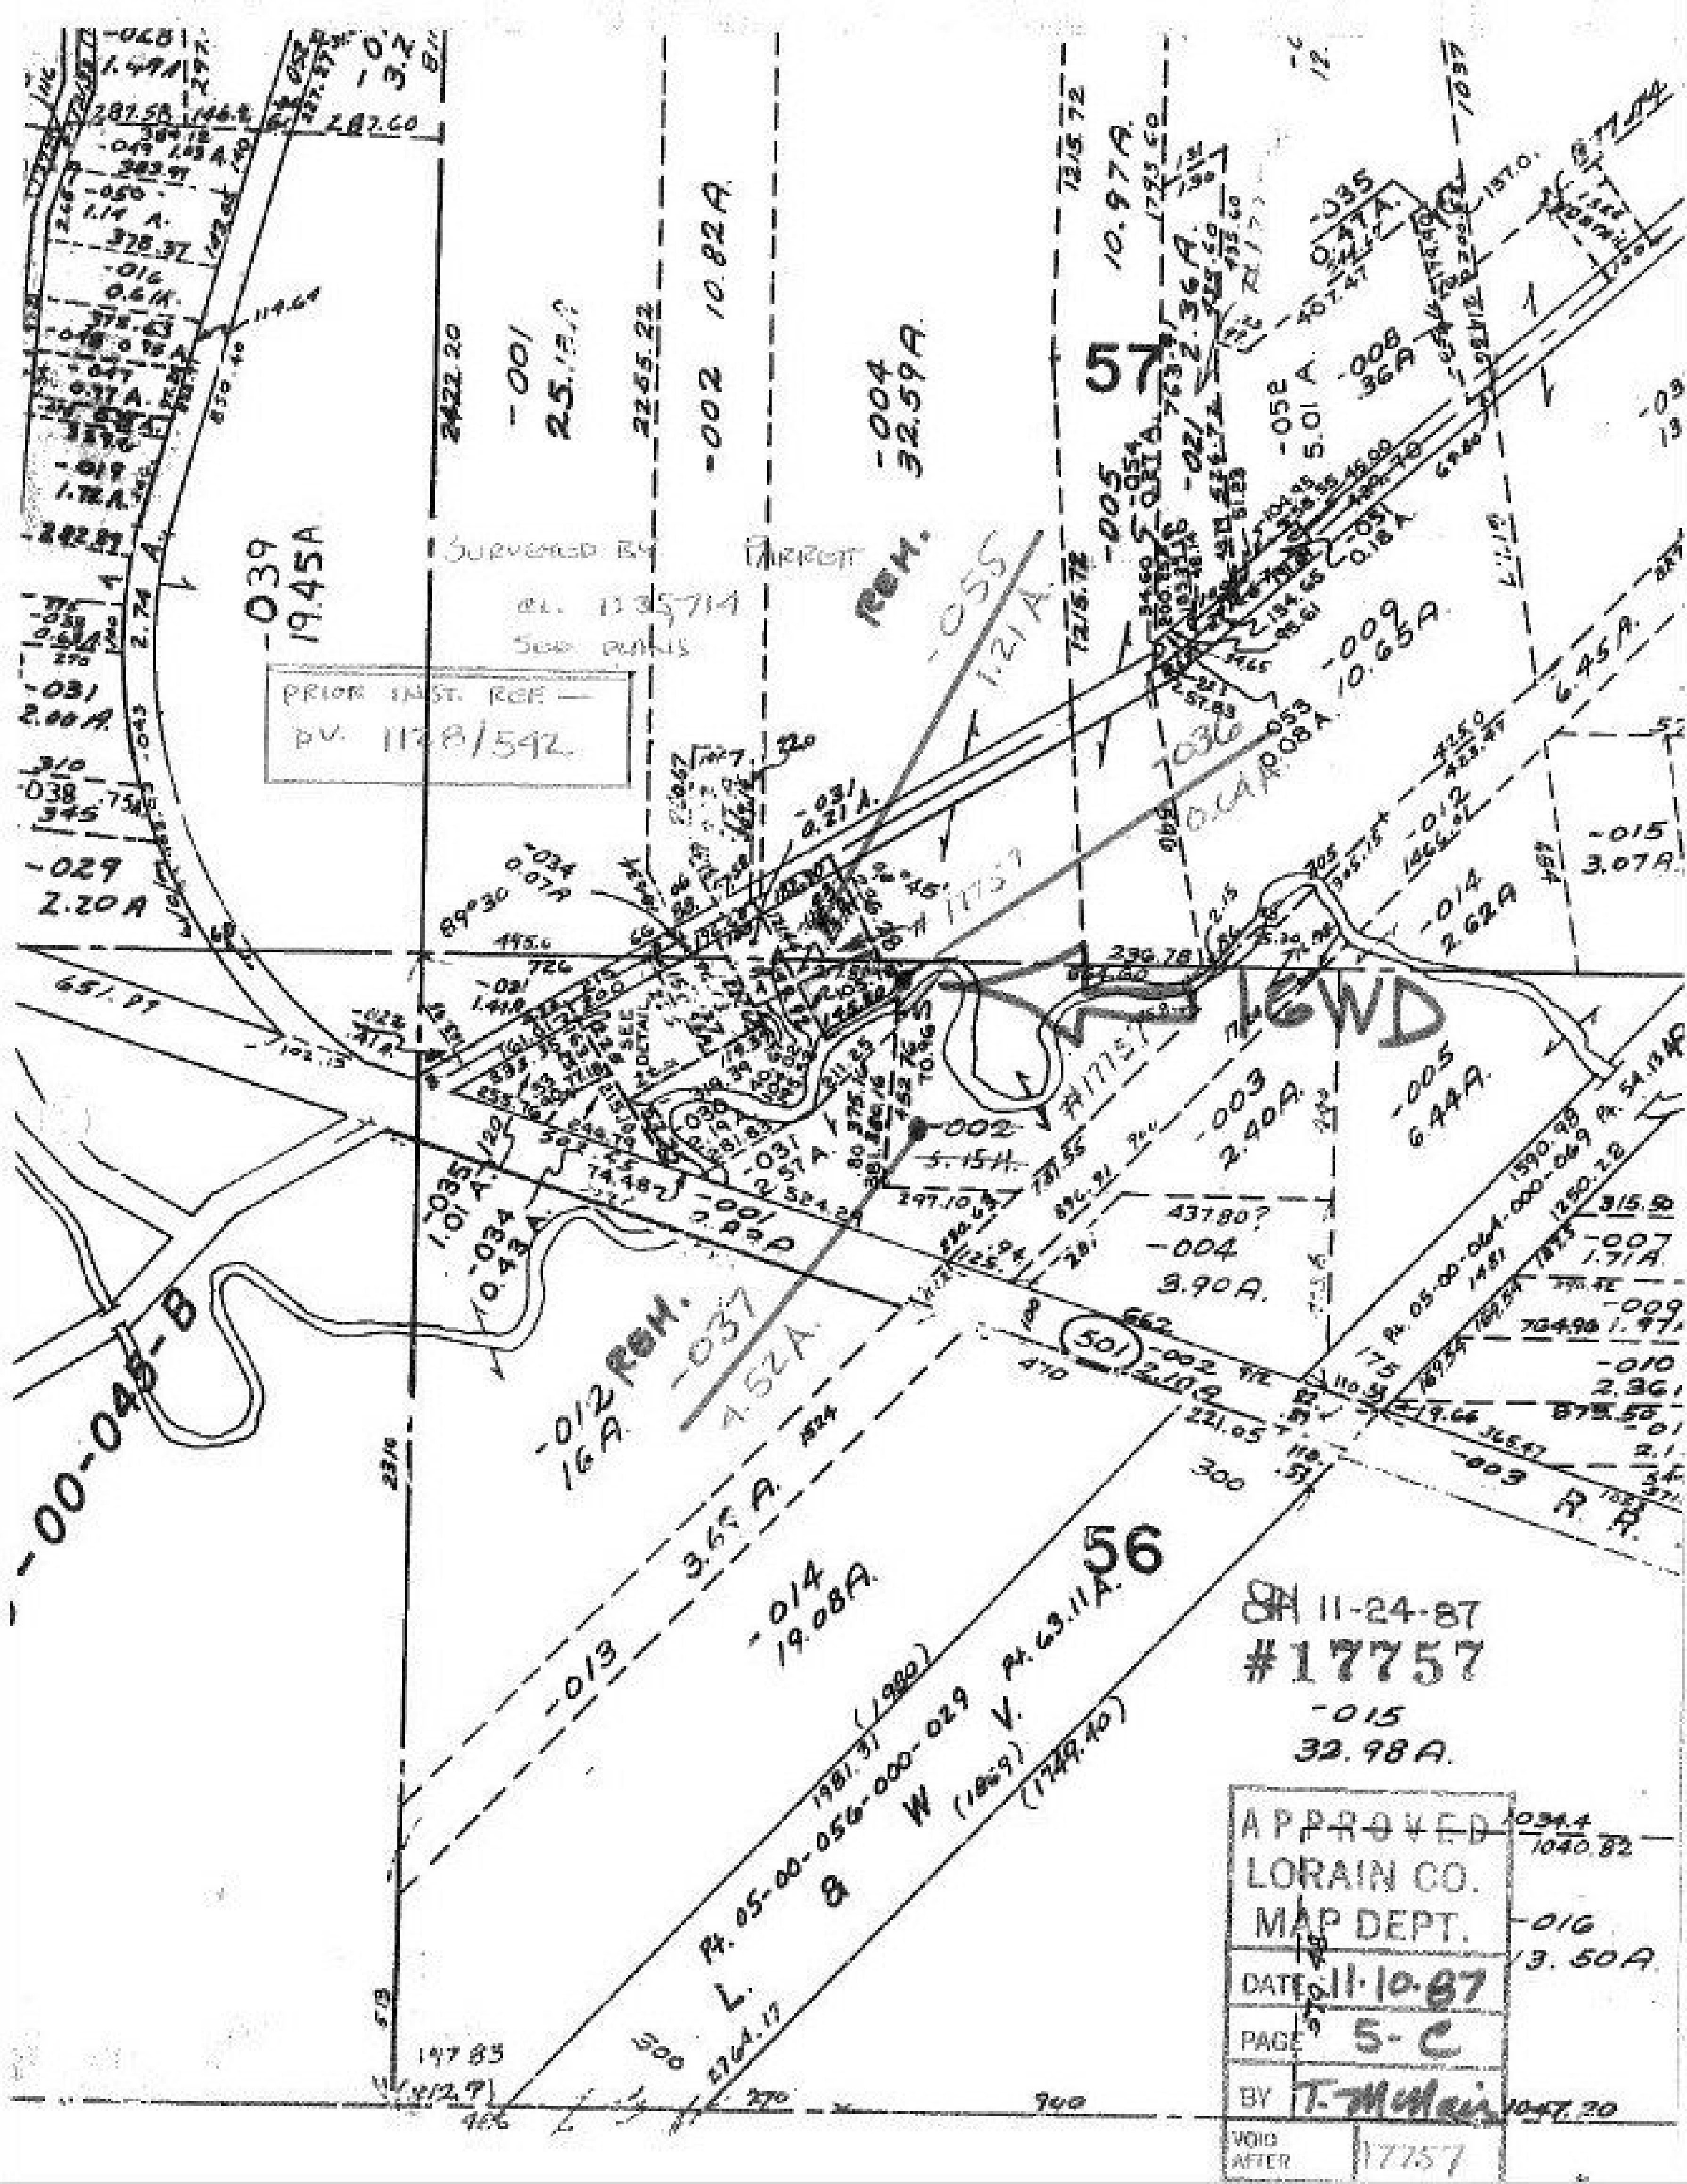

57
56
-039
19.45A
-001
25.12.?
-002
10.82A
-004
32.59A
10.97A.
SURVEYED BY PARROT
VL. 1135714
SEE PLANS
PRIOR INST. REF —
DV. 1128/592
-055
1.21 A.
REM.
-037
4.52A.
-012 REM.
16A.
-009
10.65A.
6.45A.
-015
3.07A.
-014
2.62A
-003
2.40A.
-005
6.44A.
-004
3.90A.
-002
5.15A.
-029
2.20A
-031
2.00A.
-013
3.65A.
-014
19.08A.
-035
1.01A.
-034
0.43A.
-001
2.89A
-031
2.57A
-00-045-B
16WD
501
#17757
L. & W. V.
R. R.
Pt. 05-00-056-000-029
Pt. 63.11A.
Pt. 05-00-064-000-069
8H 11-24-87
#17757
-015
32.98A.
-016
13.50A.
APPROVED
LORAIN CO.
MAP DEPT.
DATE 11-10-87
PAGE 5-C
BY T. McMain
VOID AFTER 17757