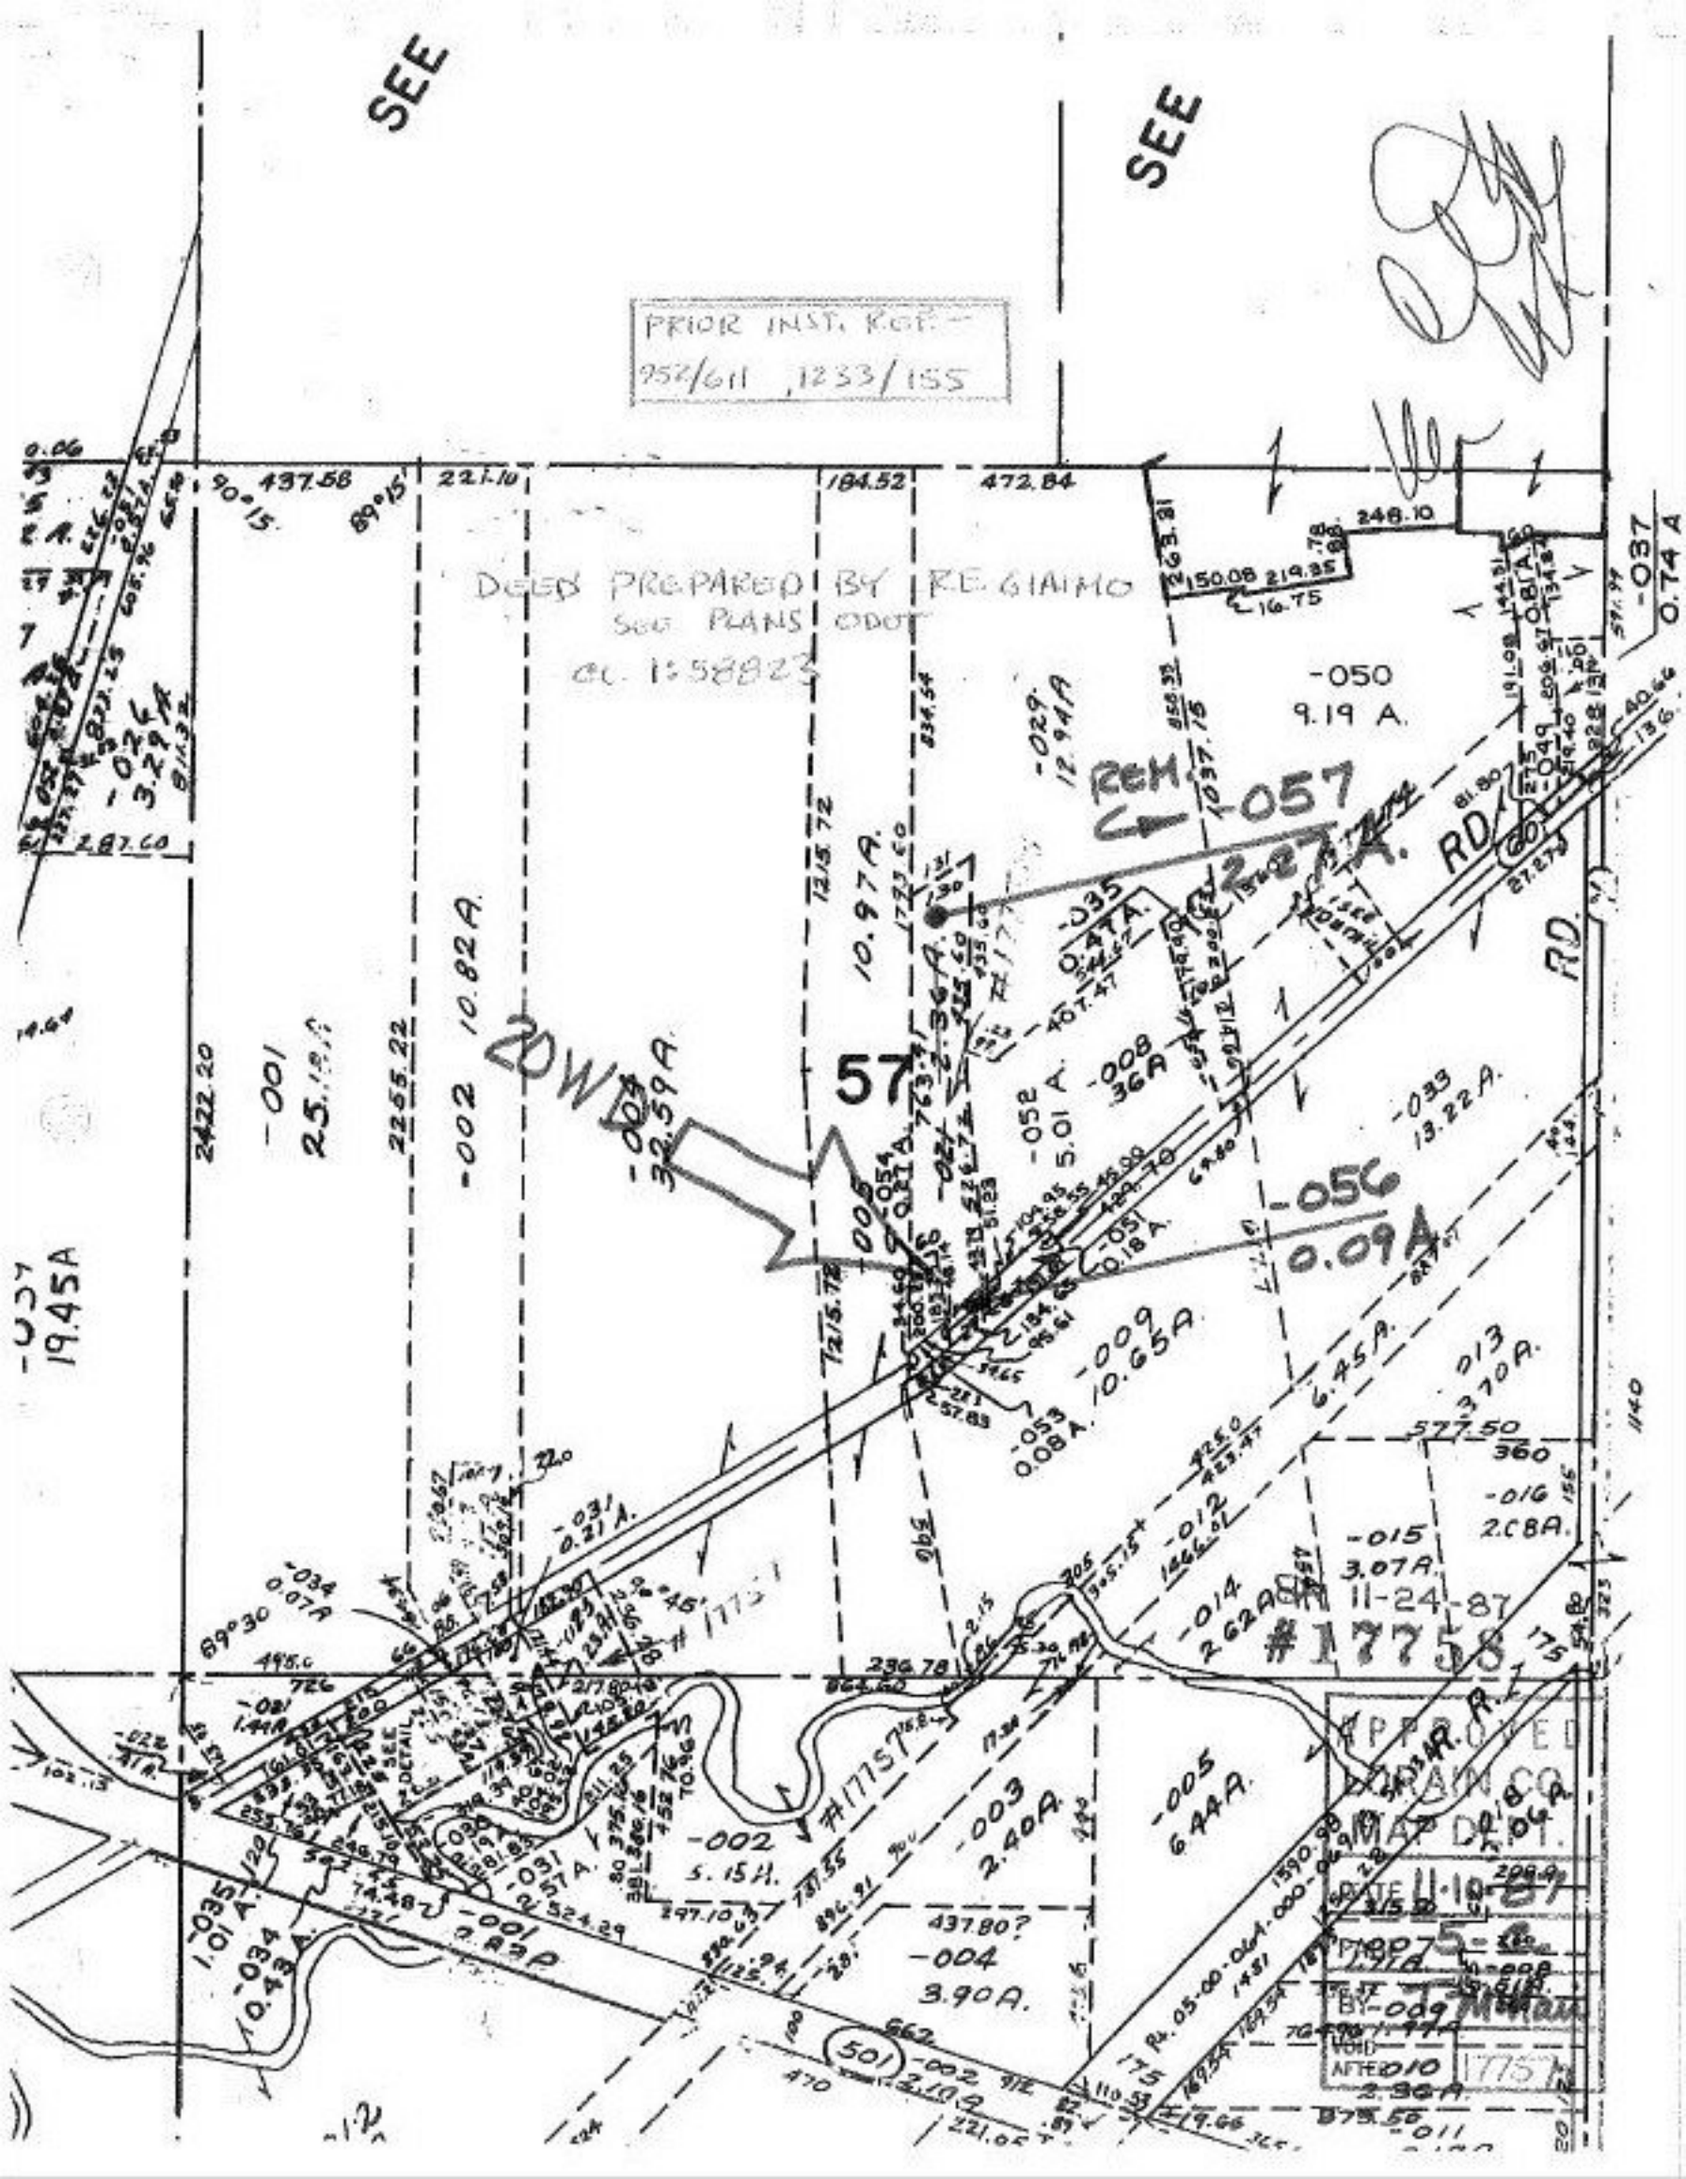
SEE
SEE
PRIOR INST. REF:
952/611, 1233/155
DEED PREPARED BY R.E. GIAIMO
SEE PLANS ODOT
dd. 1:58823
-050
9.19 A.
-057
2.27A.
REM.
RD.
-026
3.29A
-001
25.19A
-002 10.82A.
ROW
-003
32.39A.
57
-035
0.47A.
-052
5.01 A.
-008
36A
-033
13.22A.
-056
0.09A
-009
10.65A
-053
0.08A.
-037
19.45A
-031
0.21A.
-034
0.07A
-012
-015
3.07A.
-014
2.62A
-016
2.08A.
11-24-87
#17758
-002
5.15A.
-003
2.40A.
-005
6.44A.
-004
3.90A.
-001
2.83A
-034
0.43A.
-035
1.01A.
APPROVED
DAM CO
MAP DEPT.
DATE 11-18-87
BY-009
VOID
AFTER 10
#17757