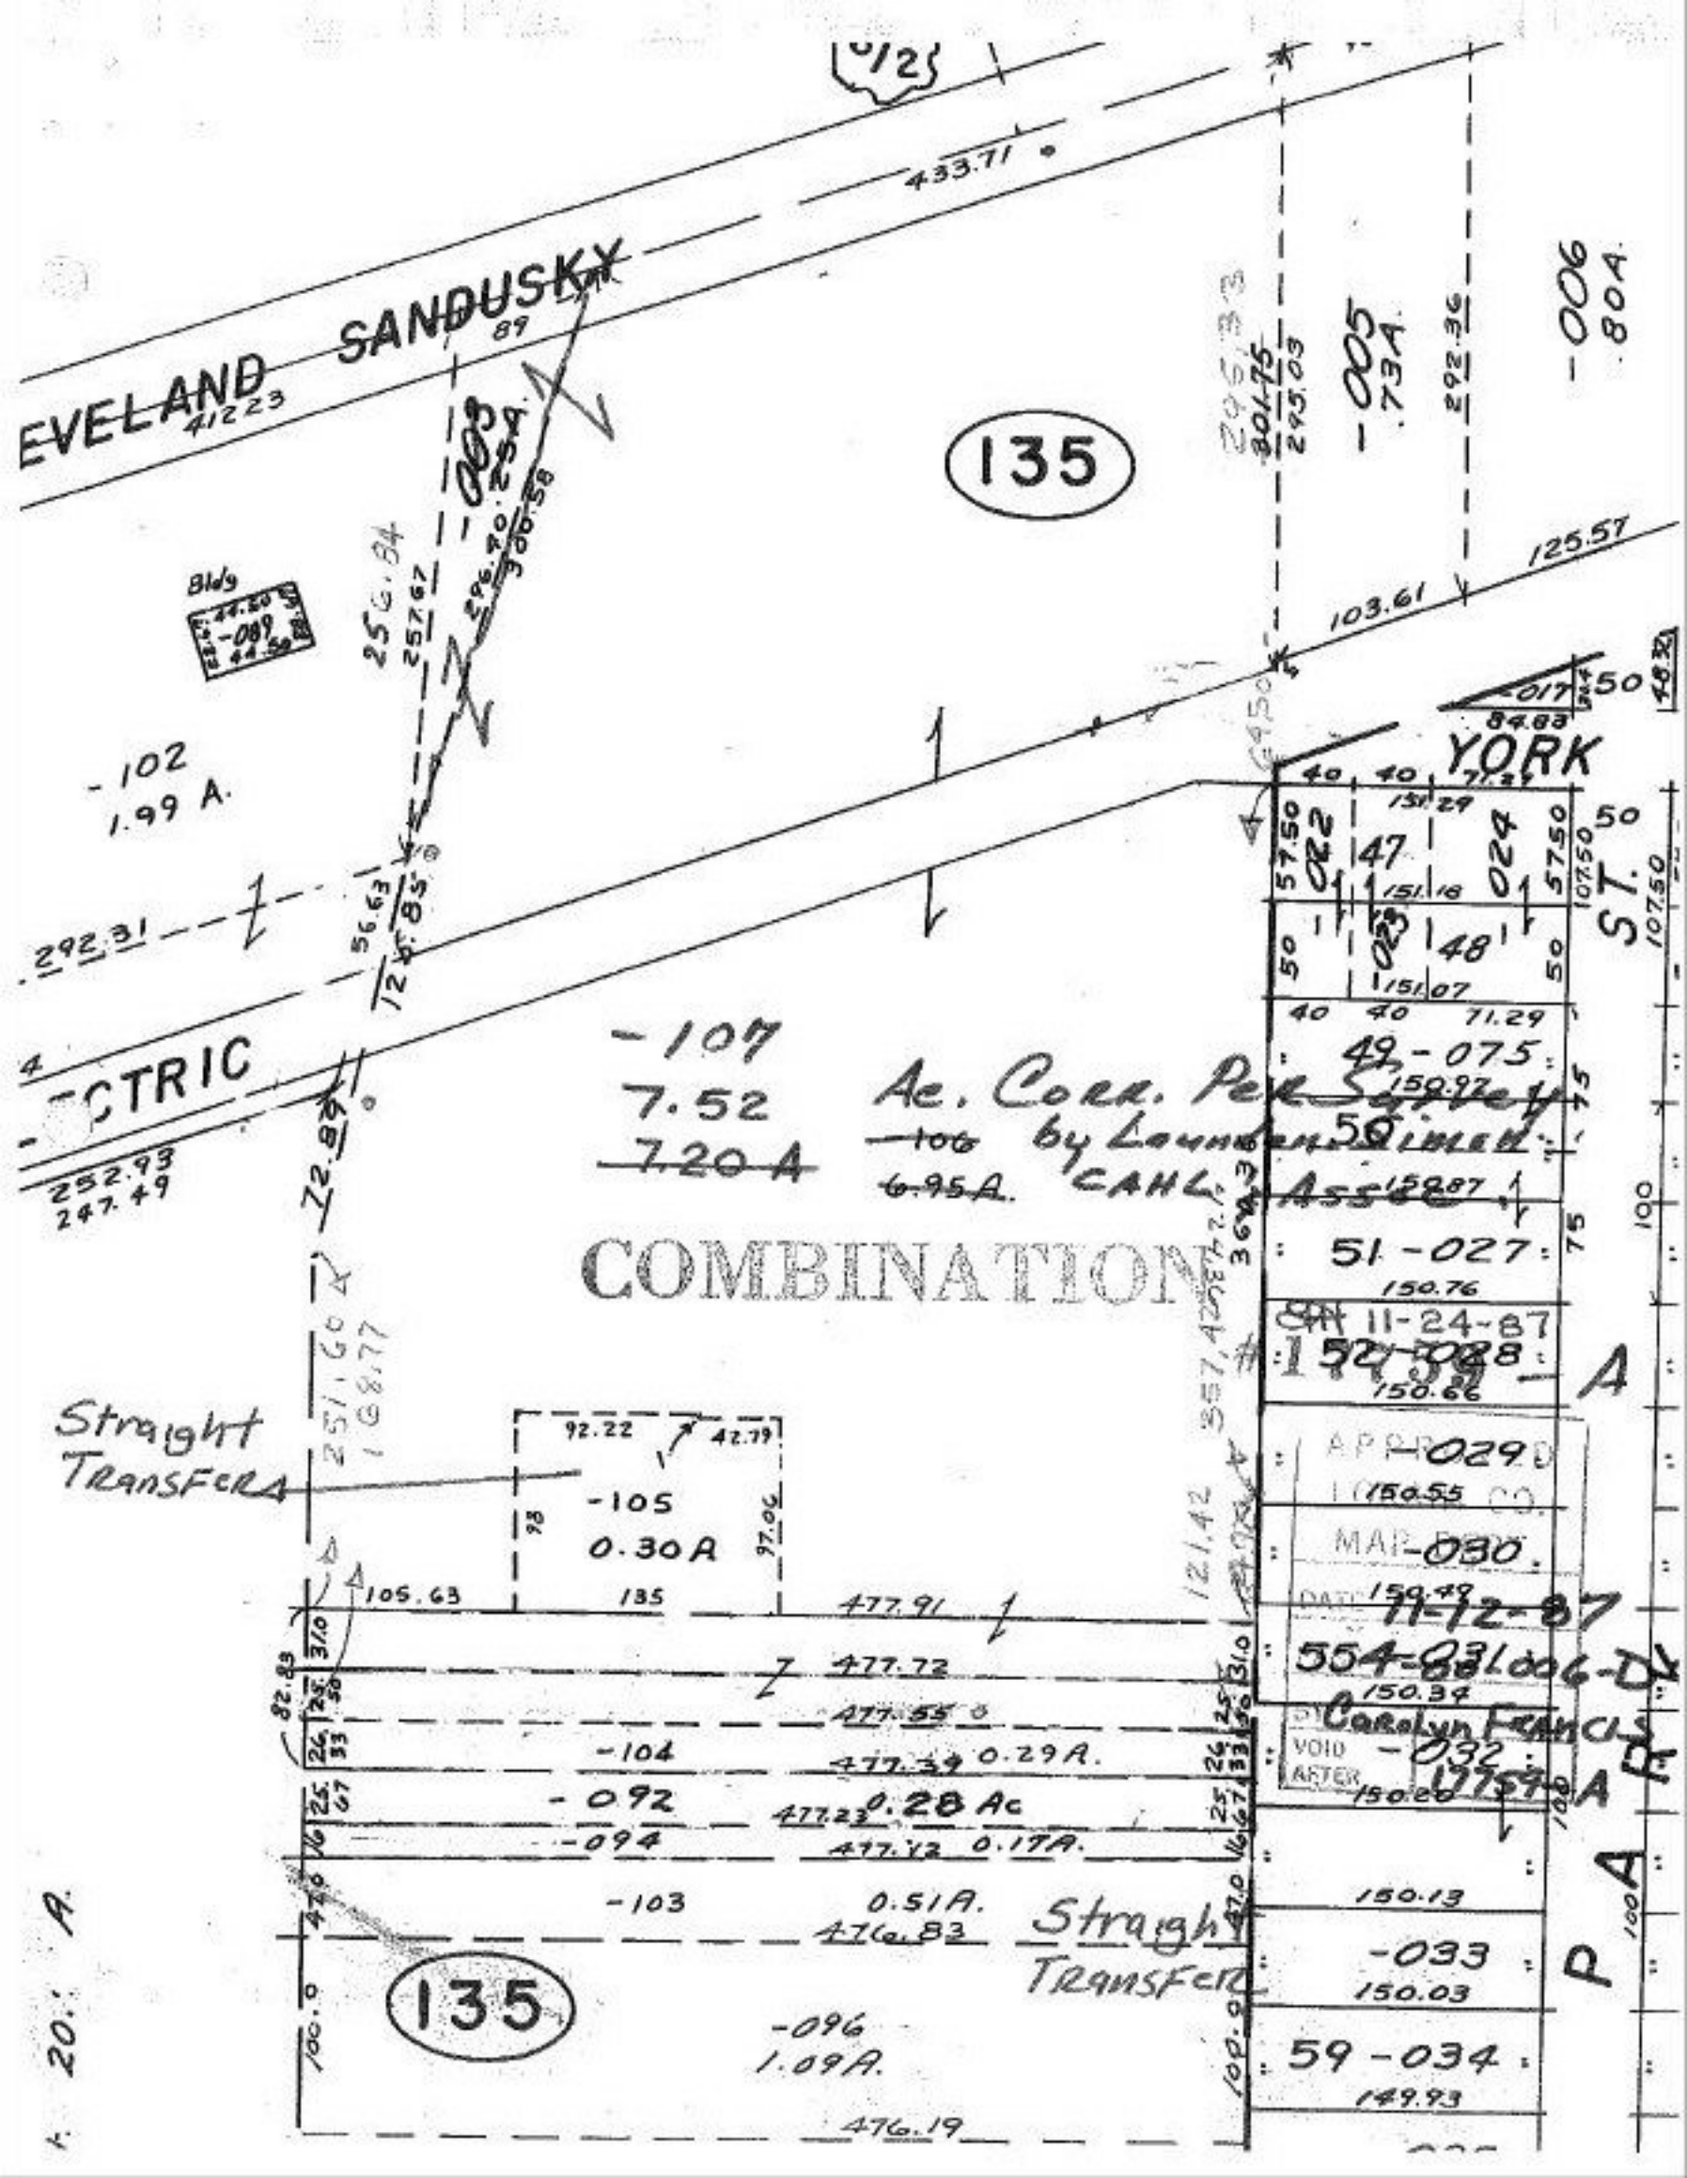
EVELAND SANDUSKY
41223
433.71
135
-003
2.54 A.
-005
.734
-006
.804
-102
1.99 A.
-107
7.52
7.20 A
Ac. Corr. Per Survey
-106
6.95 A.
by Lawndale Linen
COMBINATION
Straight Transfer
-105
0.30 A
-104
0.29 A.
-092
0.28 Ac
-094
0.17 A.
-103
0.51 A.
-096
1.09 A.
135
YORK ST.
47
48
49-075
51-027
11-24-87
52-028
029
030
11-12-87
554-88006-D
Carolyn Francis
-032
-033
59-034
Straight Transfer
476.19
476.82
477.91
477.72
477.55
477.34
477.23
477.12
121.42
357,423 Sq. Ft.
8.20 A.