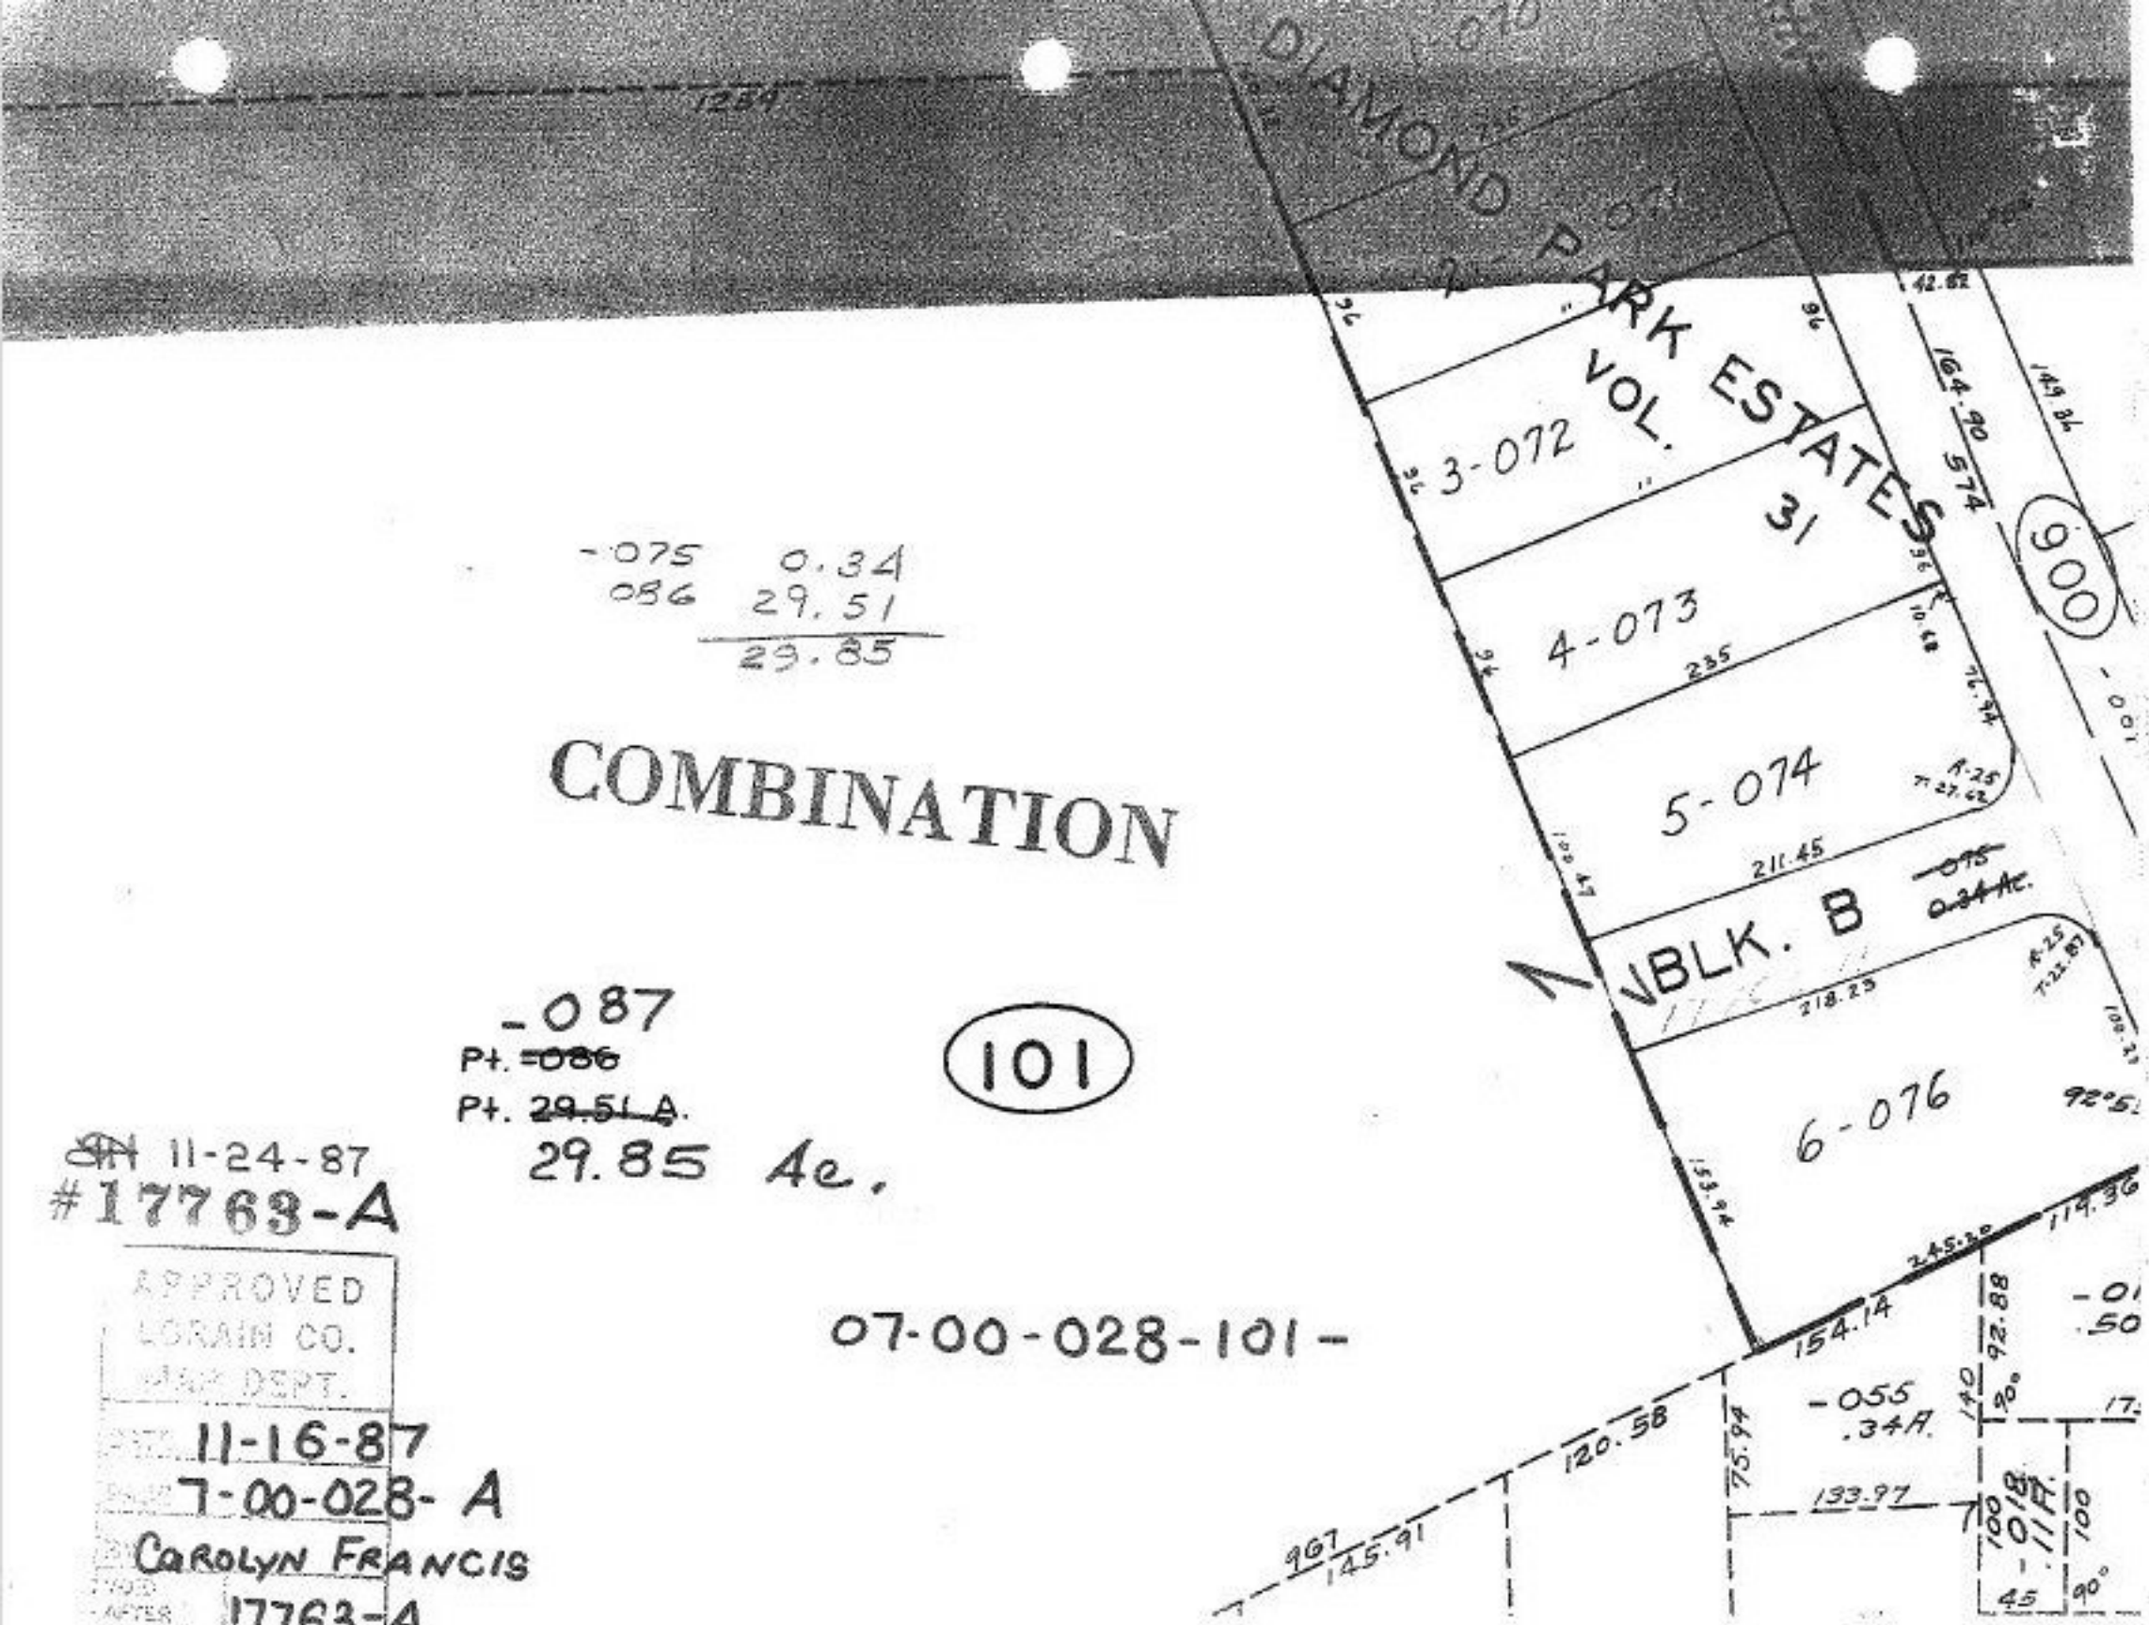
DIAMOND PARK ESTATES
VOL. 31
3-072
4-073
5-074
6-076
BLK. B
900
-075 0.34
086 29.51
29.85
COMBINATION
-087
Pt. ~~-086~~
Pt. ~~29.51 A.~~
29.85 Ac.
101
07-00-028-101-
11-24-87
#17763-A
APPROVED
LORAIN CO.
MAP DEPT.
11-16-87
7-00-028- A
CAROLYN FRANCIS
17763-A
-055
.34A.
154.14
120.58
133.97
145.91
164.90
574
149.36
92.88
75.94
967
45
90°