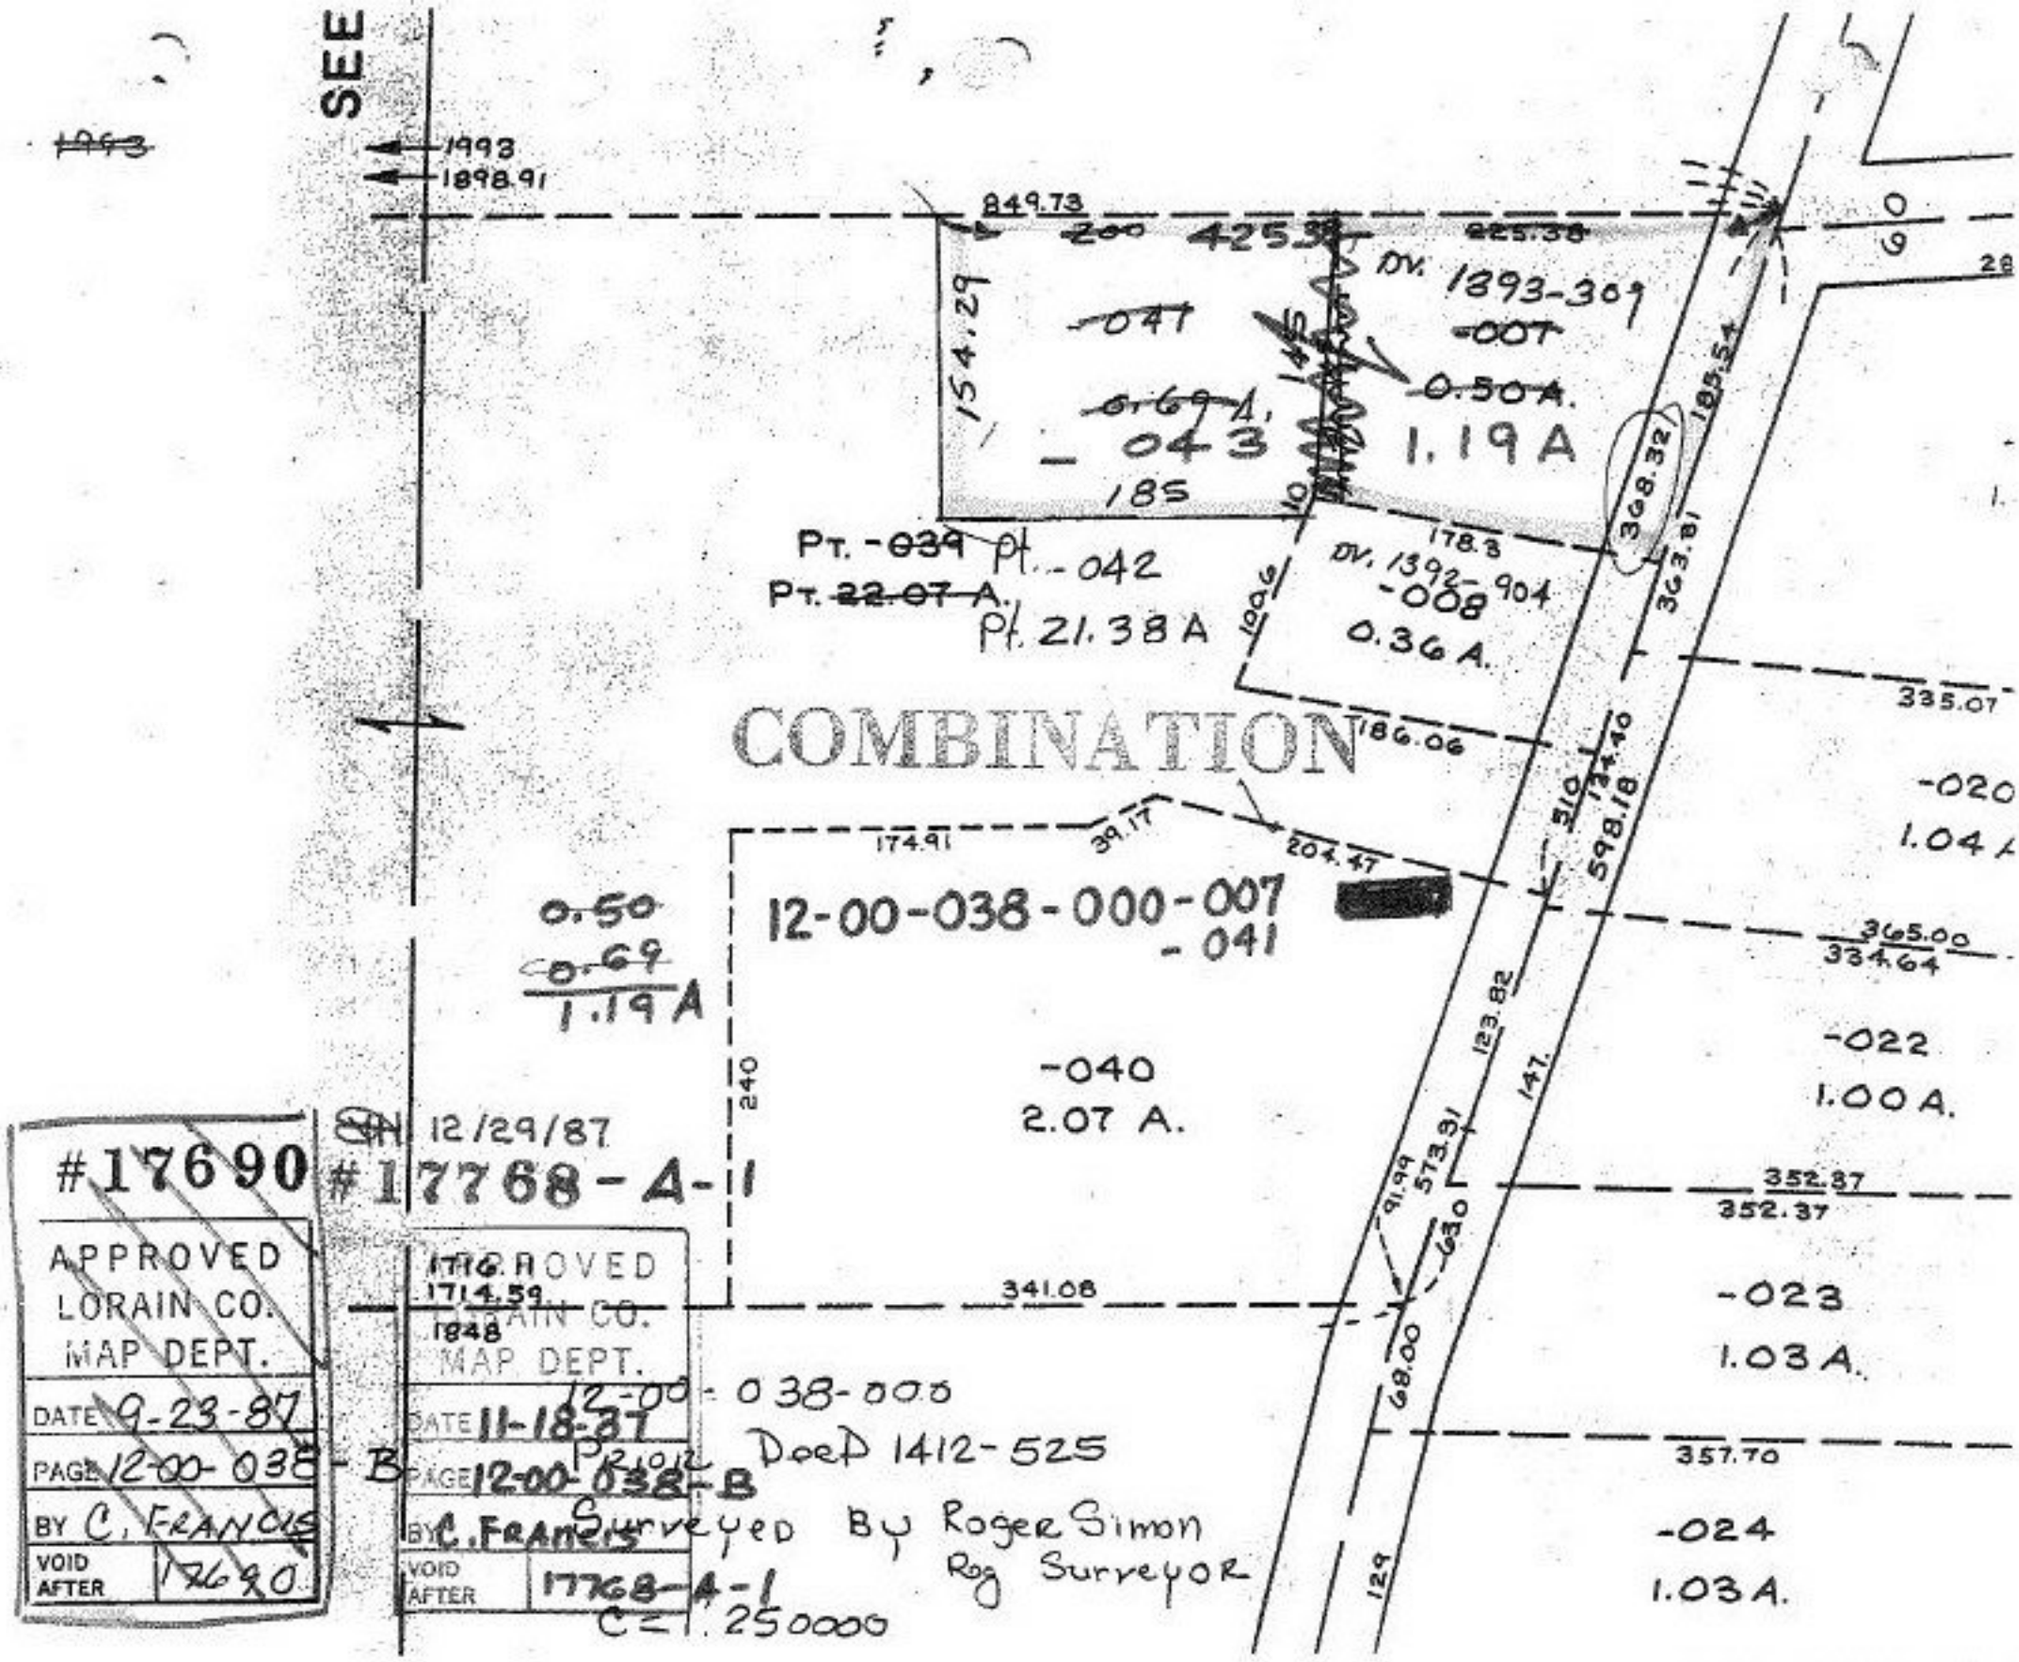
SEE
1993
1898.91
849.73
200
425.38
225.38
DV. 1893-309
-007
0.50A.
-041
0.69 A.
-043
1.19A
185
154.29
185.54
368.32
363.81
178.3
PT. -039 Pt. -042
PT. 22.07 A.
Pt. 21.38 A
DV. 1392-904
-008
0.36 A.
COMBINATION
335.07
-020
1.04 A
186.06
174.91
39.17
202.47
210
134.40
598.18
0.50
0.69
1.19A
12-00-038-000-007
-041
365.00
334.64
-040
2.07 A.
240
-022
1.00A.
123.82
147.
91.94
573.31
630
352.87
352.37
341.08
-023
1.03A.
68.00
357.70
-024
1.03A.
129
12/29/87
#17690
#17768-A-1
APPROVED
LORAIN CO.
MAP DEPT.
DATE 9-23-87
PAGE 12-00-038-B
BY C. FRANCIS
VOID AFTER 17690
APPROVED
1716.
1714.59
1848
LORAIN CO.
MAP DEPT.
DATE 11-18-87
PAGE 12-00-038-B
BY C. FRANCIS
VOID AFTER 17768-A-1
12-00-038-000
Deed 1412-525
Surveyed By Roger Simon
Reg Surveyor
C=1.250000