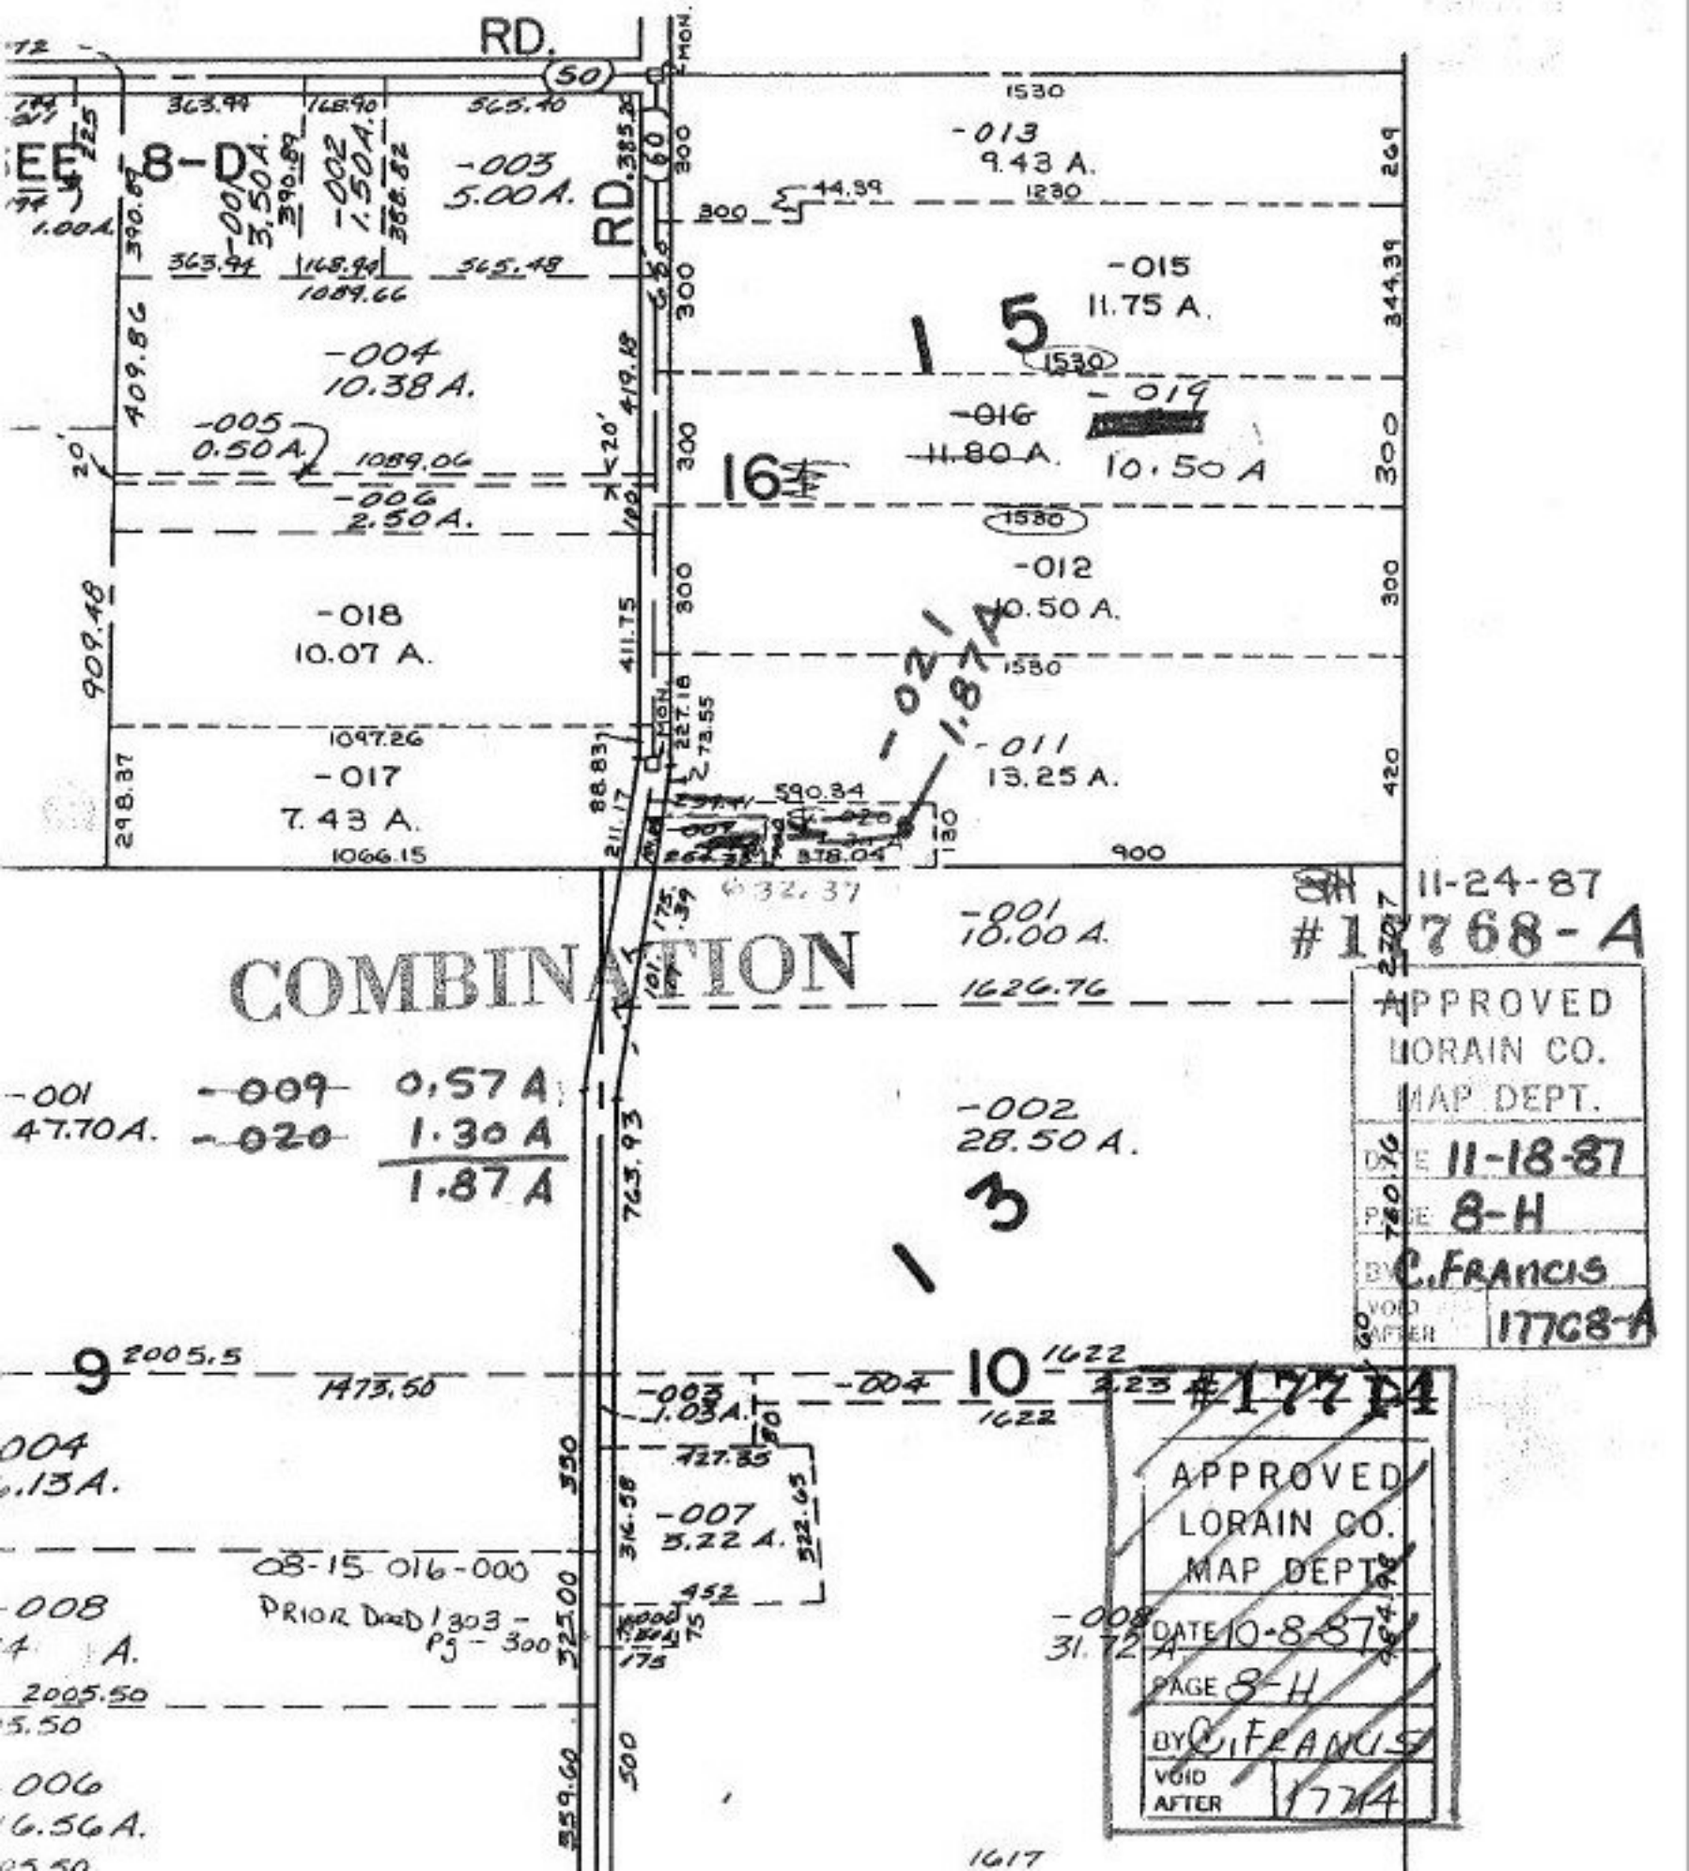
RD.
50
RD.
60
8-D
-001
3.50A.
-002
1.50A.
-003
5.00A.
-004
10.38A.
-005
0.50A.
-006
2.50A.
-018
10.07 A.
-017
7.43 A.
-013
9.43 A.
-015
11.75 A.
-016
11.80 A.
-019
10.50 A
-012
10.50 A.
-011
13.25 A.
-021
1.87A
15
16
COMBINATION
-001
47.70A.
-009
0.57 A
-020
1.30 A
1.87 A
-002
28.50 A.
13
9
10
-008
31.72 A.
-007
5.22 A.
-001
10.00 A.
08-15-016-000
PRIOR DEED 1303 - PG - 300
1617
11-24-87
#17768-A
APPROVED
LORAIN CO.
MAP DEPT.
DATE 11-18-87
PAGE 8-H
BY C. FRANCIS
VOID AFTER 17768-A
#17714
APPROVED
LORAIN CO.
MAP DEPT.
DATE 10-8-87
PAGE 8-H
BY C. FRANCIS
VOID AFTER 17714