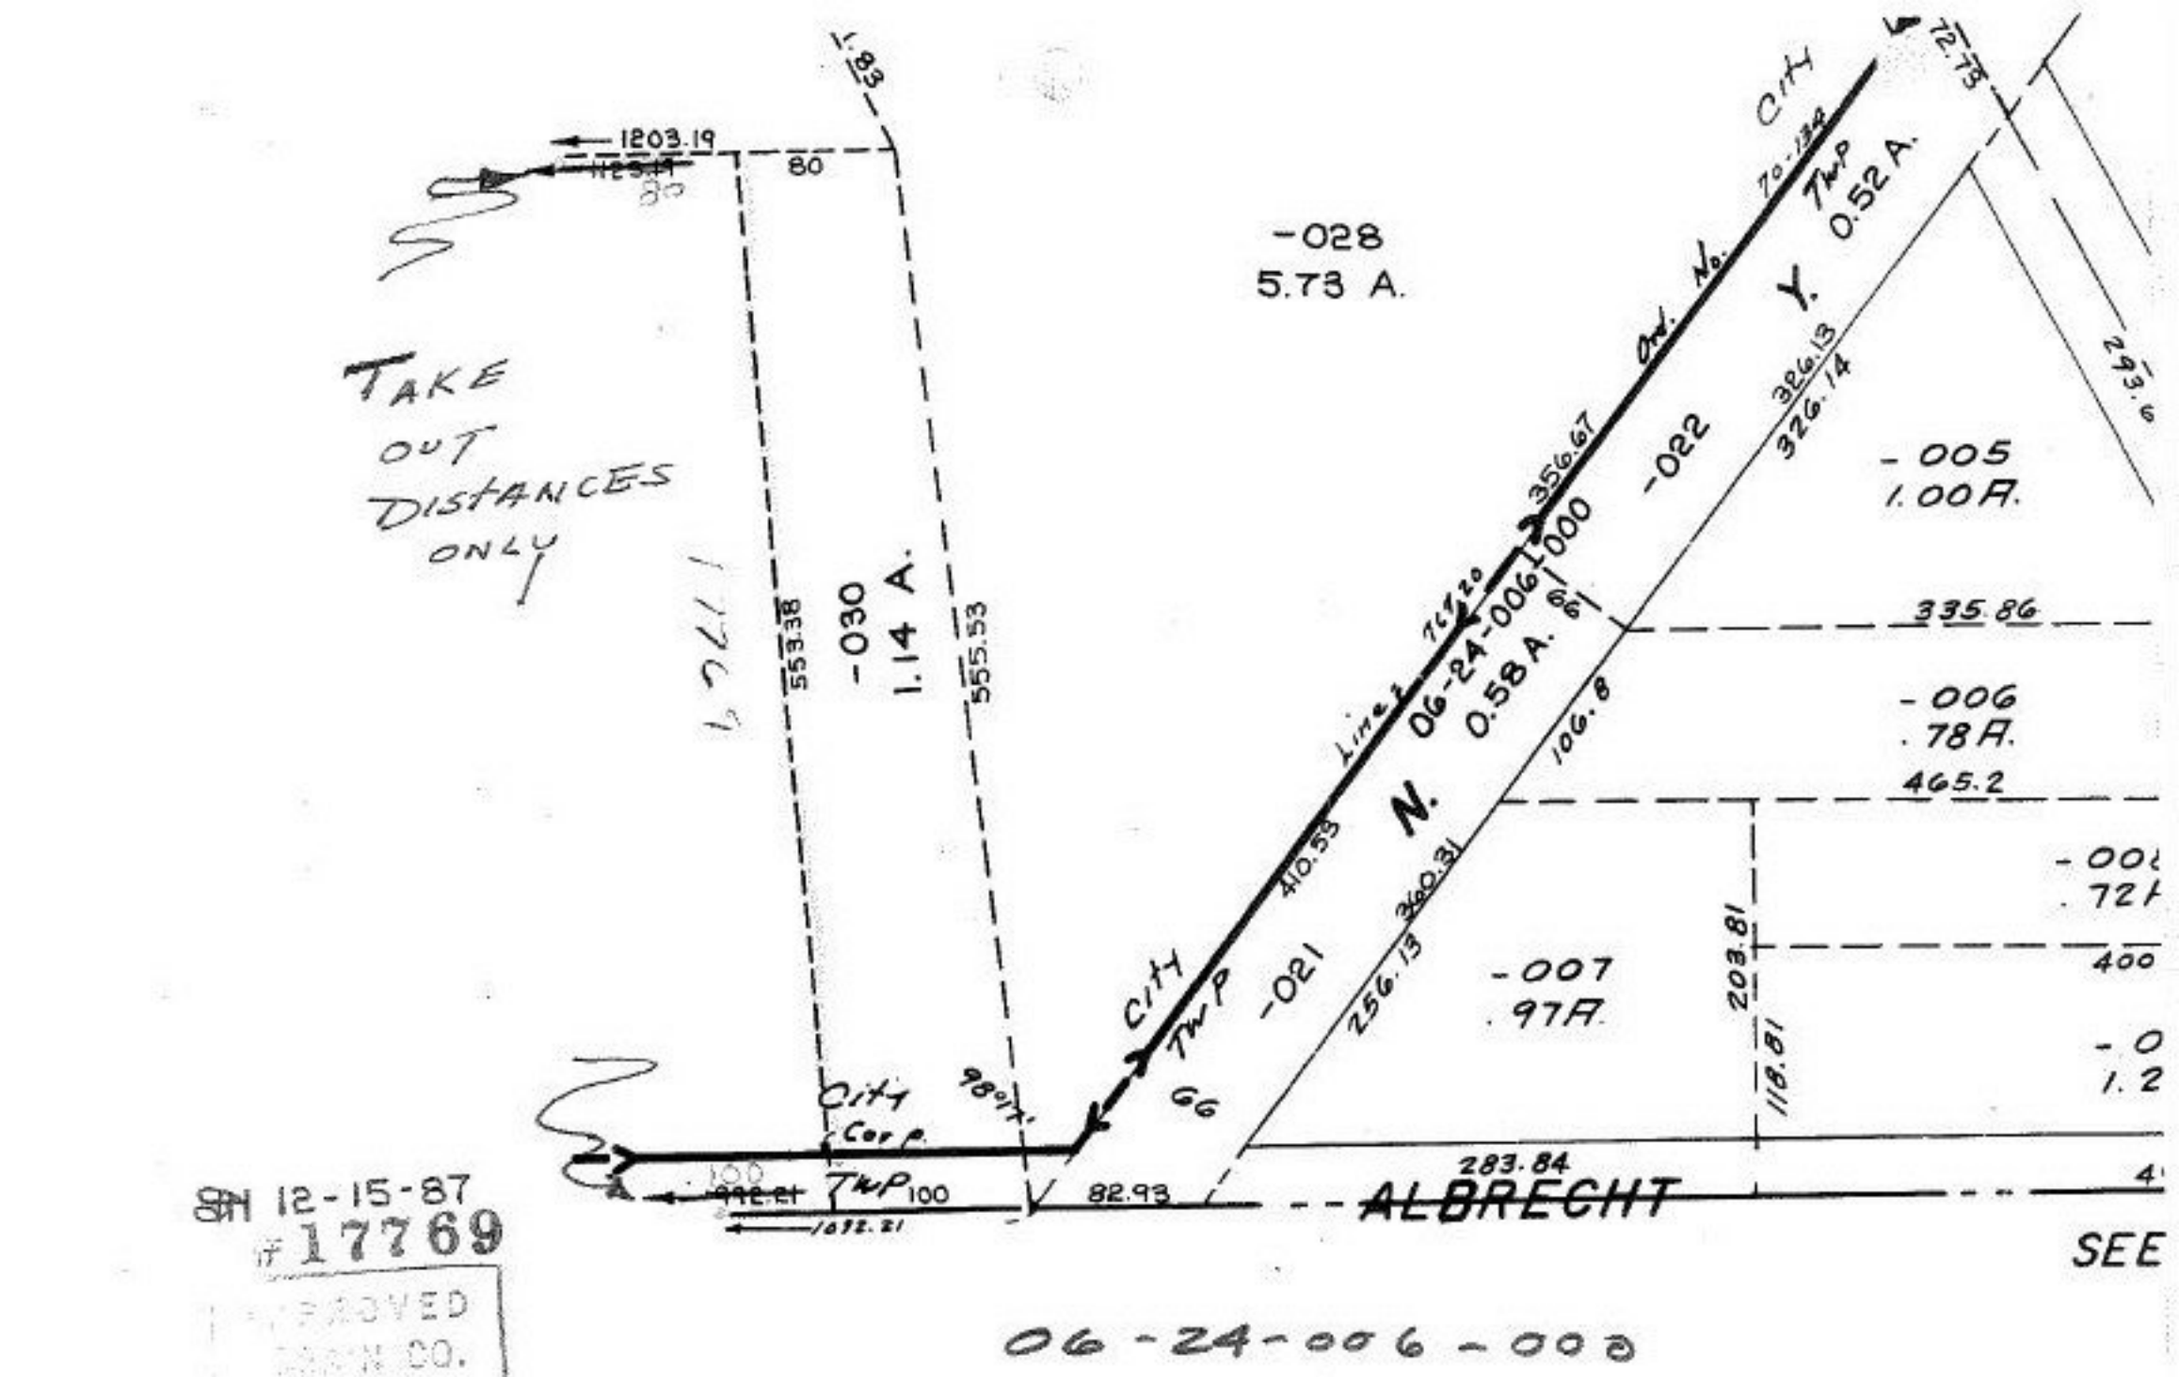


SH 12-15-87
# 17769

APPROVED
LORAIN CO.
ENG. DEPT.
11-18-87
G-131
CAROL-FRANCIS
WORD AFTER 17769

963

# ELYRIA TWP.

SCALE: 1" = 100'