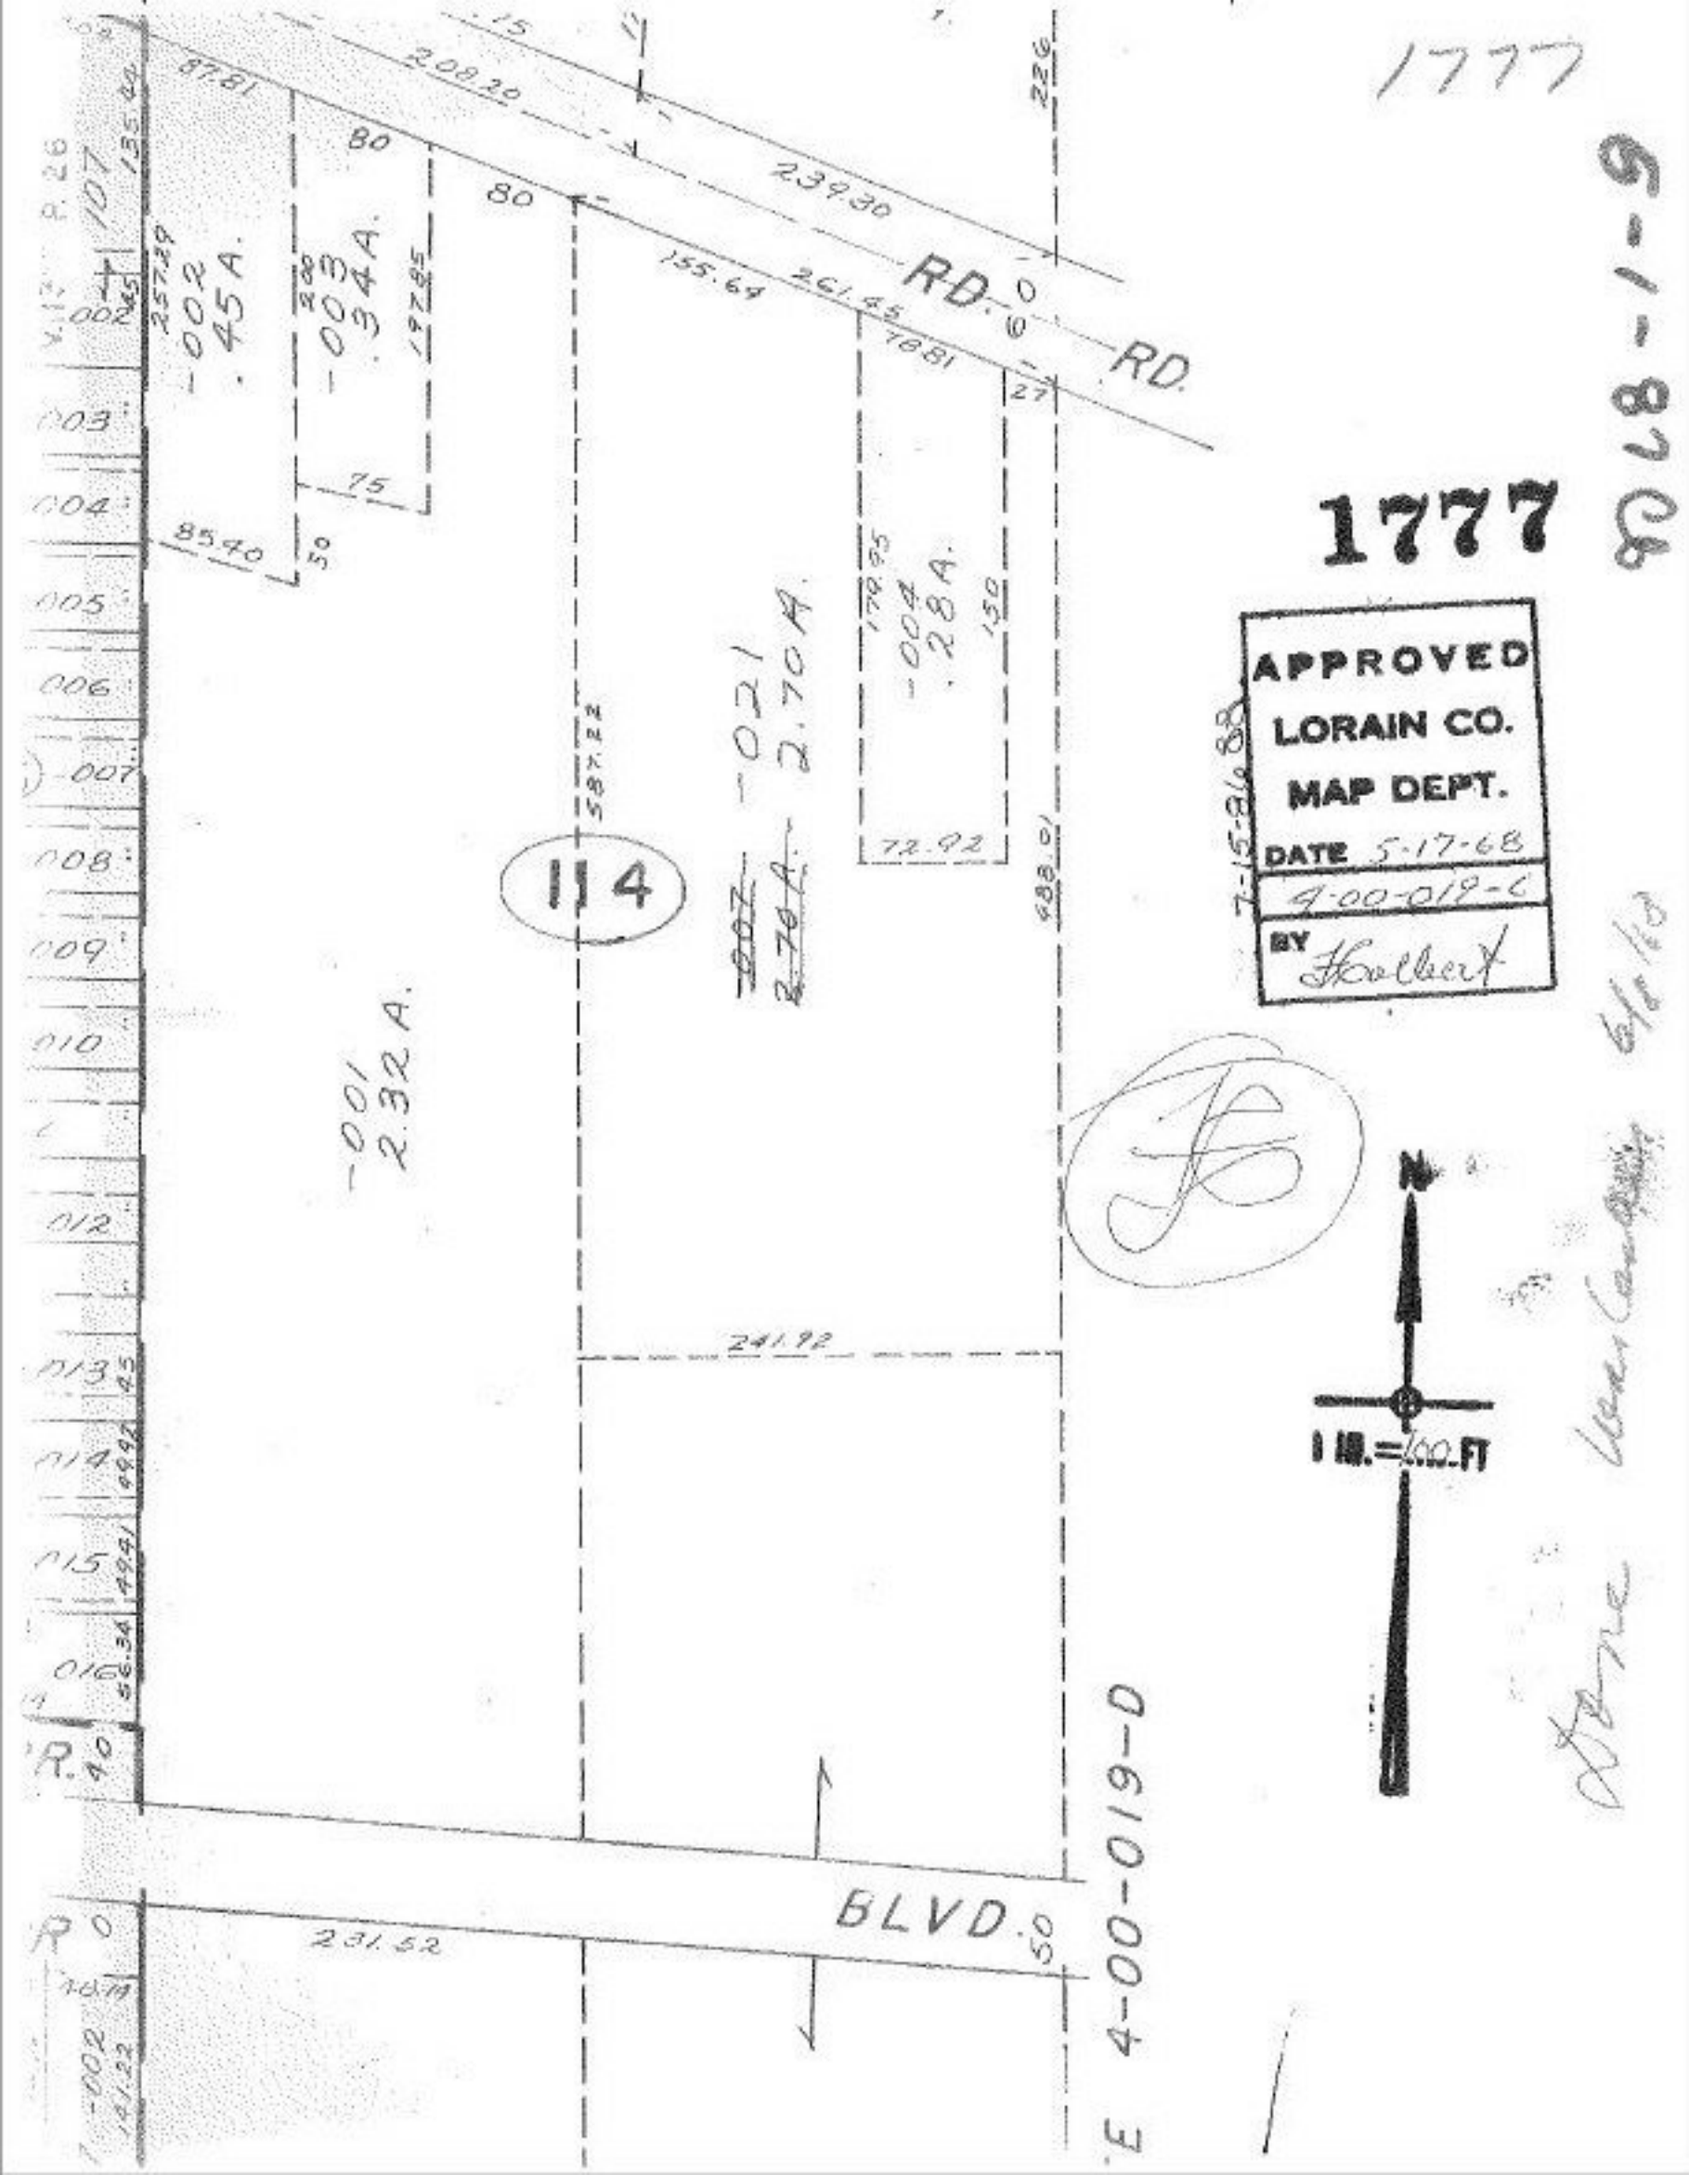
1777
6-1-87 08
1777
APPROVED
LORAIN CO.
MAP DEPT.
DATE 5-17-68
4-00-019-C
BY Holbert
7-15-86 88
114
-001
2.32 A.
-002
.45 A.
-003
.34 A.
-004
.28 A.
-021
2.70 A.
RD.
RD.
BLVD.
4-00-019-D
1 IN. = 100 FT
N
208.20
239.30
155.64
261.45
78.81
72.92
241.92
231.52
587.22
488.01
85.40
197.85
257.29
135.44
87.81
226