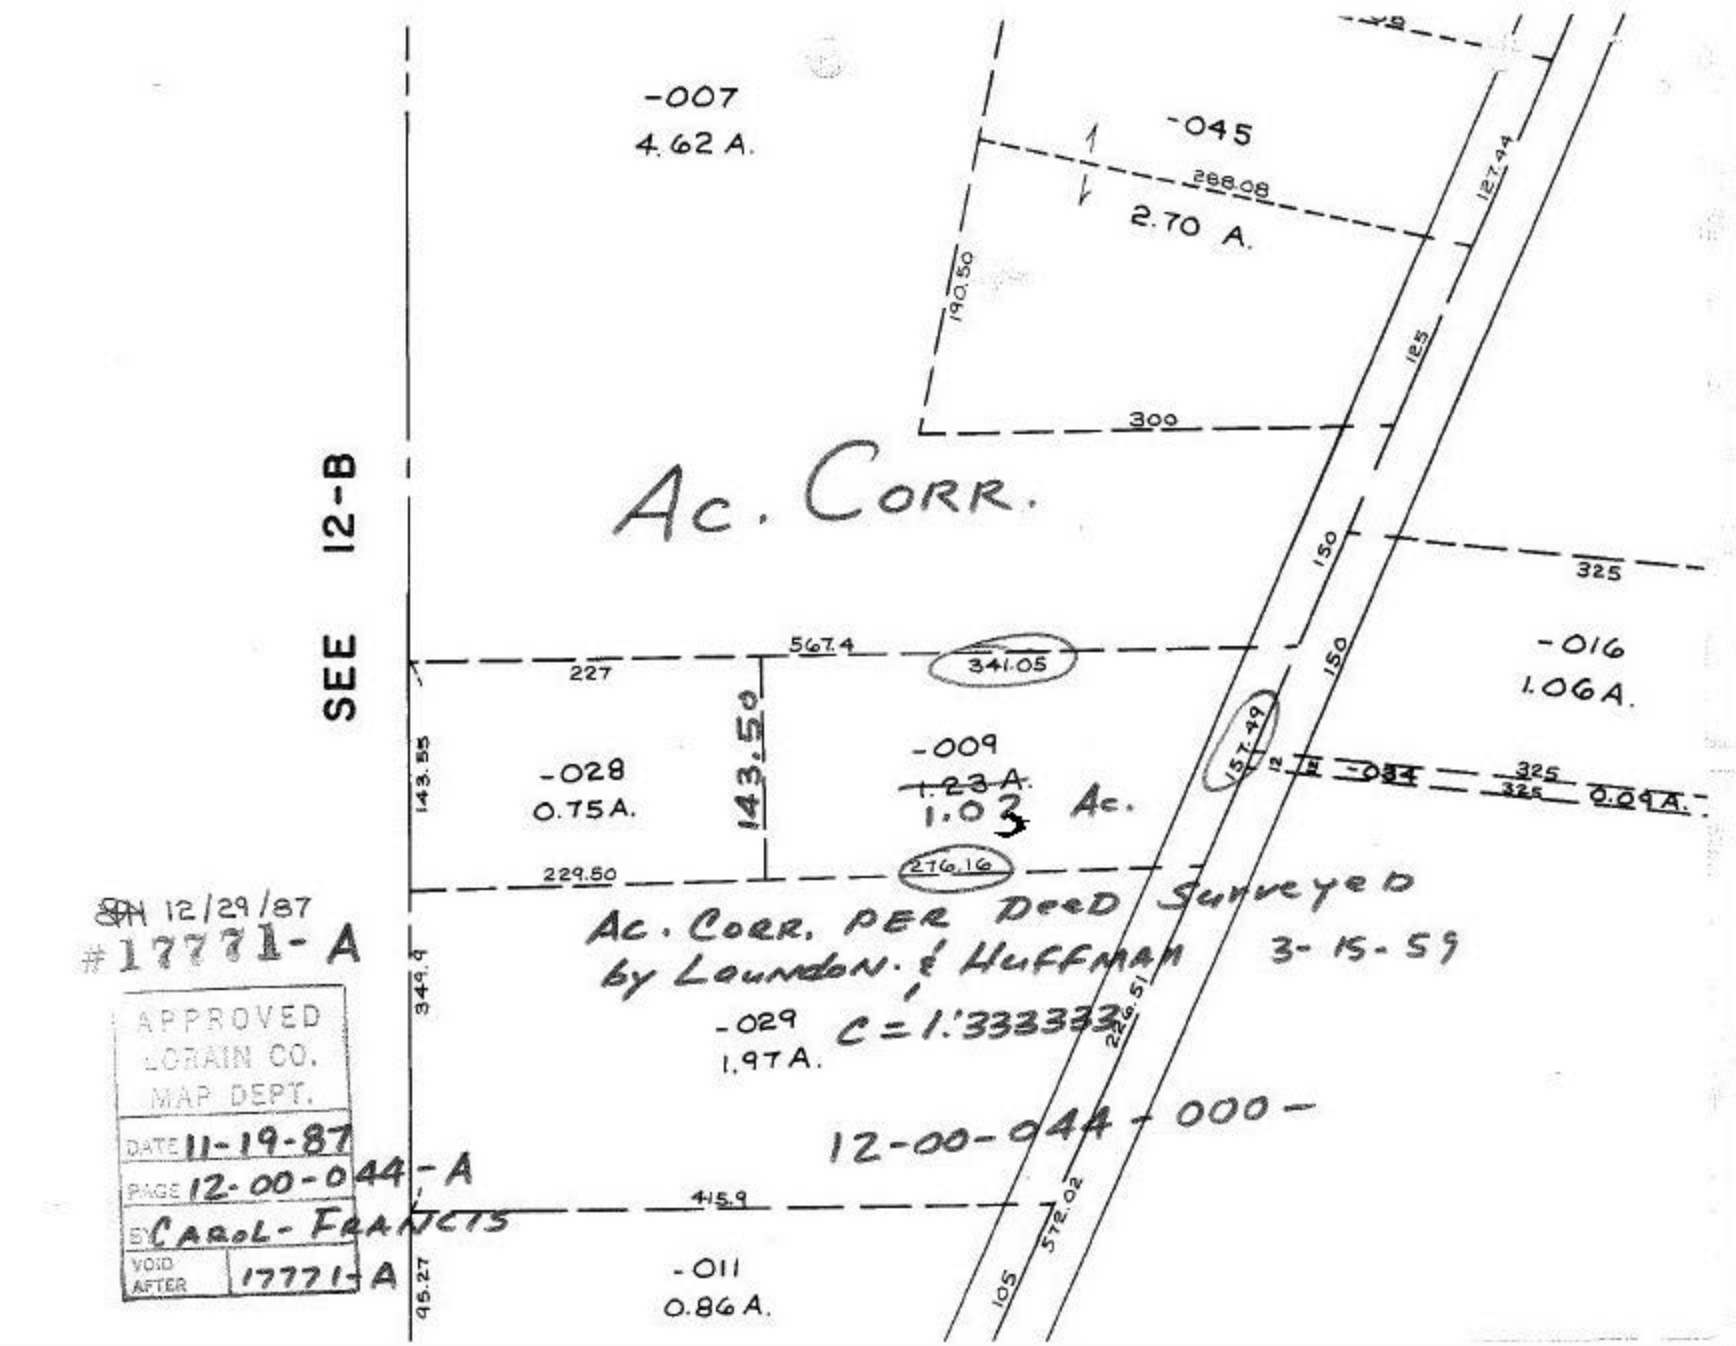
-007
4.62 A.
-045
2.70 A.
288.08
190.50
127.44
125
300
Ac. Corr.
SEE 12-B
150
325
567.4
227
341.05
-016
1.06A.
143.55
143.50
-028
0.75A.
-009
1.23A.
1.03 Ac.
157.49
325
325
0.09A.
229.50
276.16
Ac. Corr. per Deed Surveyed
by Lounsbon & Huffman 3-15-59
C = 1.333333
-029
1.97A.
344.9
226.51
12-00-044-000-
415.9
572.02
105
95.27
-011
0.86A.
SN 12/29/87
#17771-A
APPROVED
LORAIN CO.
MAP DEPT.
DATE 11-19-87
PAGE 12-00-044-A
BY CAROL-FRANCIS
VOID AFTER 17771-A