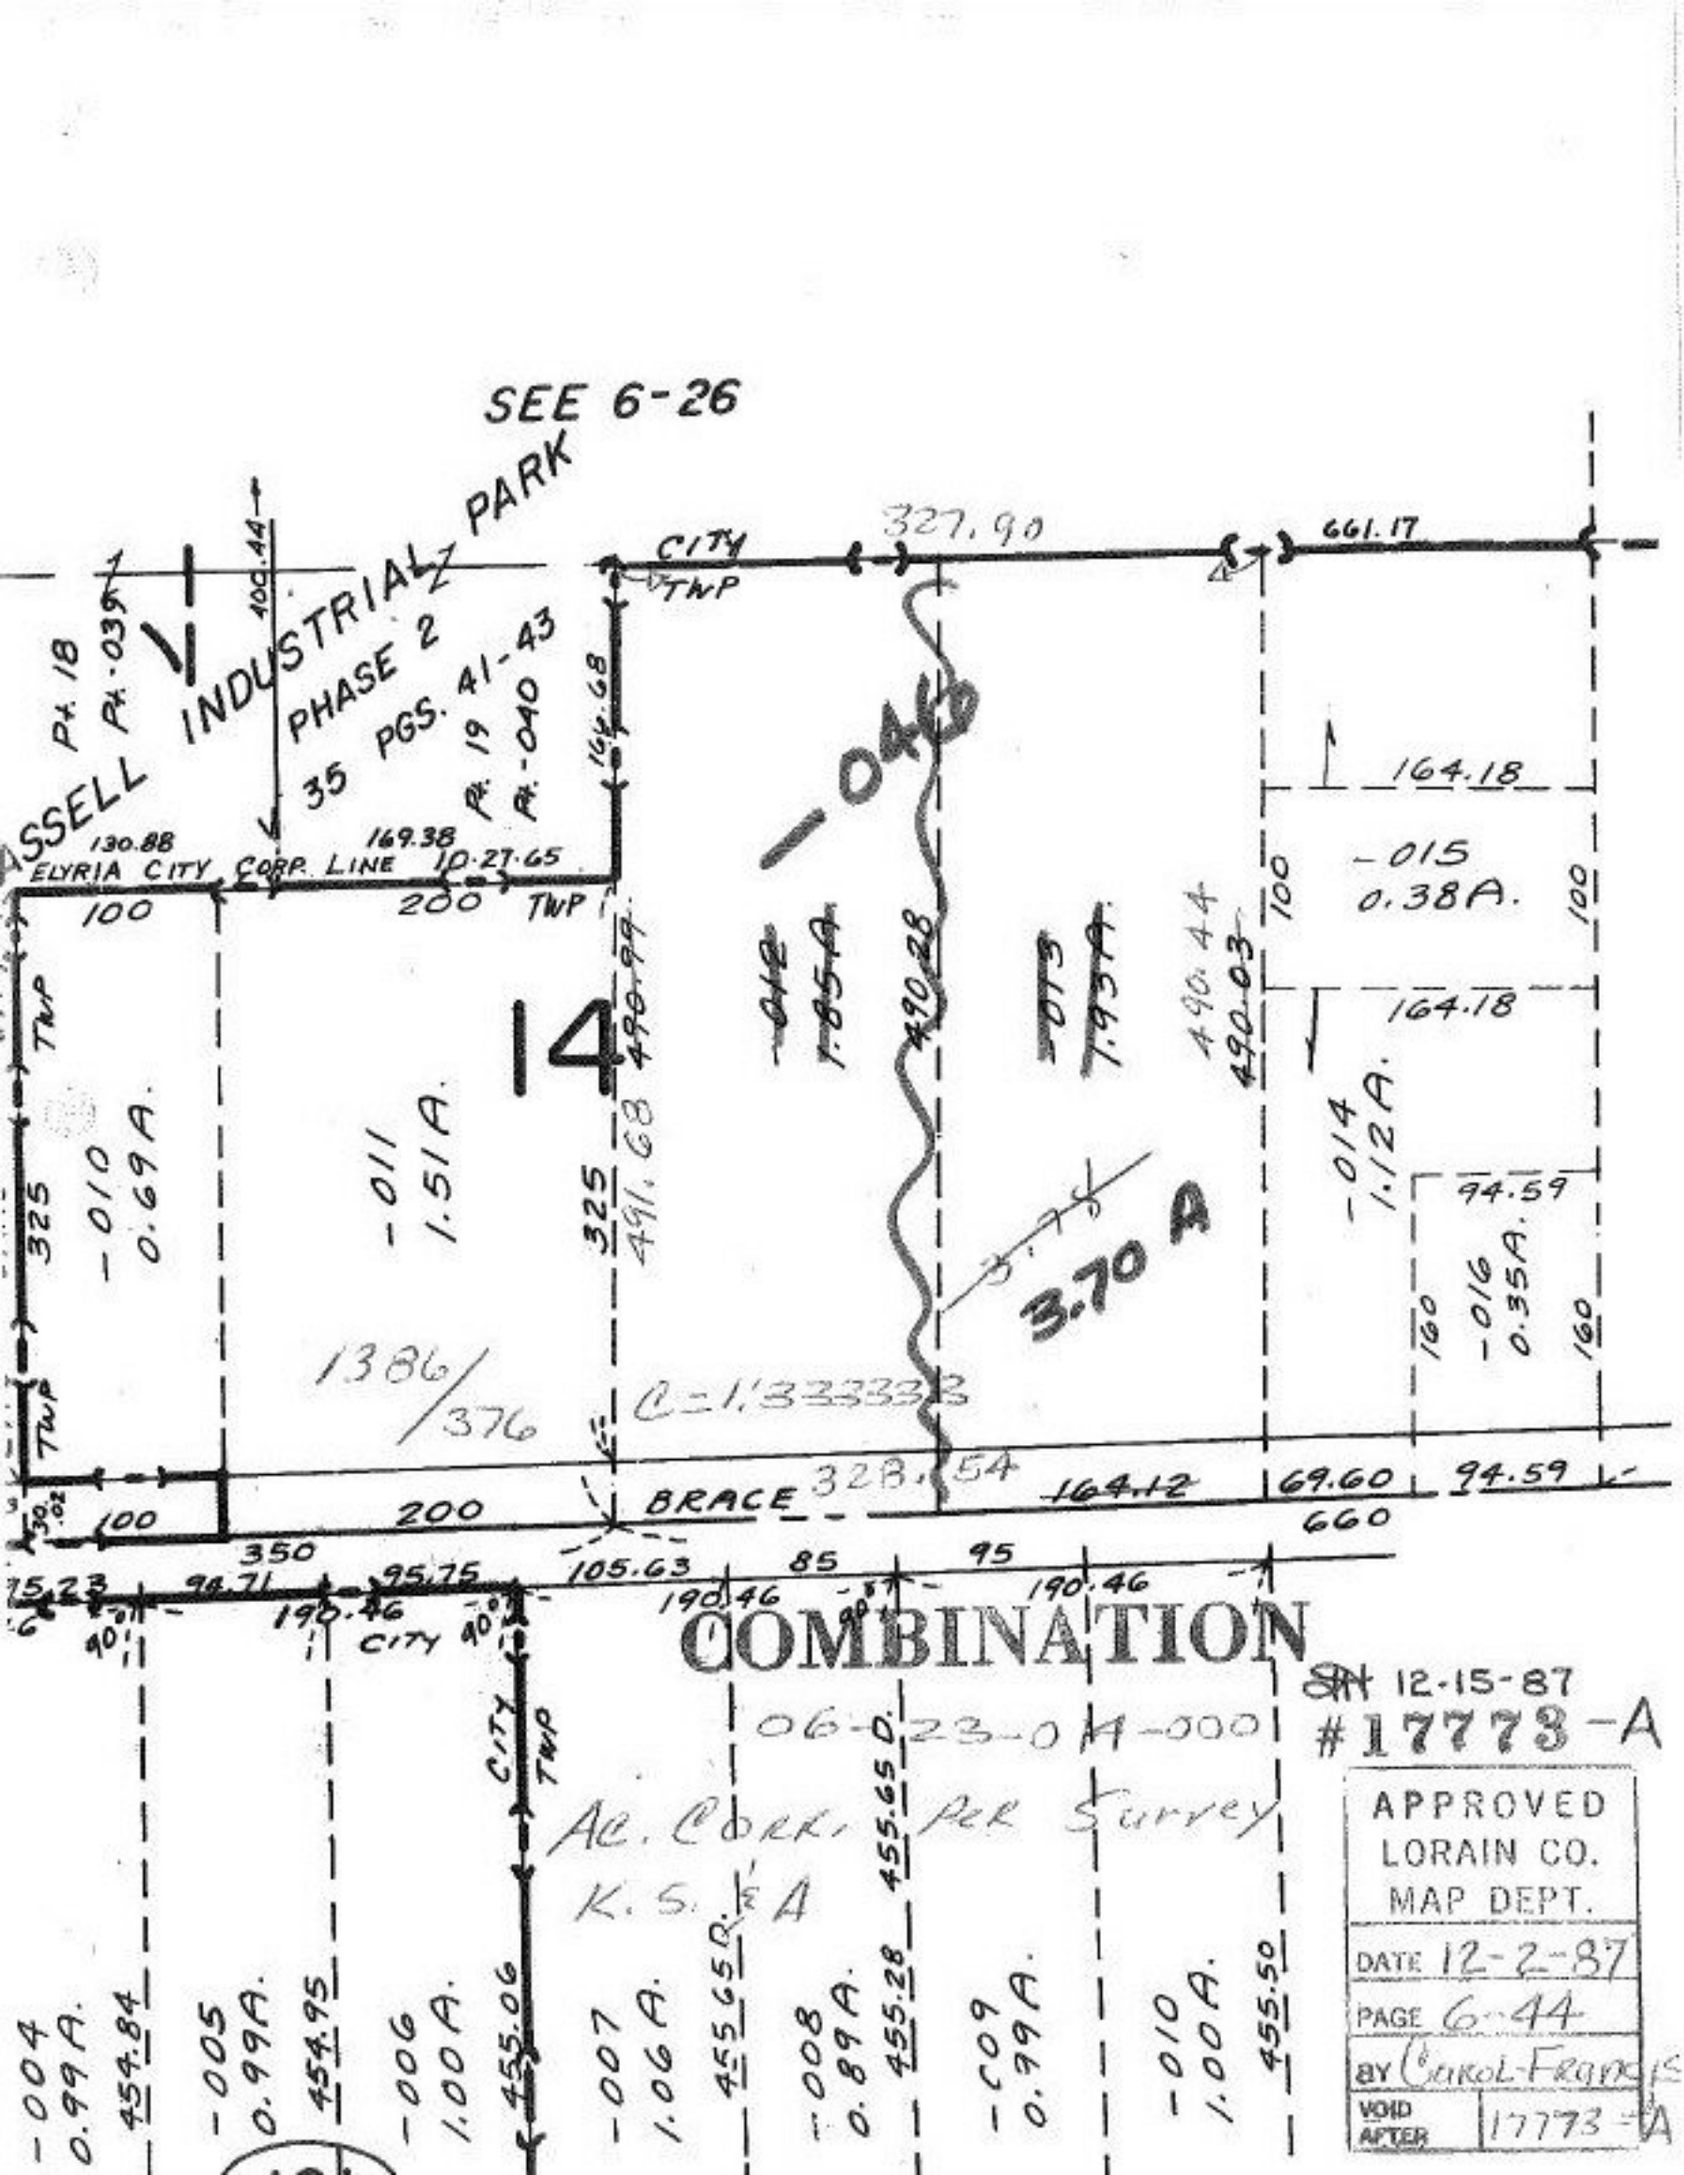
SEE 6-26
INDUSTRIAL PARK
PHASE 2
35 PGS. 41-43
Pt. 18
Pt. 039
Pt. 19
Pt. 040
SSELL
ELYRIA CITY CORP. LINE
CITY TWP
327.90
661.17
100.44
164.68
130.88
169.38
10.27.65
100
200
TWP
-045
-012
1.85A.
490.28
-013
1.93A.
490.44
490.03
164.18
-015
0.38A.
100
164.18
-014
1.12A.
94.59
-016
0.35A.
160
160
14
-010
0.69A.
325
-011
1.51A.
325
491.68
490.99
3.70 A
1386/376
C=1.133333
328.54
164.12
69.60
94.59
660
BRACE
200
100
30.02
350
95.75
105.63
85
95
190.46
190.46
190.46
94.71
40'
CITY
40'
COMBINATION
12-15-87
#17773-A
06-23-04-000
All Cork, Per Survey
K.S. & A
APPROVED
LORAIN CO.
MAP DEPT.
DATE 12-2-87
PAGE 6-44
BY Carol-Francis
VOID AFTER 17773-A
-004
0.99A.
454.84
-005
0.99A.
454.95
-006
1.00A.
455.06
-007
1.06A.
455.65
-008
0.89A.
455.28
-009
0.99A.
455.65
-010
1.00A.
455.50