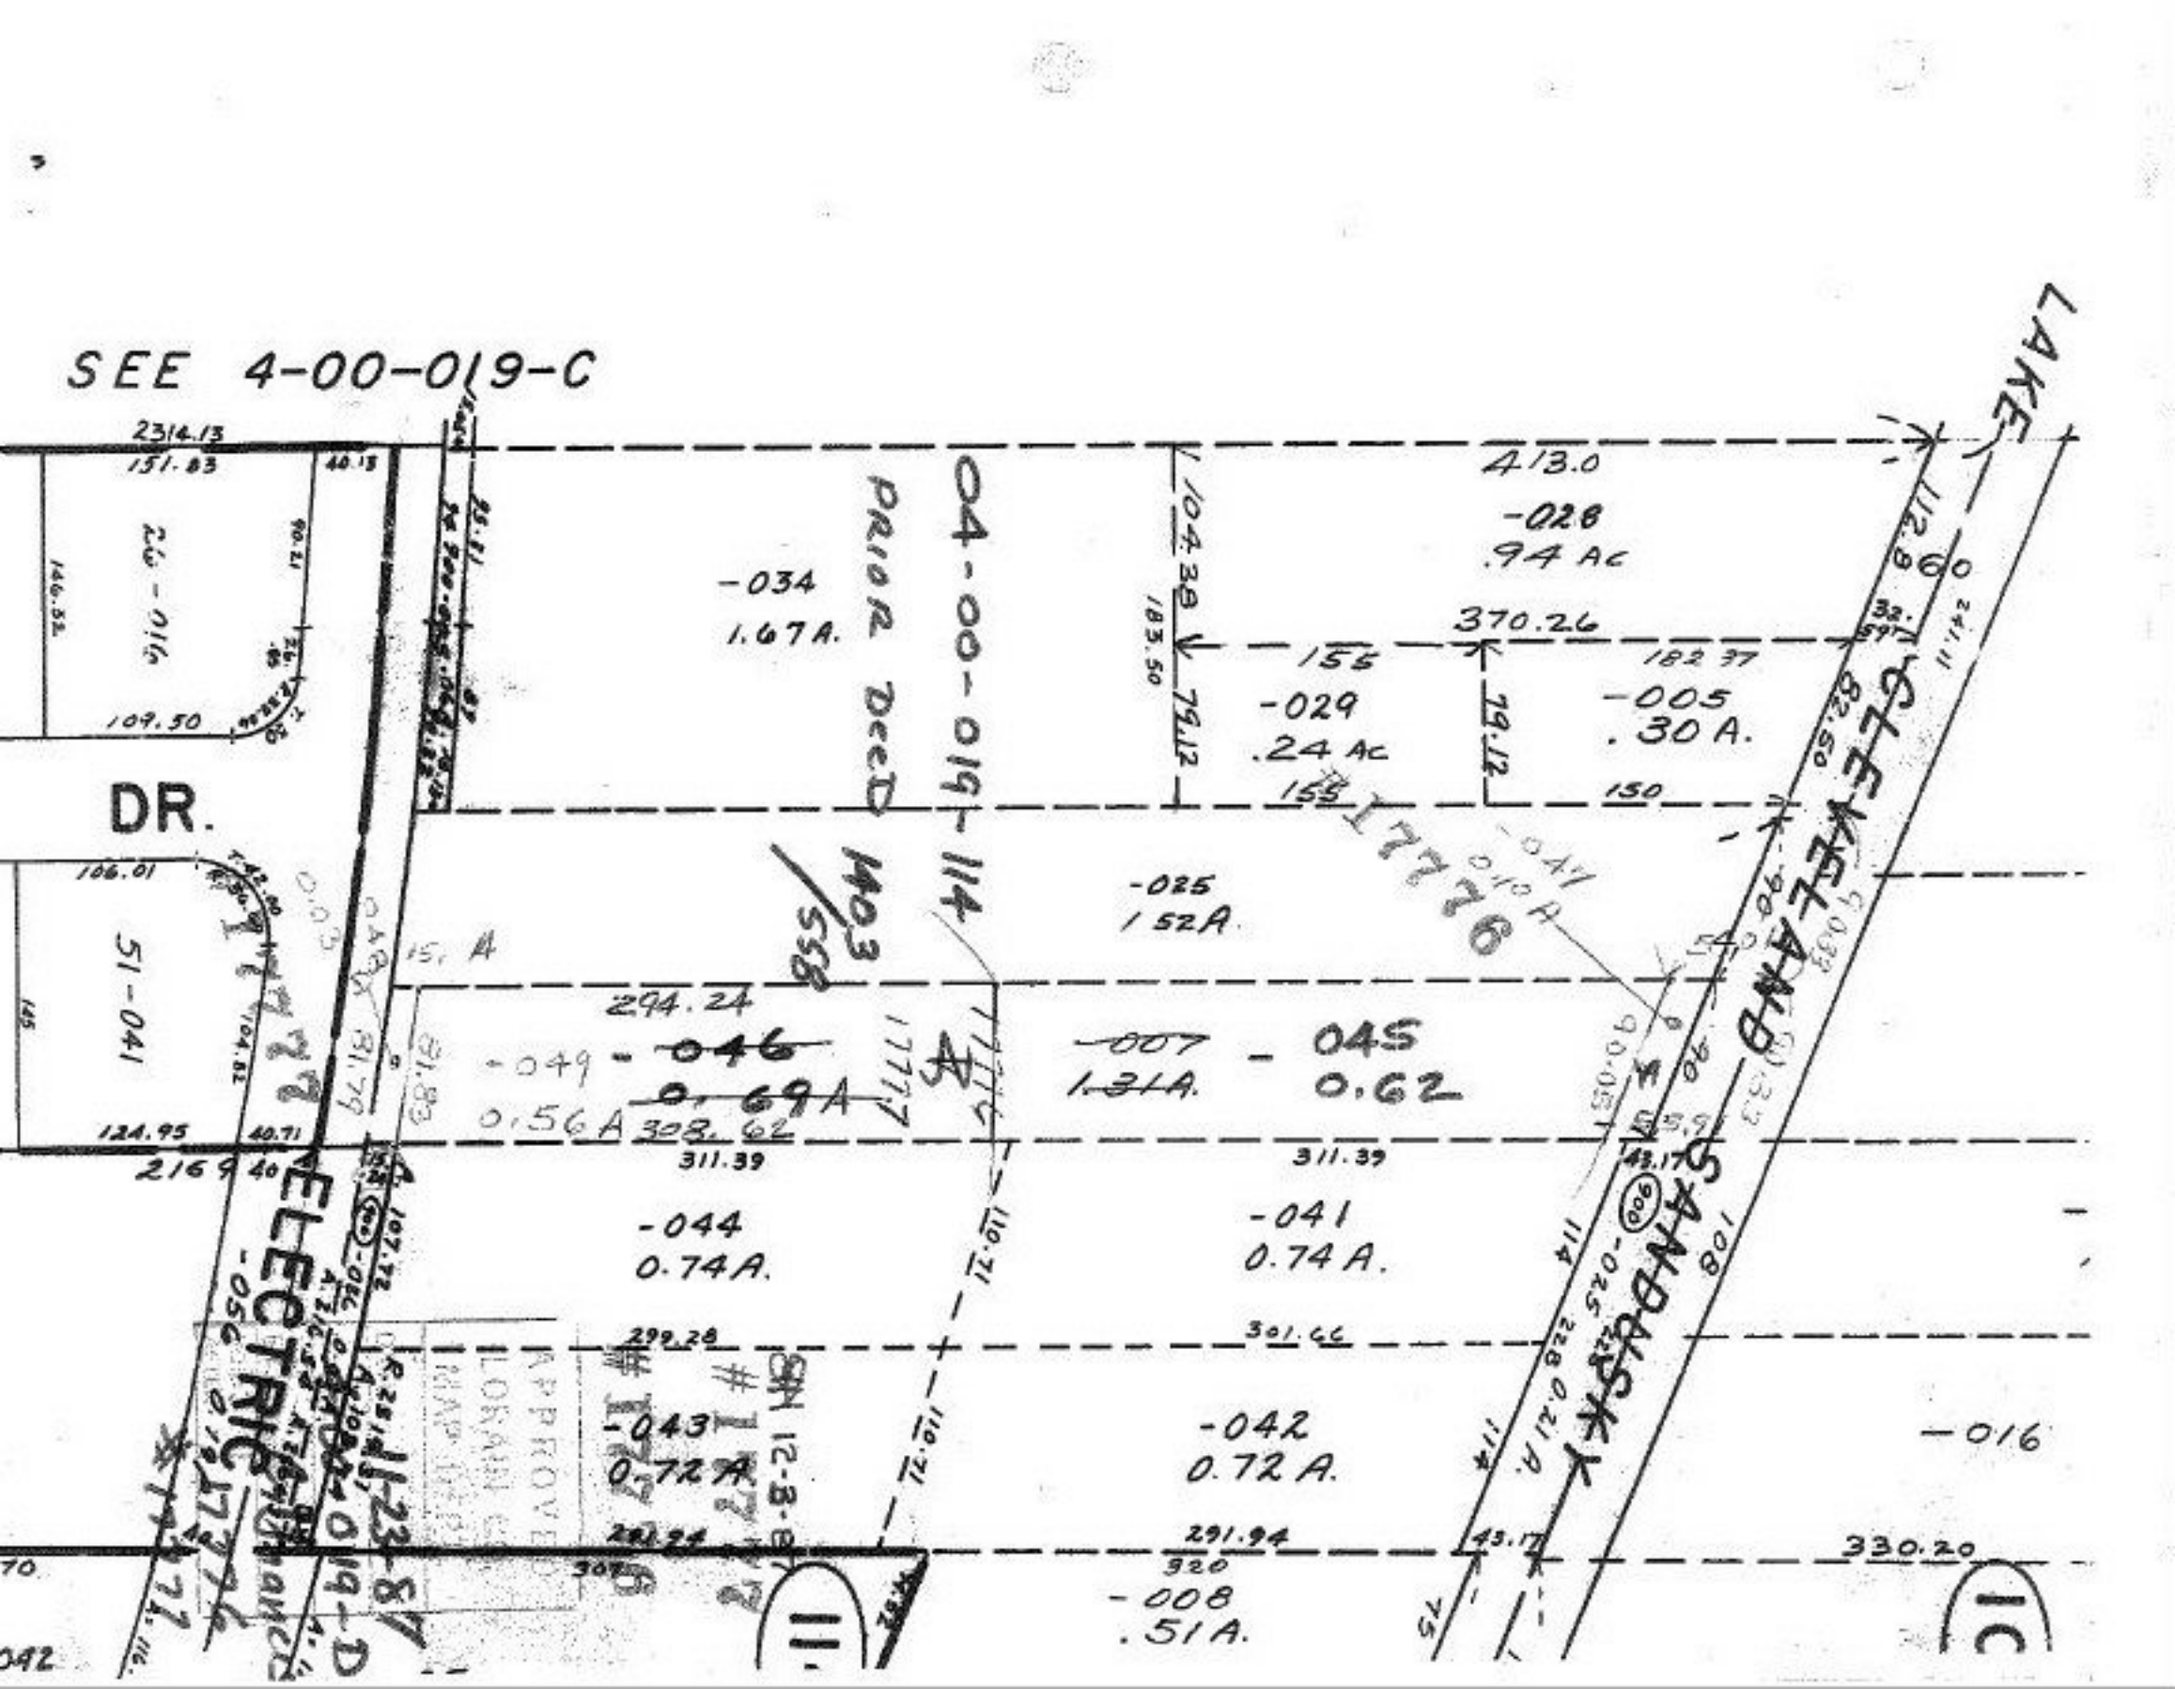
SEE 4-00-019-C
DR.
PRIOR DEED 1403 558
04-00-019-114
LAKE
ELECTRIC
-034
1.67A.
-028
.94 AC
-029
.24 AC
-005
.30 A.
-025
1.52A.
-007
1.31A.
-045
0.62
-046
0.69A
-049
0.56A
-044
0.74A.
-041
0.74A.
-043
0.72A.
-042
0.72A.
-008
.51A.
-016
-050
-025
-026
51-041
26-016
I 7726
I 7727
I 7727
I 7727