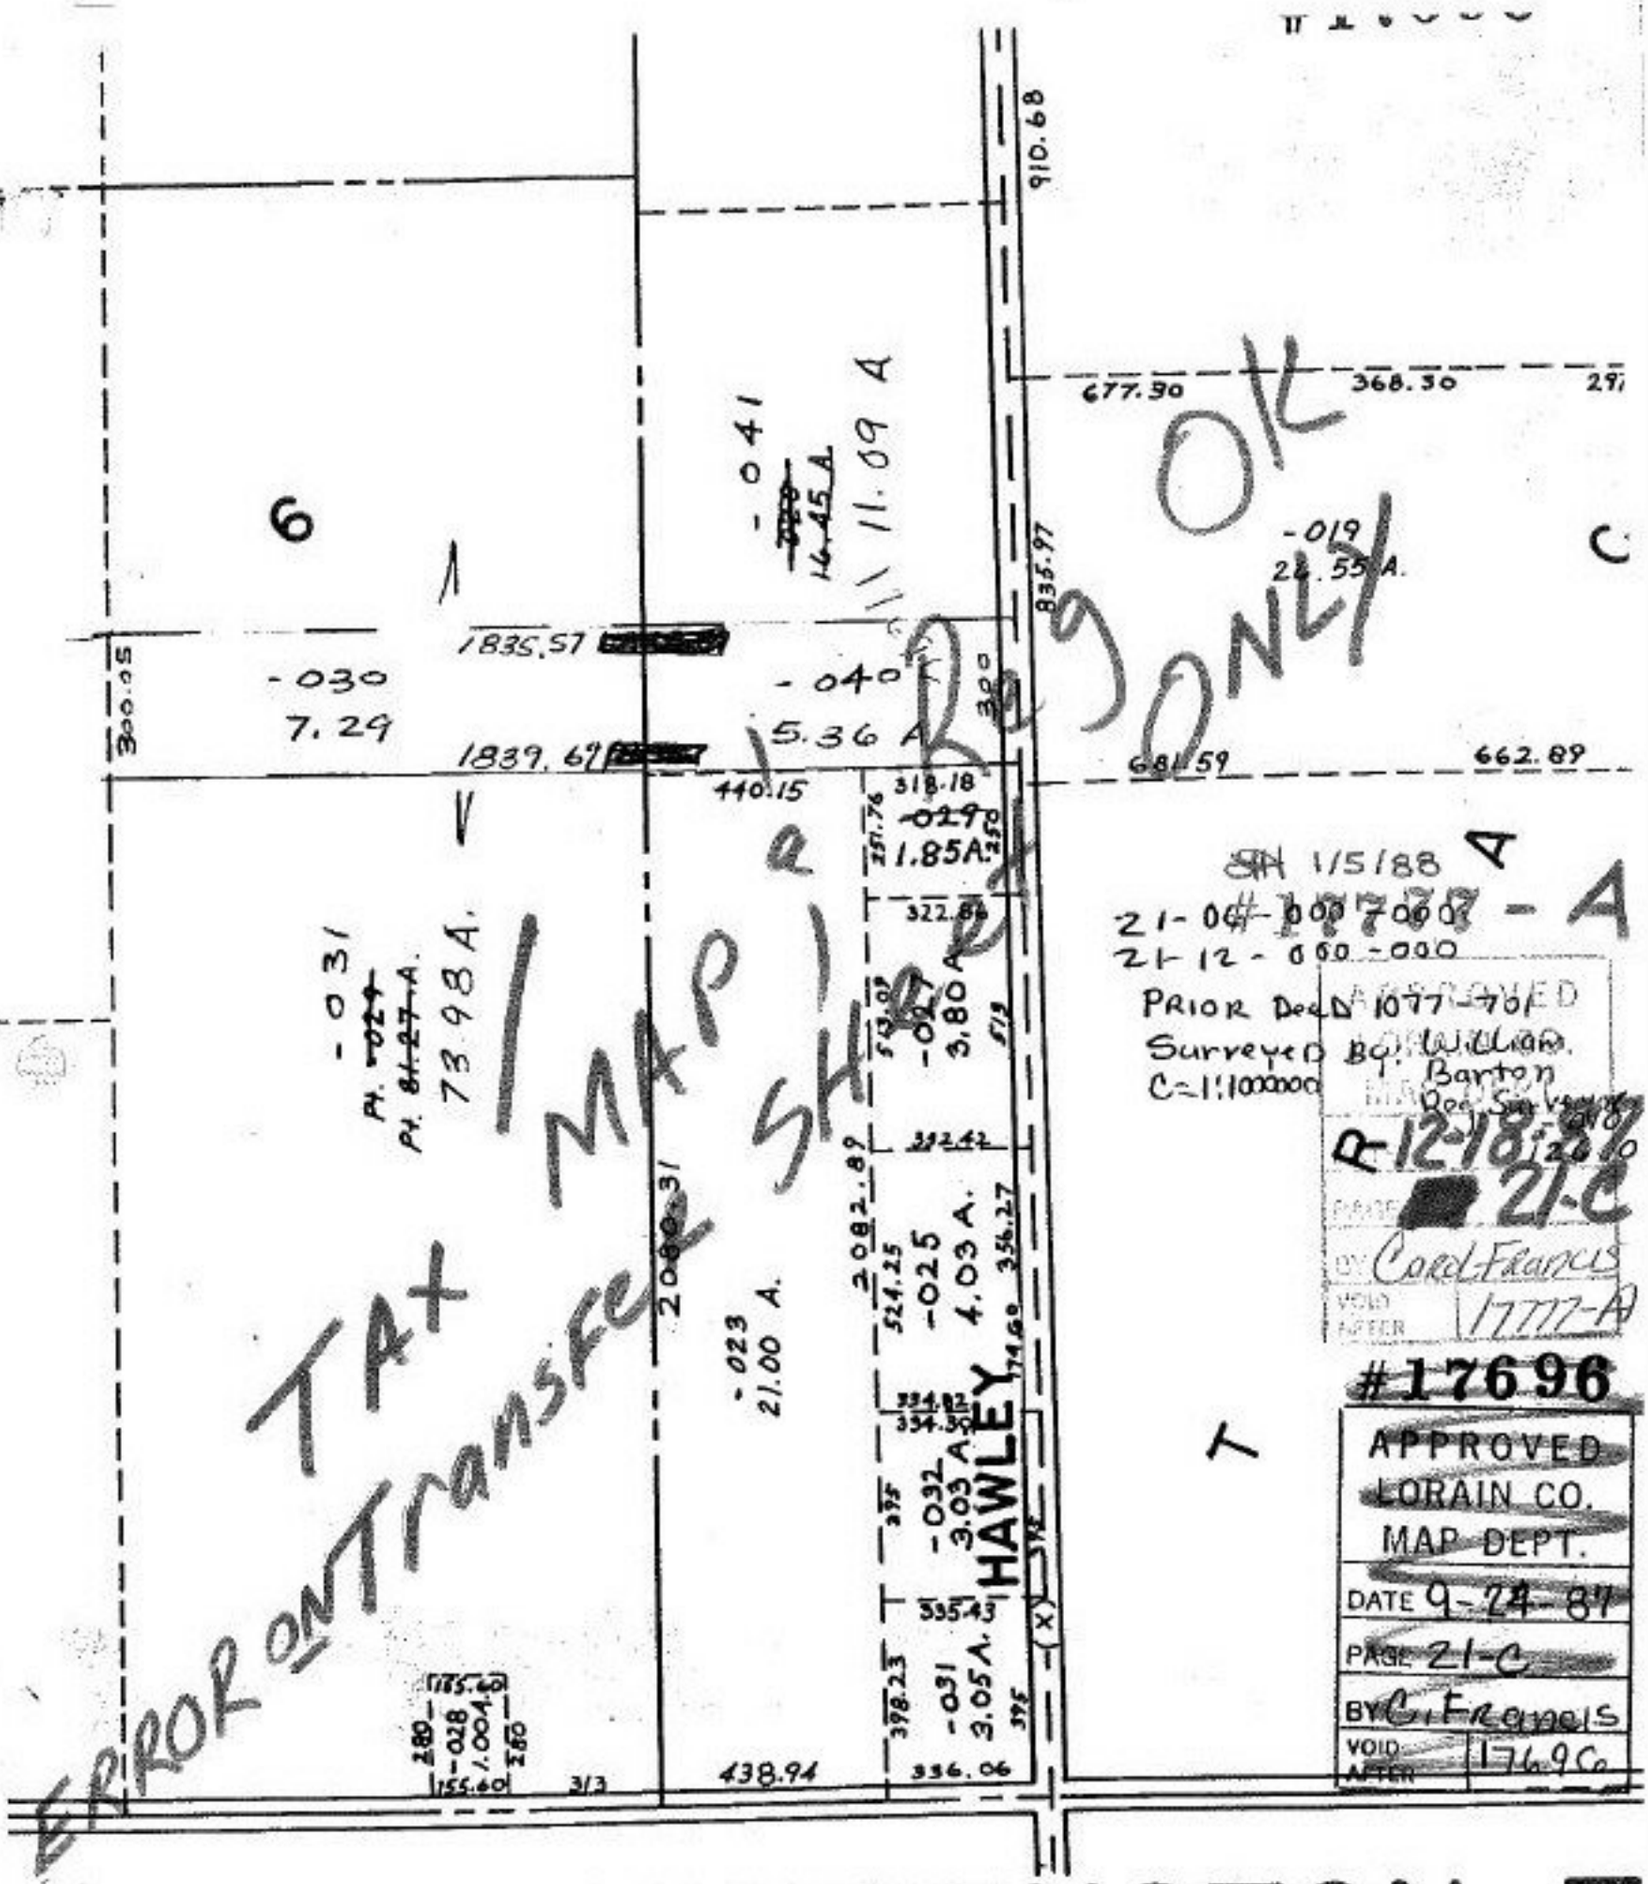
6
-041
14.45 A
11.09 A
677.90
368.30
910.68
-019
22.55 A.
C
835.97
1835.57
-030
7.29
300.05
-040
5.36 A
1839.67
440.15
681.59
662.89
318.18
-029
1.85A.
291.76
322.84
-031
Pl. 81-27-A.
73.98 A.
513.07
-027
3.80 A.
512
392.42
2082.89
524.25
-025
4.03 A.
356.27
2080.31
-023
21.00 A.
334.82
334.30
-032
3.03 A.
HAWLEY
395
395.43
398.23
-031
3.05 A.
395
(X)
T
185.60
280
-028
1.004
280
155.60
313
438.94
336.06
SH 1/5/88
21-06-000-700-08 - A
21-12-000-000
PRIOR DEED 1077-761
Surveyed By: William Barton
C=1:1000000
APPROVED
MAP DEPT.
R-12-18-87
PAGE 21-C
BY Carol Francis
VOID AFTER 17777-A
#17696
APPROVED
LORAIN CO.
MAP DEPT.
DATE 9-24-87
PAGE 21-C
BY C. Francis
VOID AFTER 17696
TAX MAP ONLY
TAX MAP ONLY
OK
ERROR ON Transfer SHEET
HUNTINGTON T
SCALE 1" = 400'