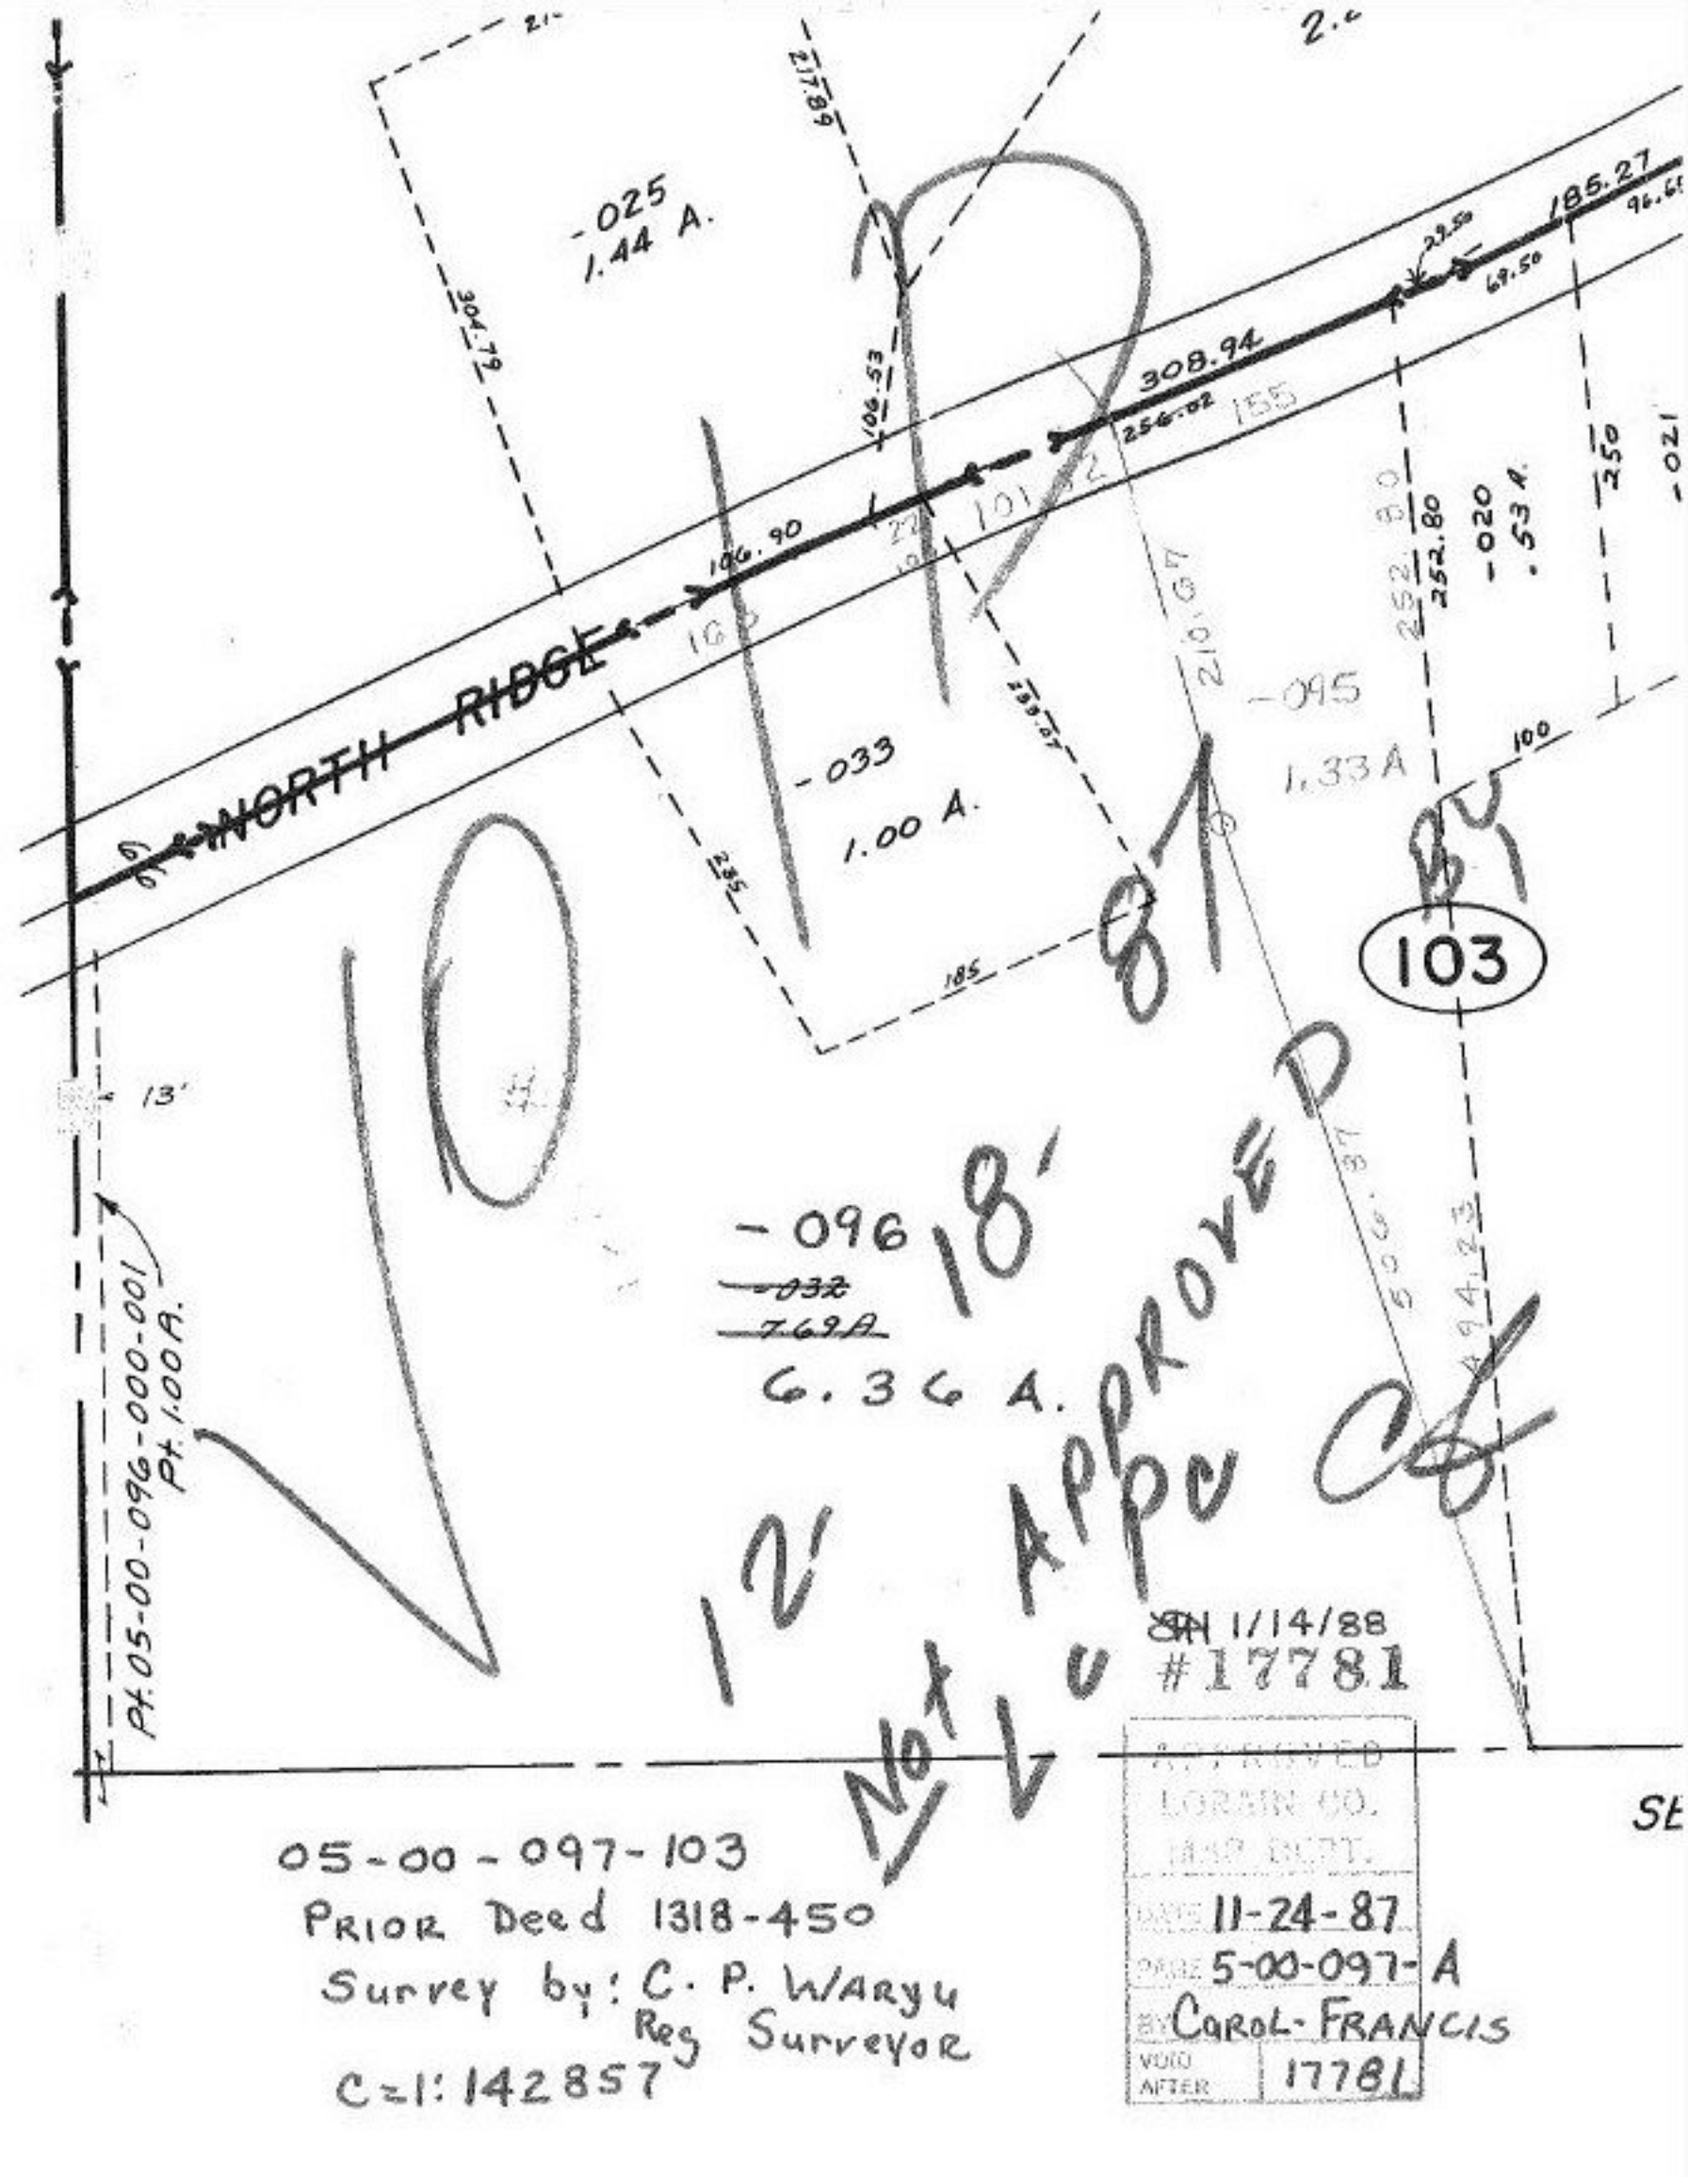

05-00-097-103
PRIOR Deed 1318-450
Survey by: C. P. WARYU
Reg Surveyor
C=1: 142857

APPROVED
LORAIN CO.
MAP DEPT.
DATE 11-24-87
PARCEL 5-00-097-A
BY CAROL-FRANCIS
VOID AFTER 17781