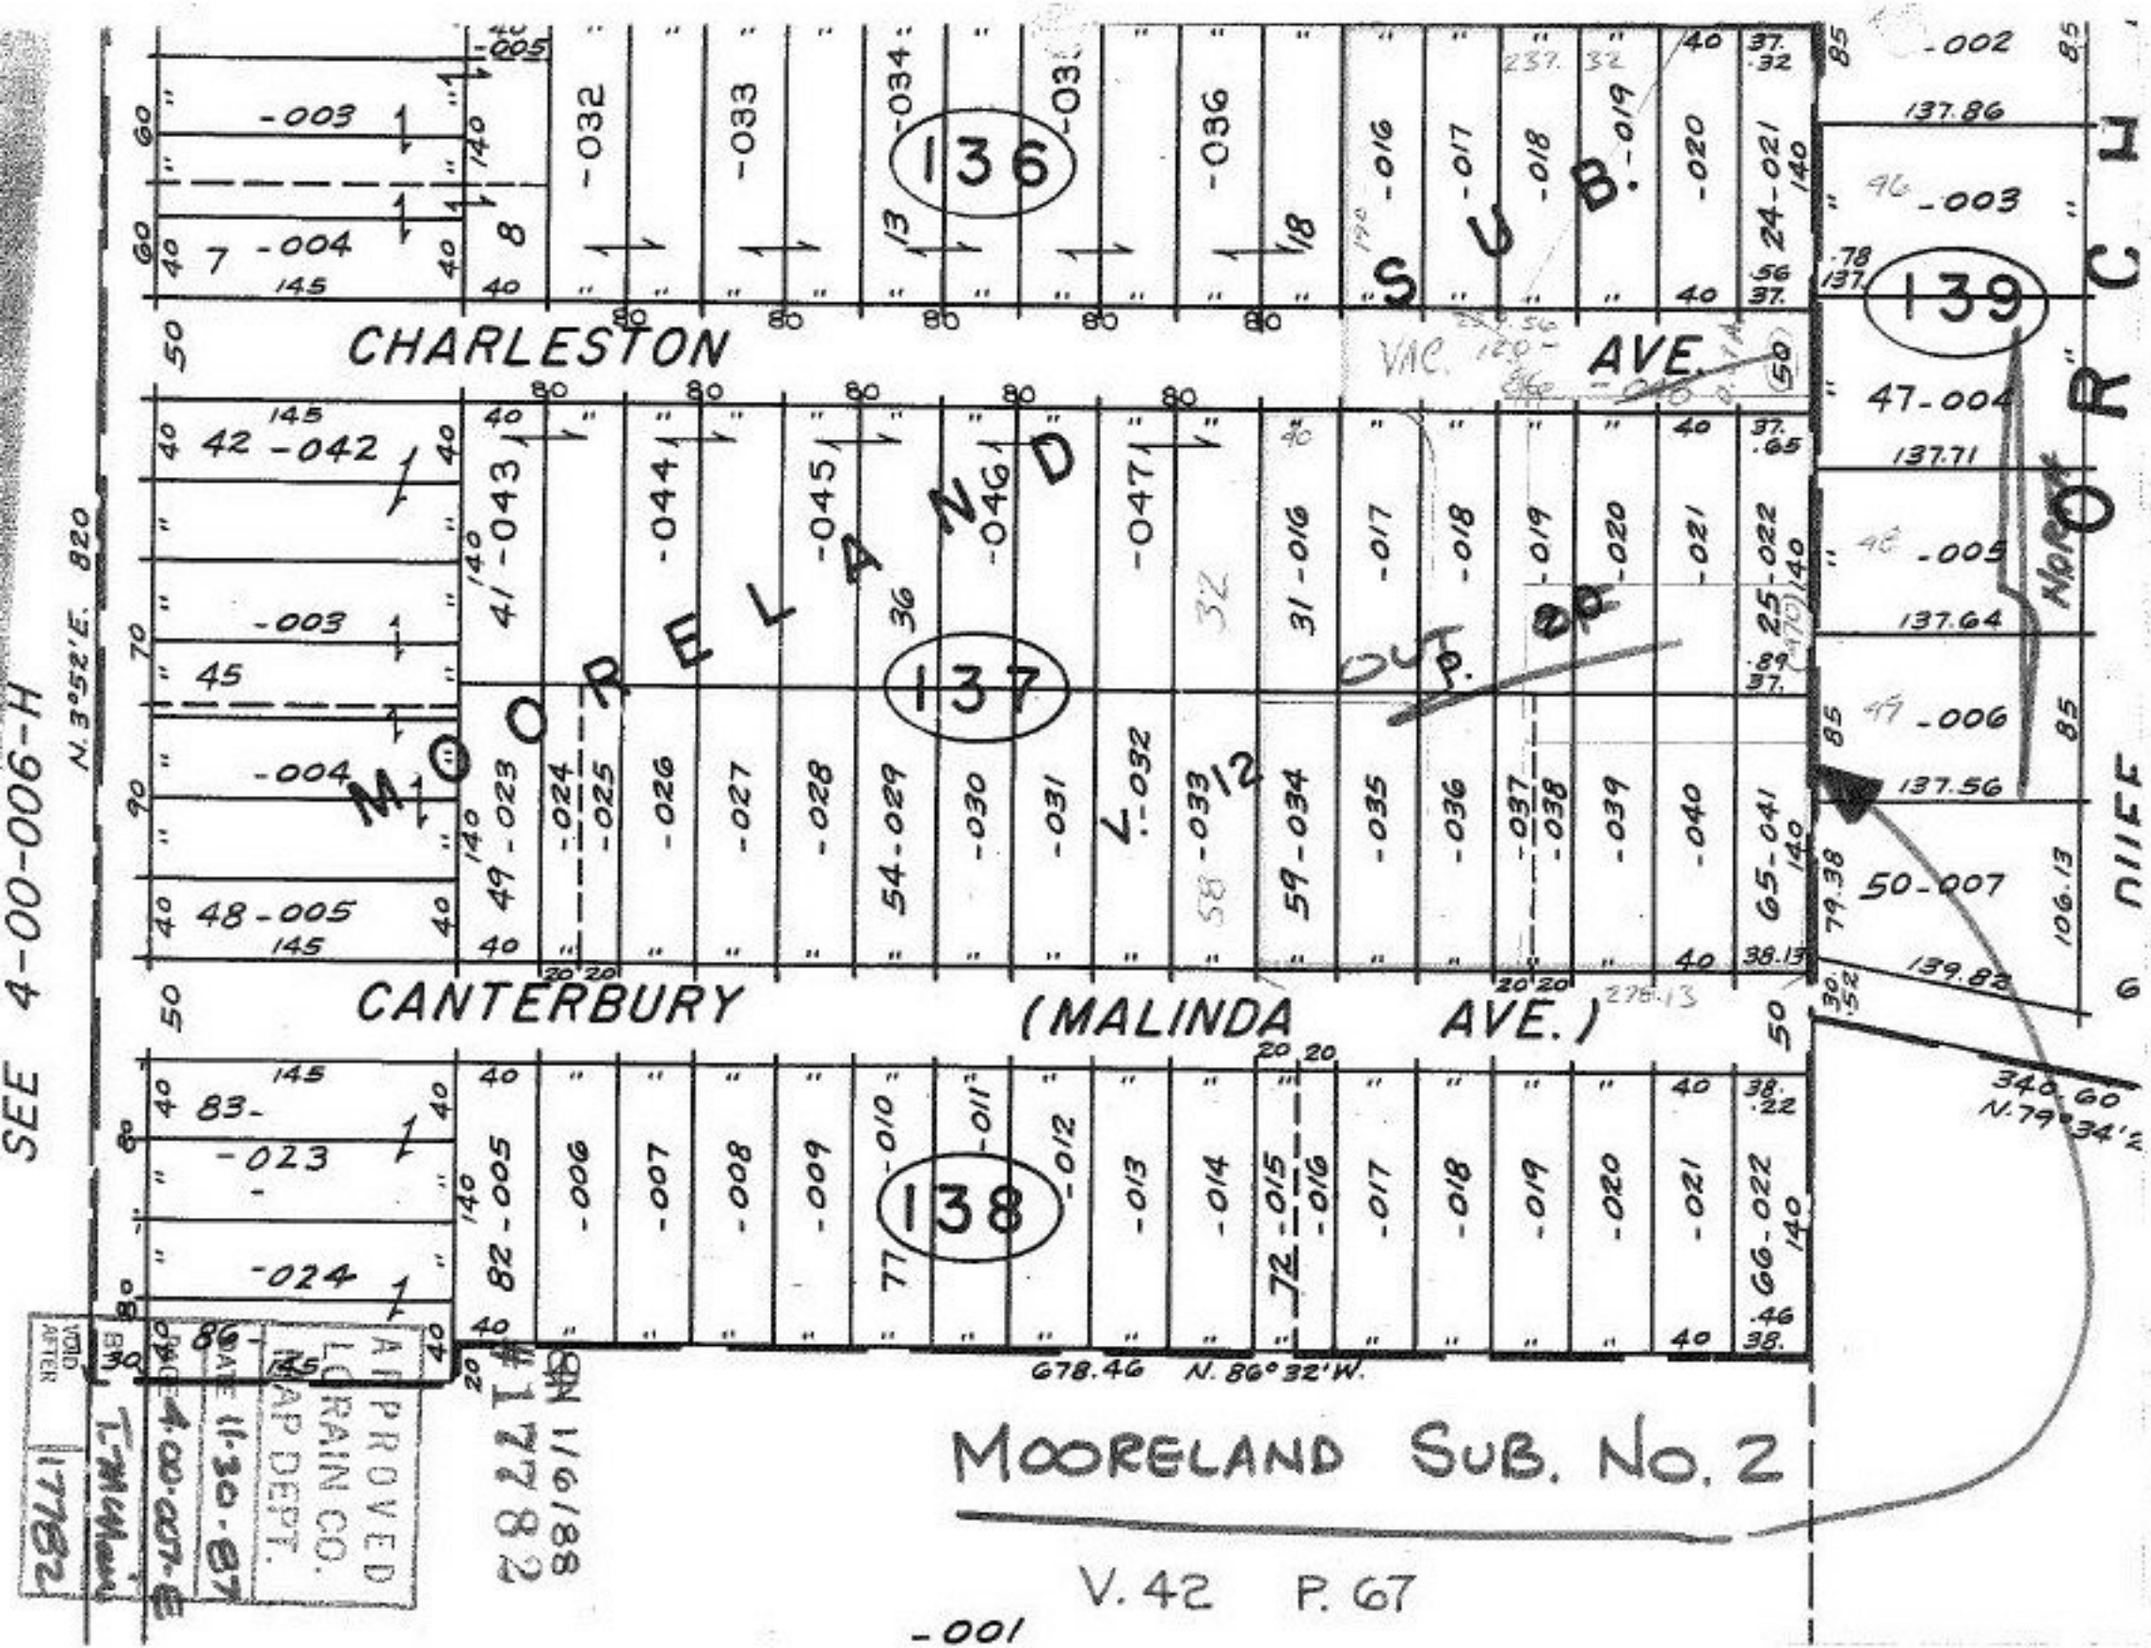

SEE 4-00-006-H
N. 3°52'E. 820
CHARLESTON AVE.
CANTERBURY (MALINDA AVE.)
MOORELAND SUB.
136
137
138
139
OUT
P. 20
V. 12
VAC.
NORTH
DIFF
678.46 N. 86°32'W.
340.60 N. 79°34'2
MOORELAND SUB. No. 2
V. 42 P. 67
-001
APPROVED
LORAIN CO.
MAP DEPT.
DATE 11-30-87
PAGE 4-00-007-E
BY T. McMain
VOID AFTER 17782
#17782