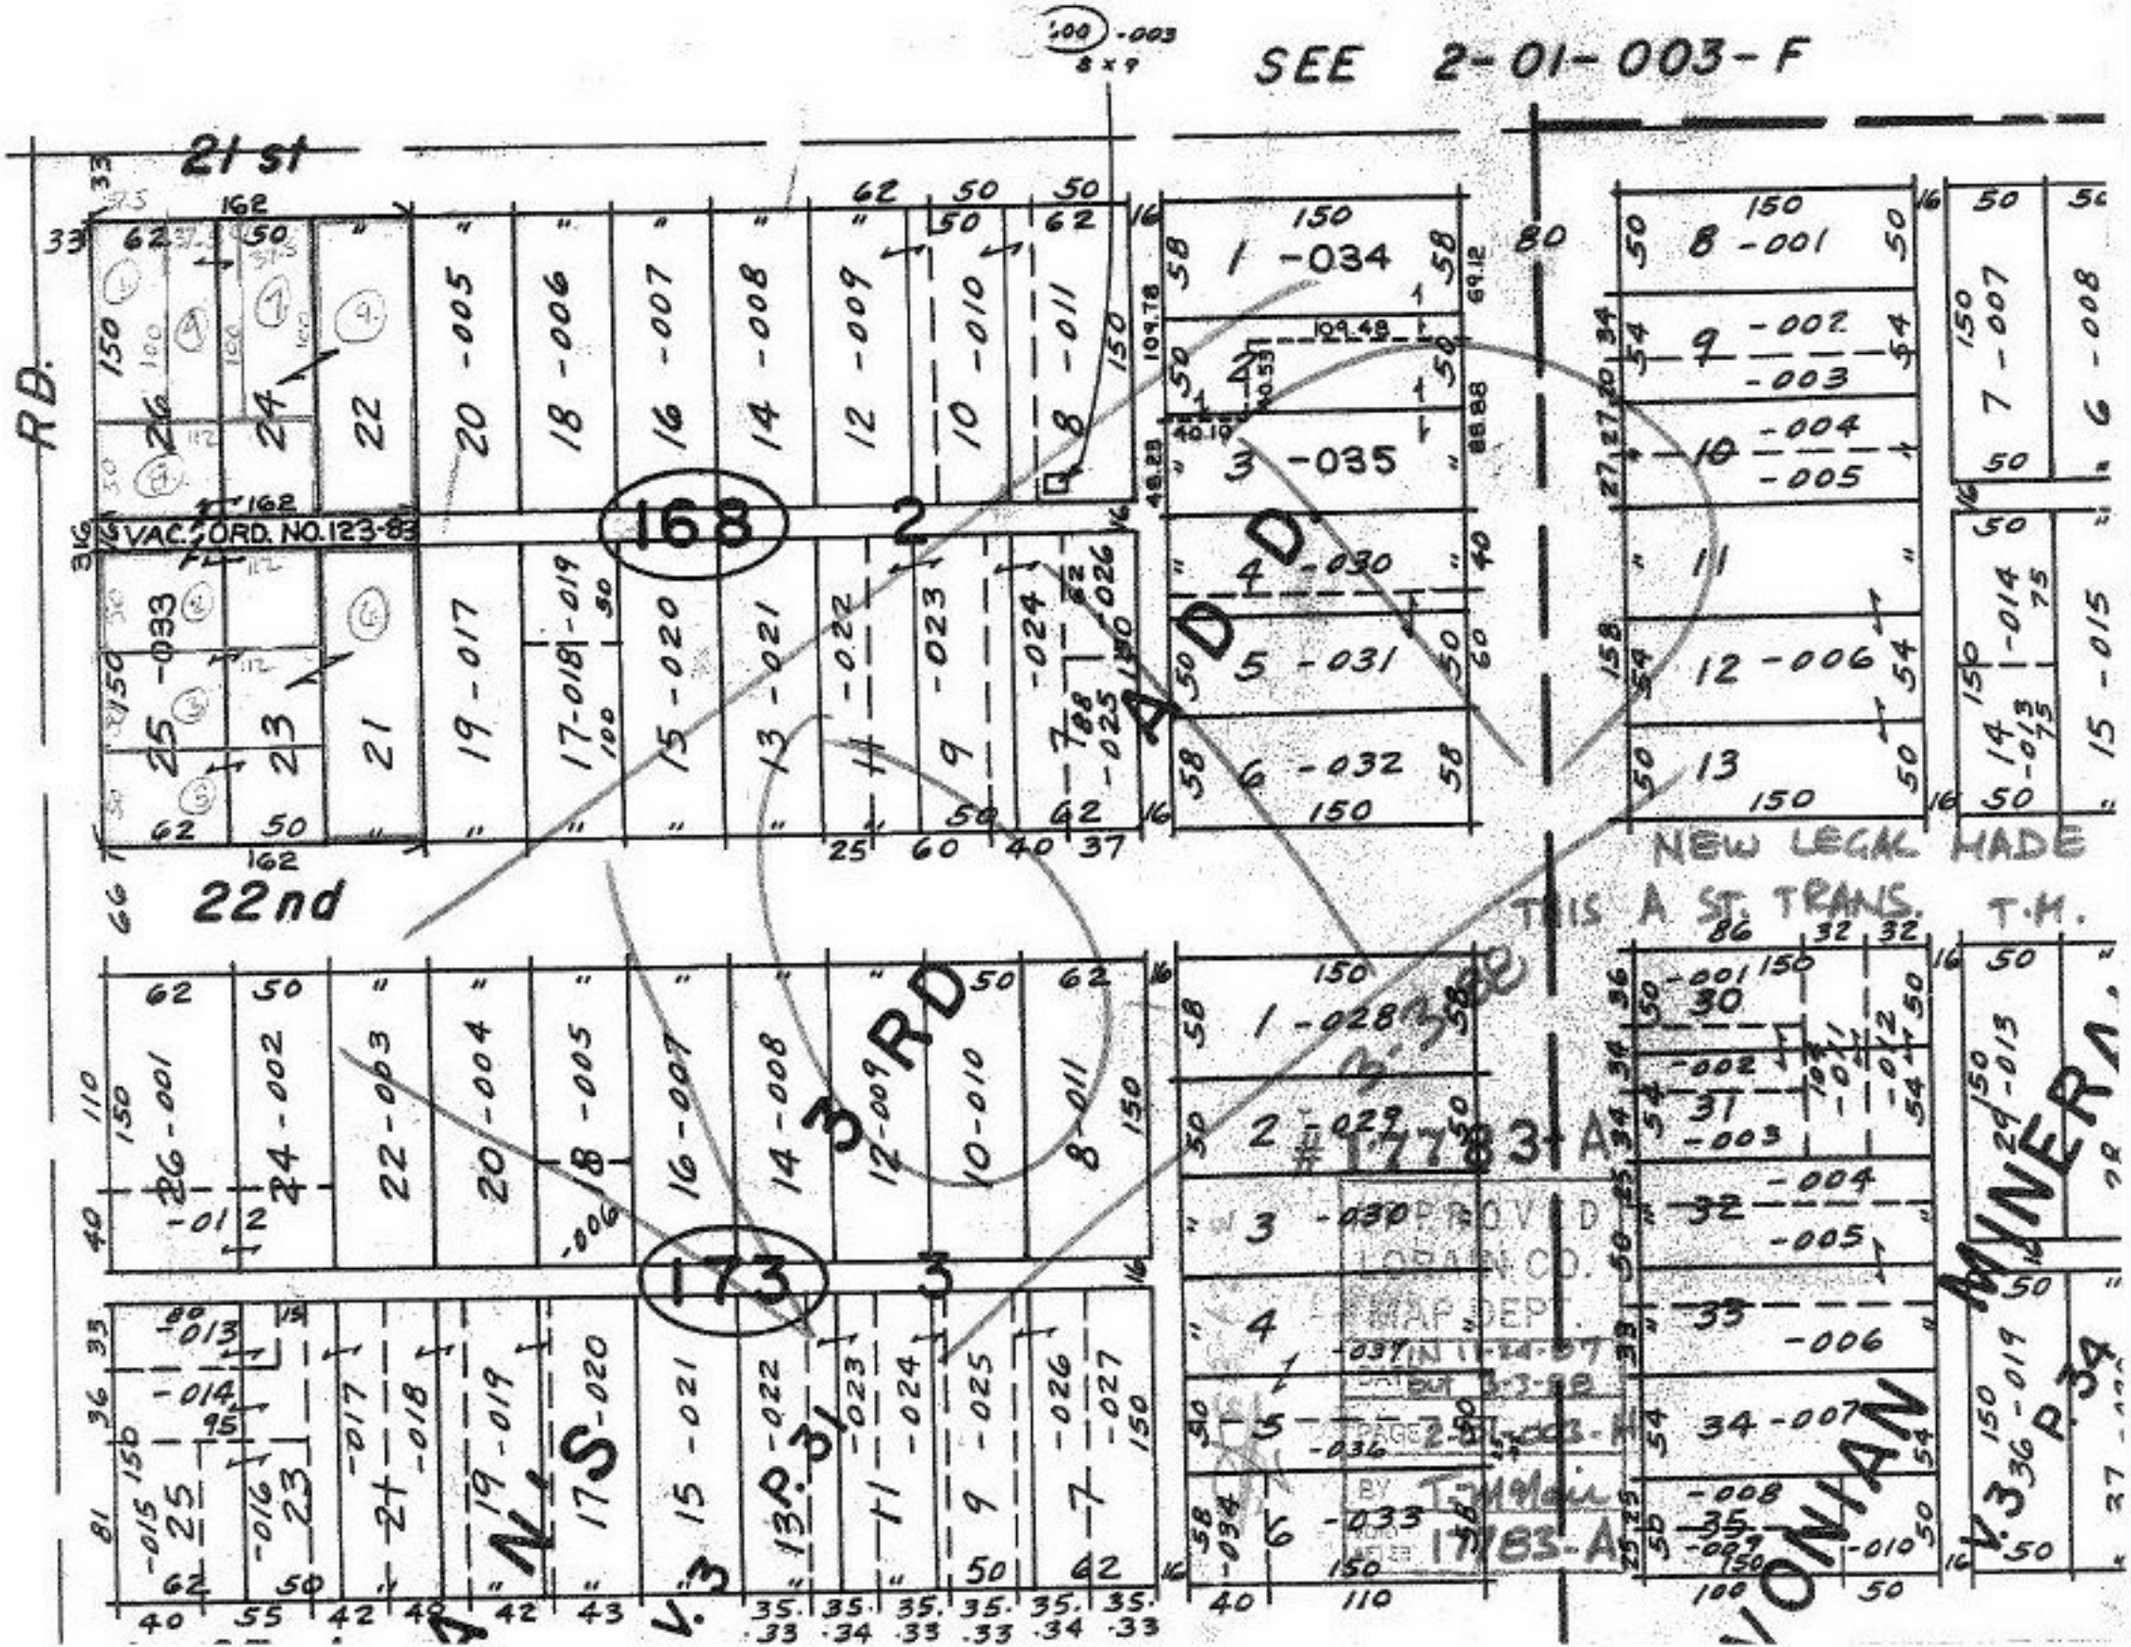
SEE 2-01-003-F
21st
22nd
RD.
VAC. ORD. NO. 123-83
168
173
2
3
AD
ADD
3RD
NEW LEGAL MADE
THIS A ST. TRANS.
T.H.
MINERA
APPROVED
LORAIN CO.
MAP DEPT.
BY
17783-A