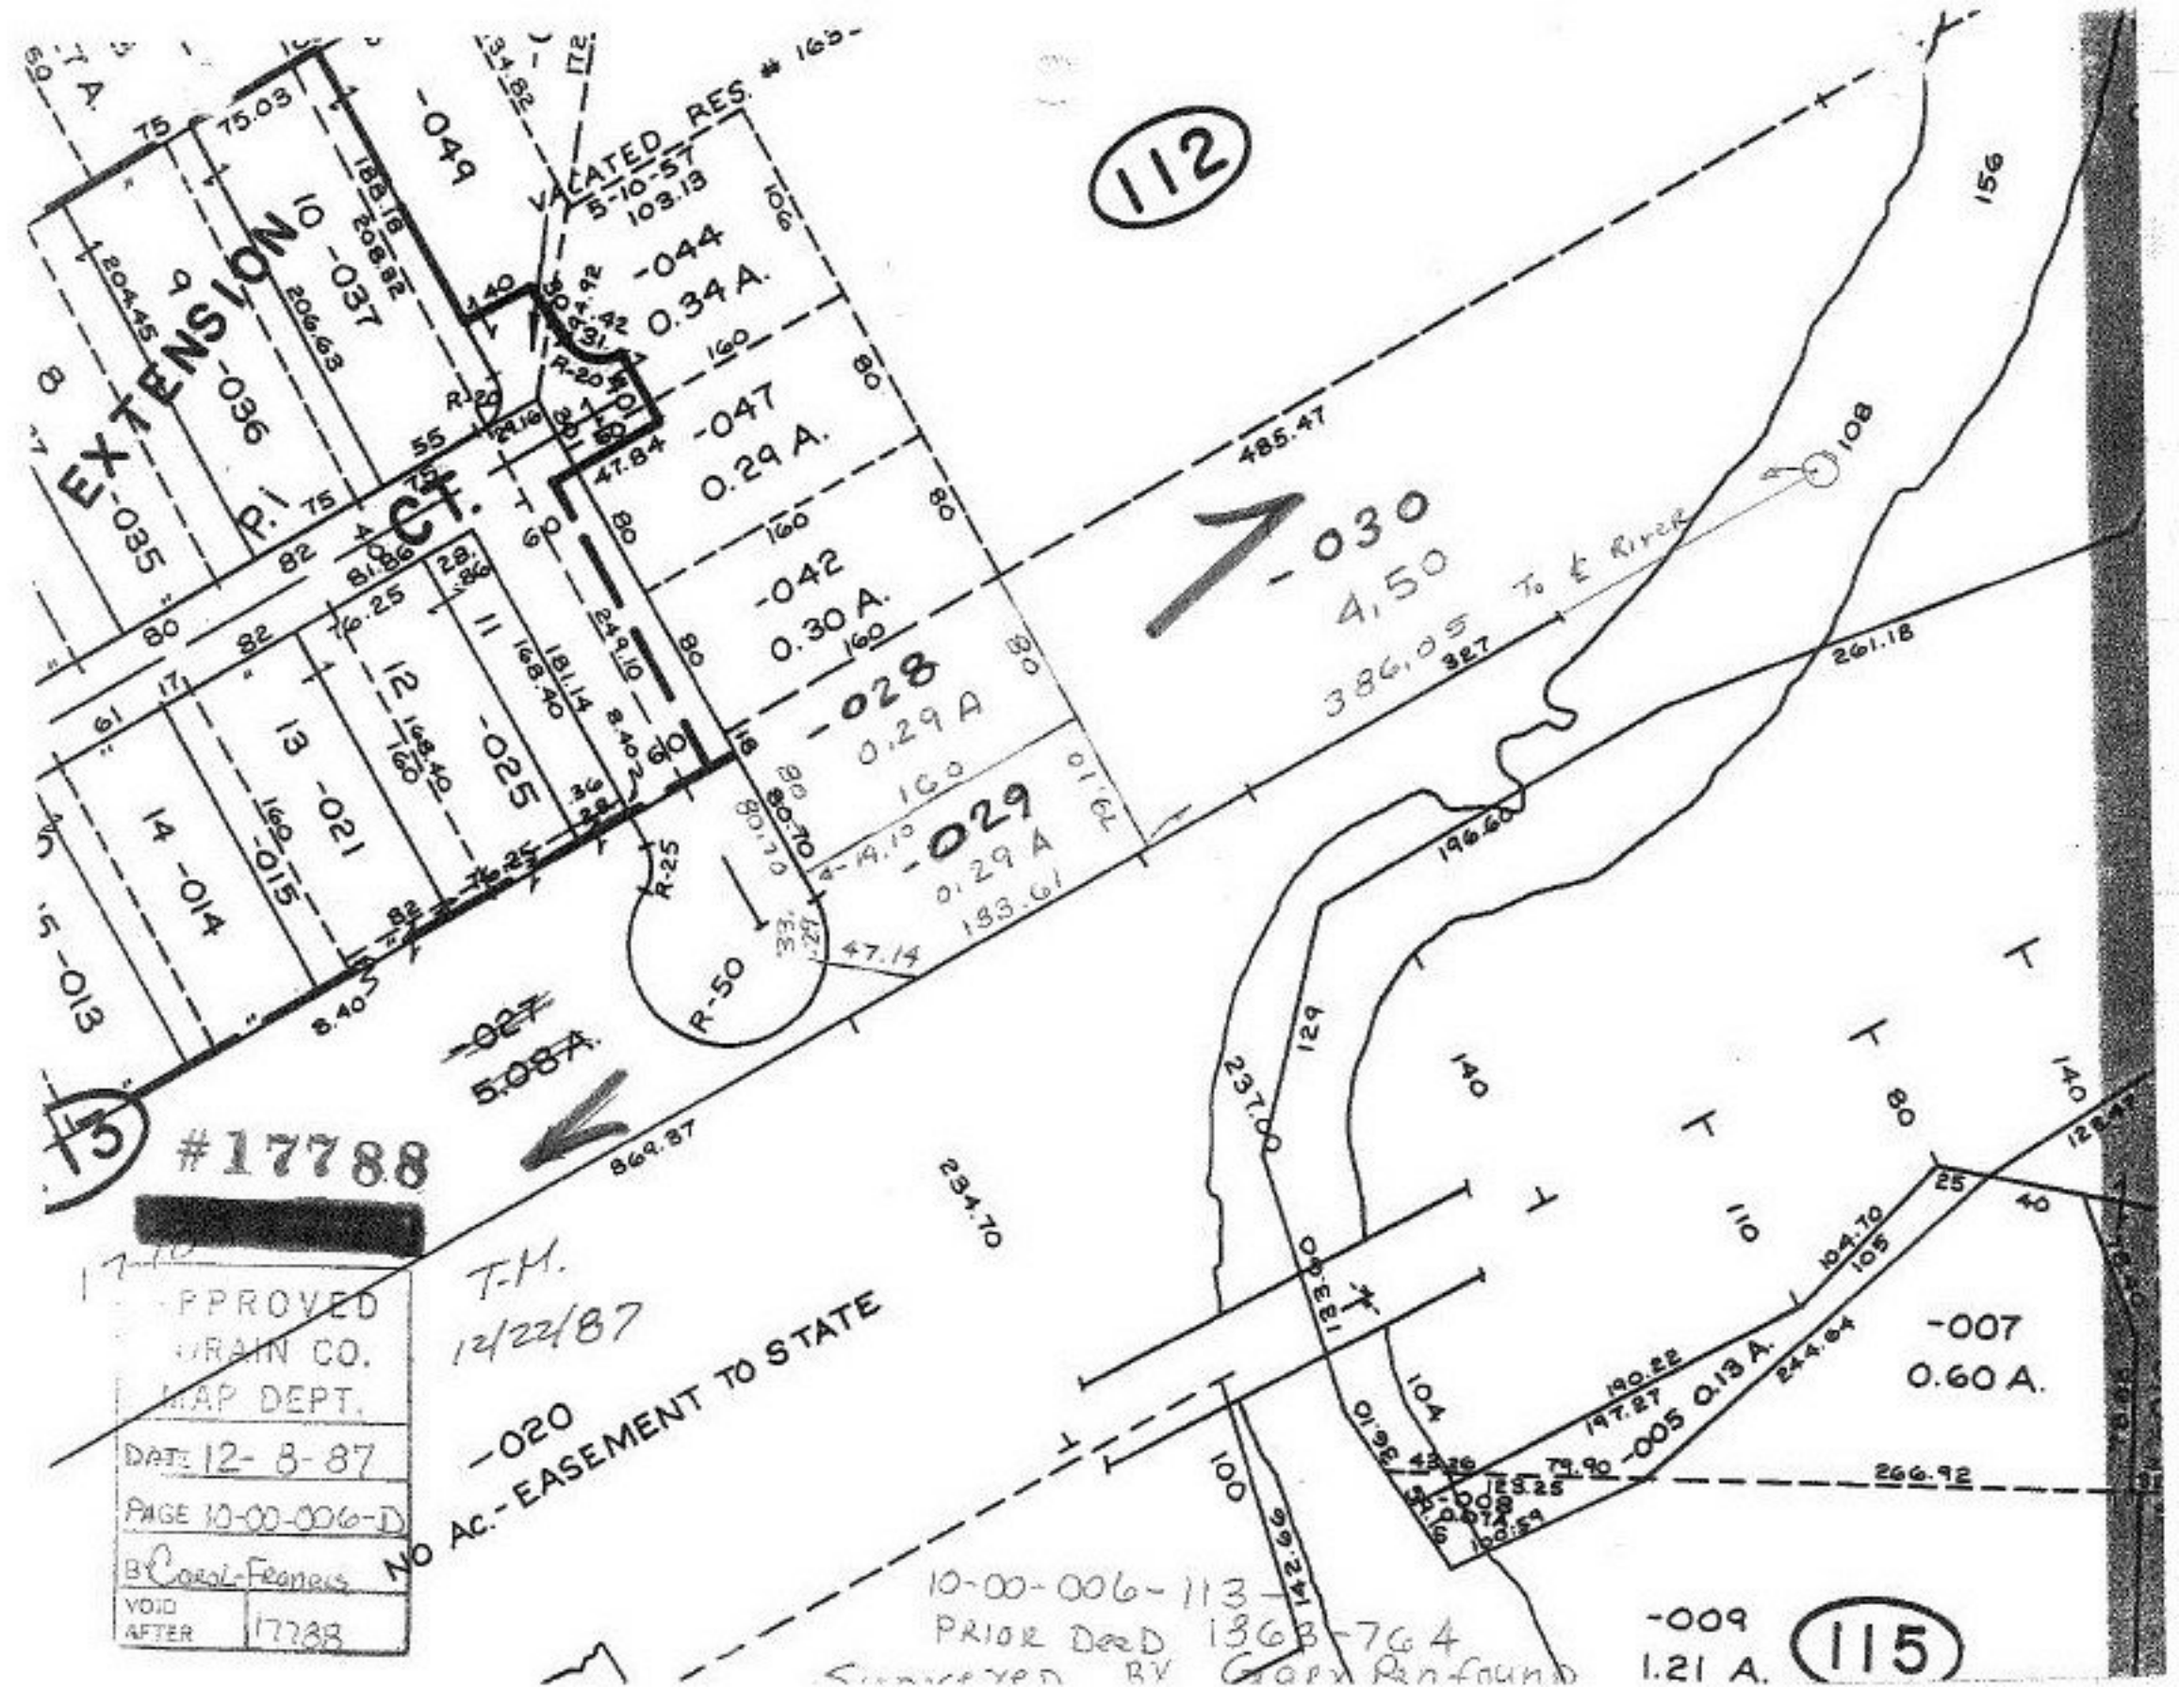
112
EXTENSION
CT.
-049
-037
-036
-035
-044
0.34 A.
-047
0.29 A.
-042
0.30 A.
-028
0.29 A
-029
0.29 A
-030
4.50
386.05
-025
-021
-015
-014
-013
-027
5.08 A.
-020
NO AC.-EASEMENT TO STATE
-007
0.60 A.
-005 0.13 A.
-008
-009
1.21 A.
115
#17788
APPROVED
MAP DEPT.
DATE 12-8-87
PAGE 10-00-006-D
BY Carol-Frances
VOID AFTER 17788
T.M.
12/22/87
10-00-006-113
PRIOR DEED 1368-764
SURVEYED BY Gary Benfound