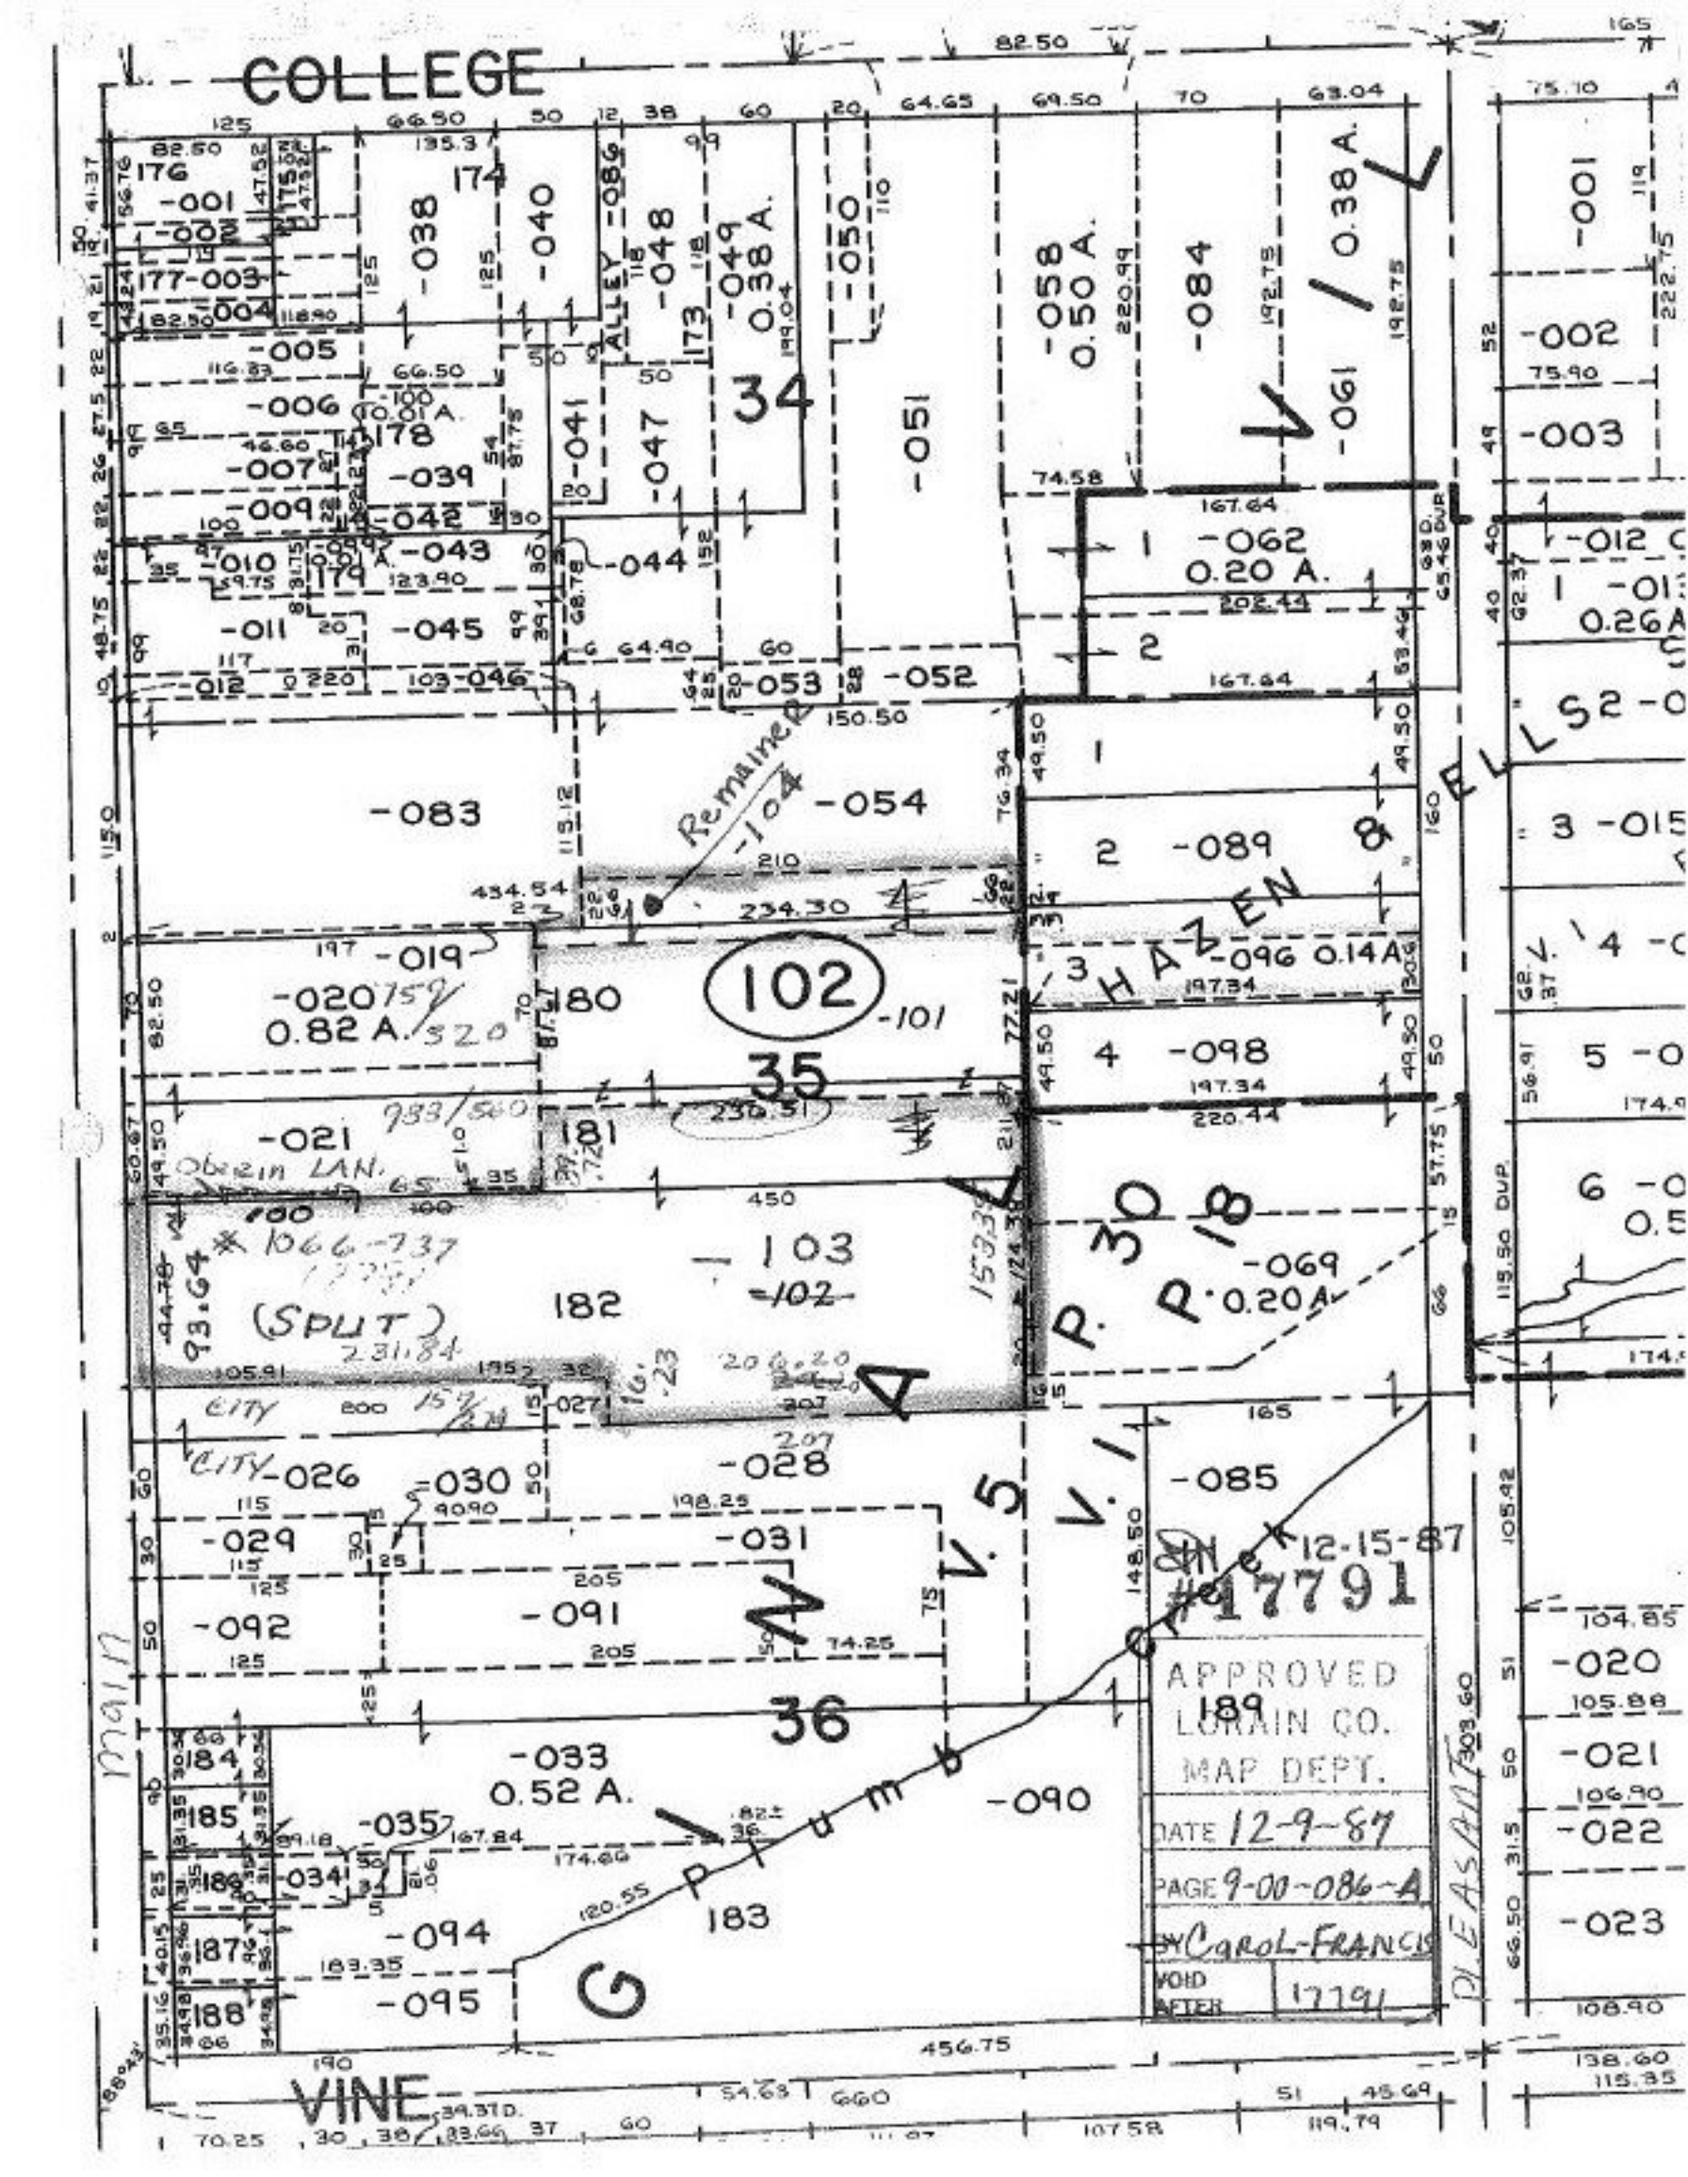
COLLEGE
VINE
Main
HAZEN & ELLS
GRAND
PLEASANT
Plumb Creek
Remainder
102
35
34
36
Obrein LAN.
(SPLIT)
CITY
ALLEY
APPROVED
LORAIN CO.
MAP DEPT.
DATE 12-9-87
PAGE 9-00-086-A
BY Carol-Francis
VOID AFTER 17791
12-15-87
#17791