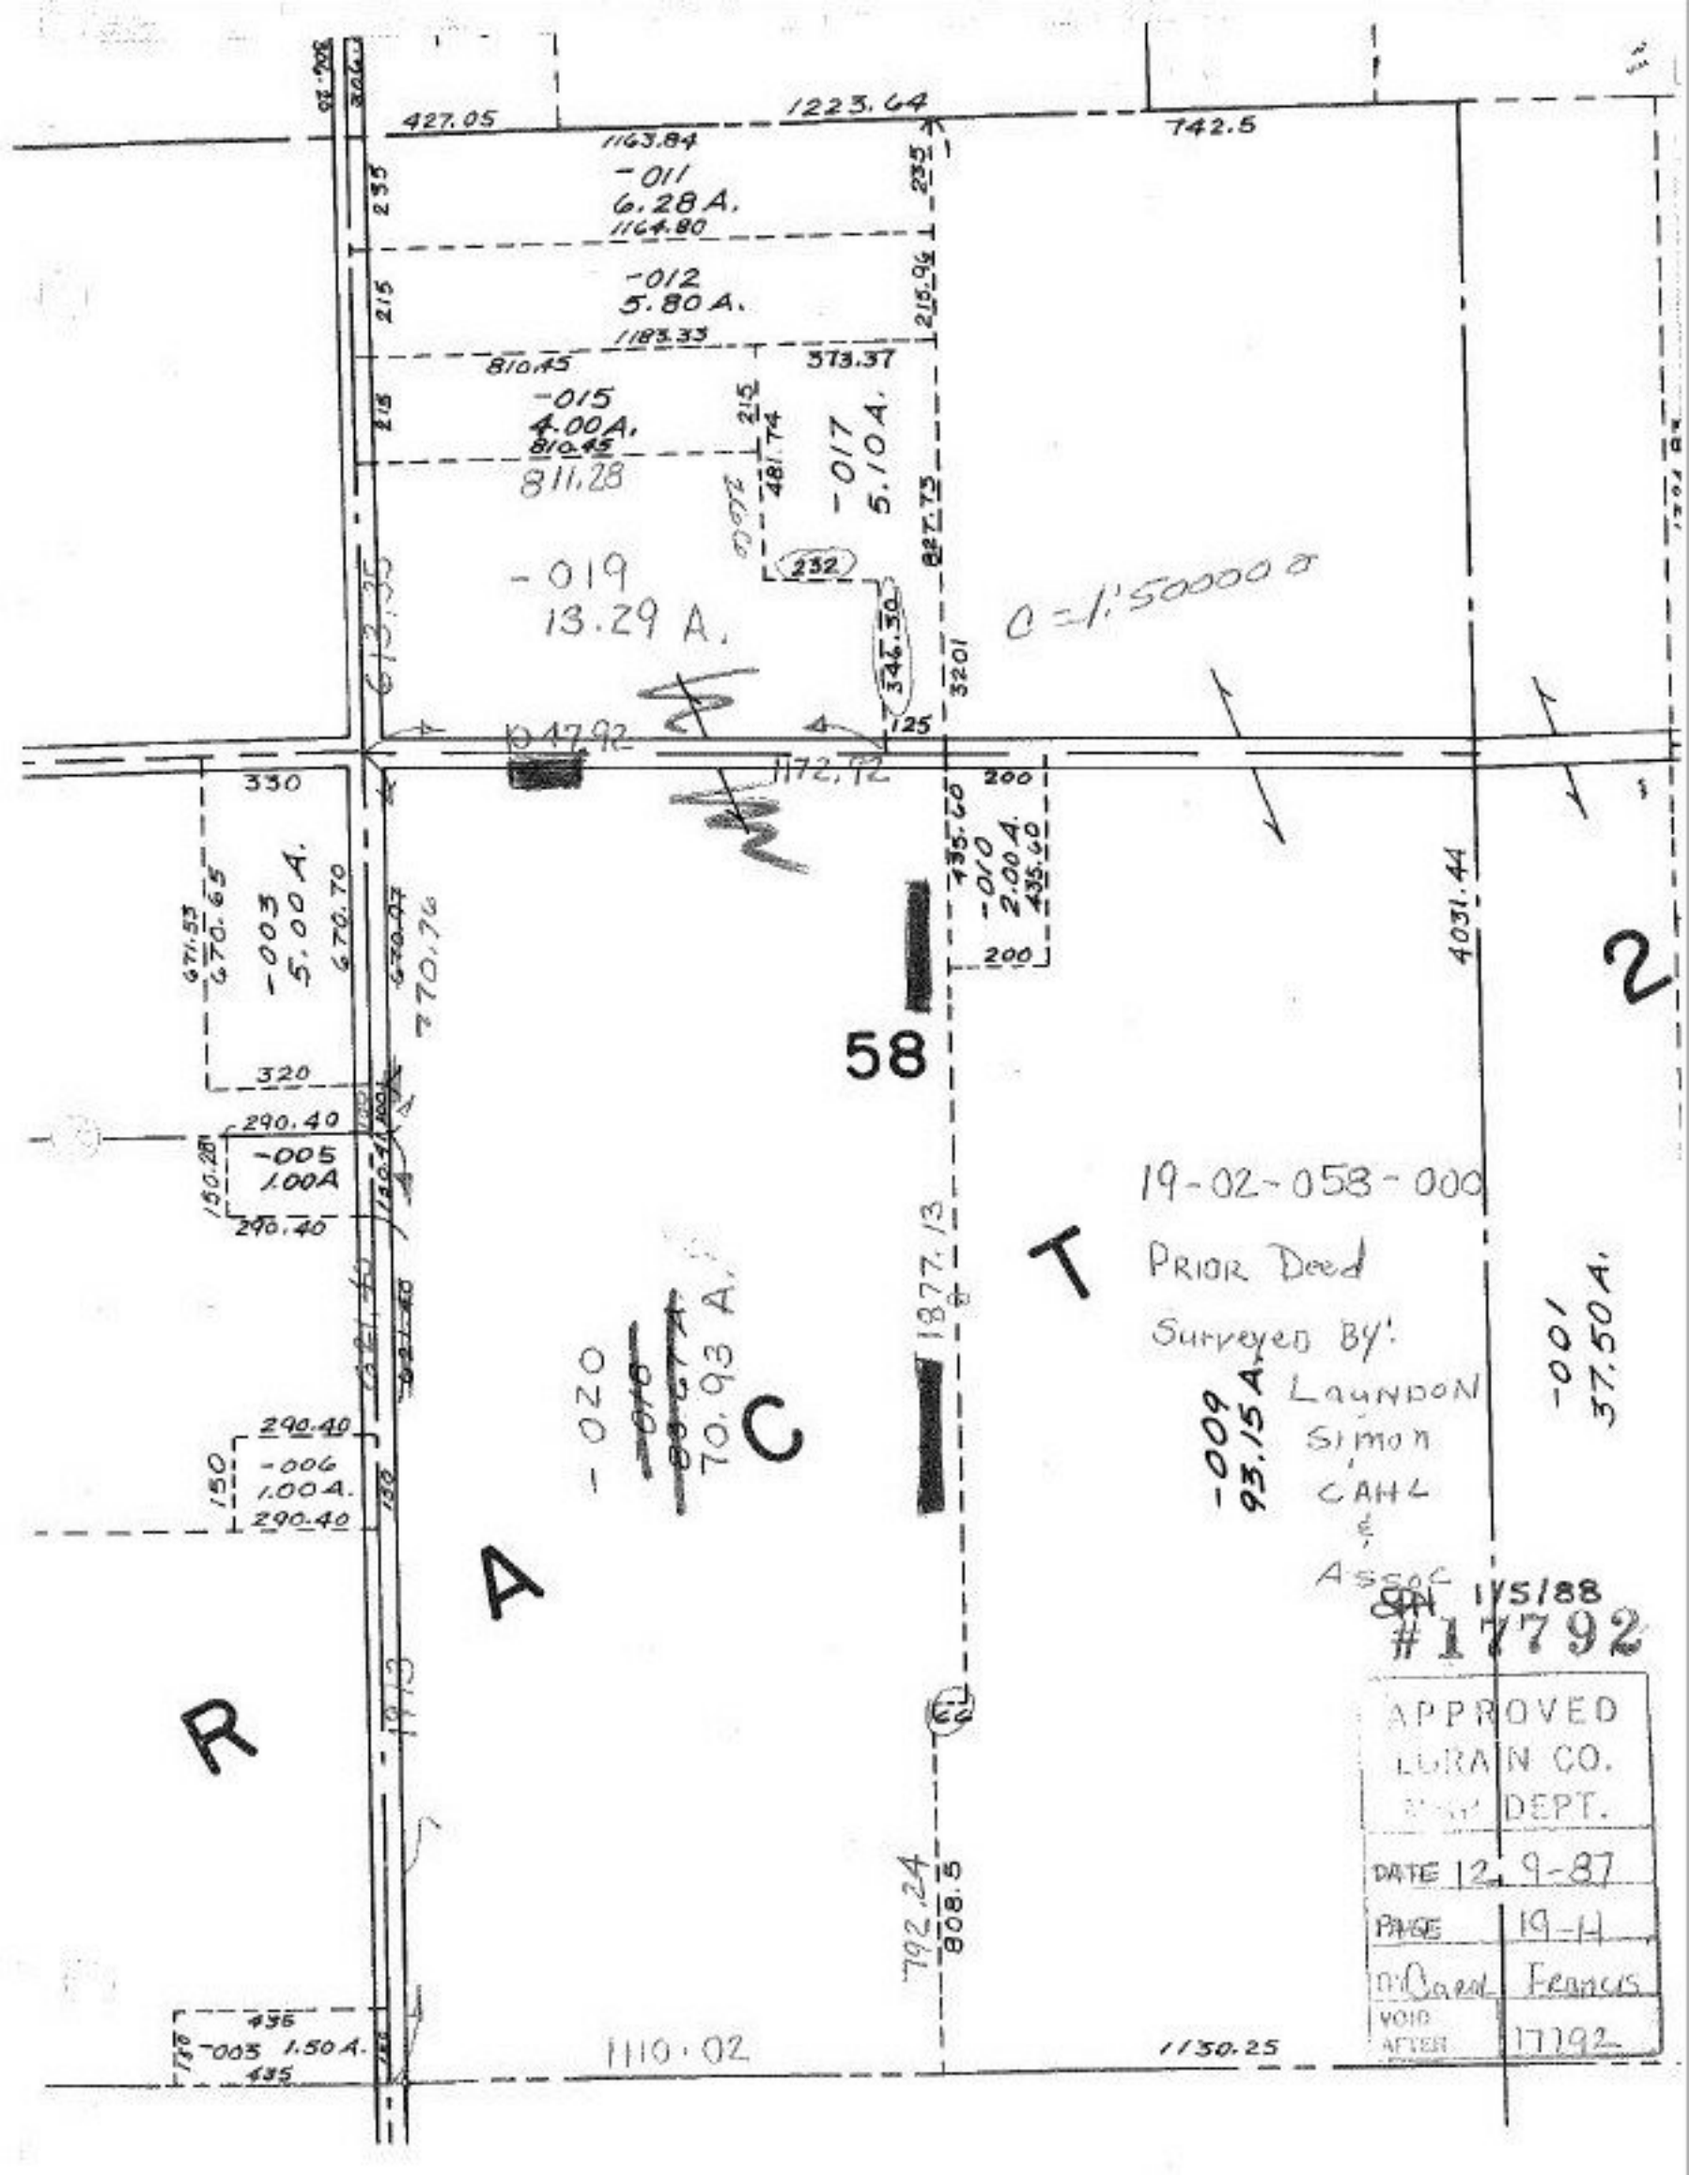
427.05
1223.64
742.5
1163.84
-011
6.28 A.
1164.80
-012
5.80 A.
1183.33
810.45
573.37
-015
4.00 A.
810.45
811.28
-017
5.10 A.
827.73
-019
13.29 A.
C=1'50000
1172.72
330
-003
5.00 A.
320
290.40
-005
1.00 A
290.40
-010
2.00 A.
435.60
4031.44
58
19-02-058-000
PRIOR Deed
Surveyed By:
LAUNDON
SIMON
CAHL
&
ASSOC
-009
93.15 A.
-001
37.50 A.
-020
70.93 A.
1877.13
1110.02
1130.25
792.24
808.5
-006
1.00 A.
290.40
-005 1.50 A.
435
1/5/88
#17792
APPROVED
LORAIN CO.
ENG. DEPT.
DATE 12-9-87
PAGE 19-H
DRAWN Frances
VOID AFTER 17792