Ac. Corr. per survey
John Pozywak
Cl. 1: 125,000
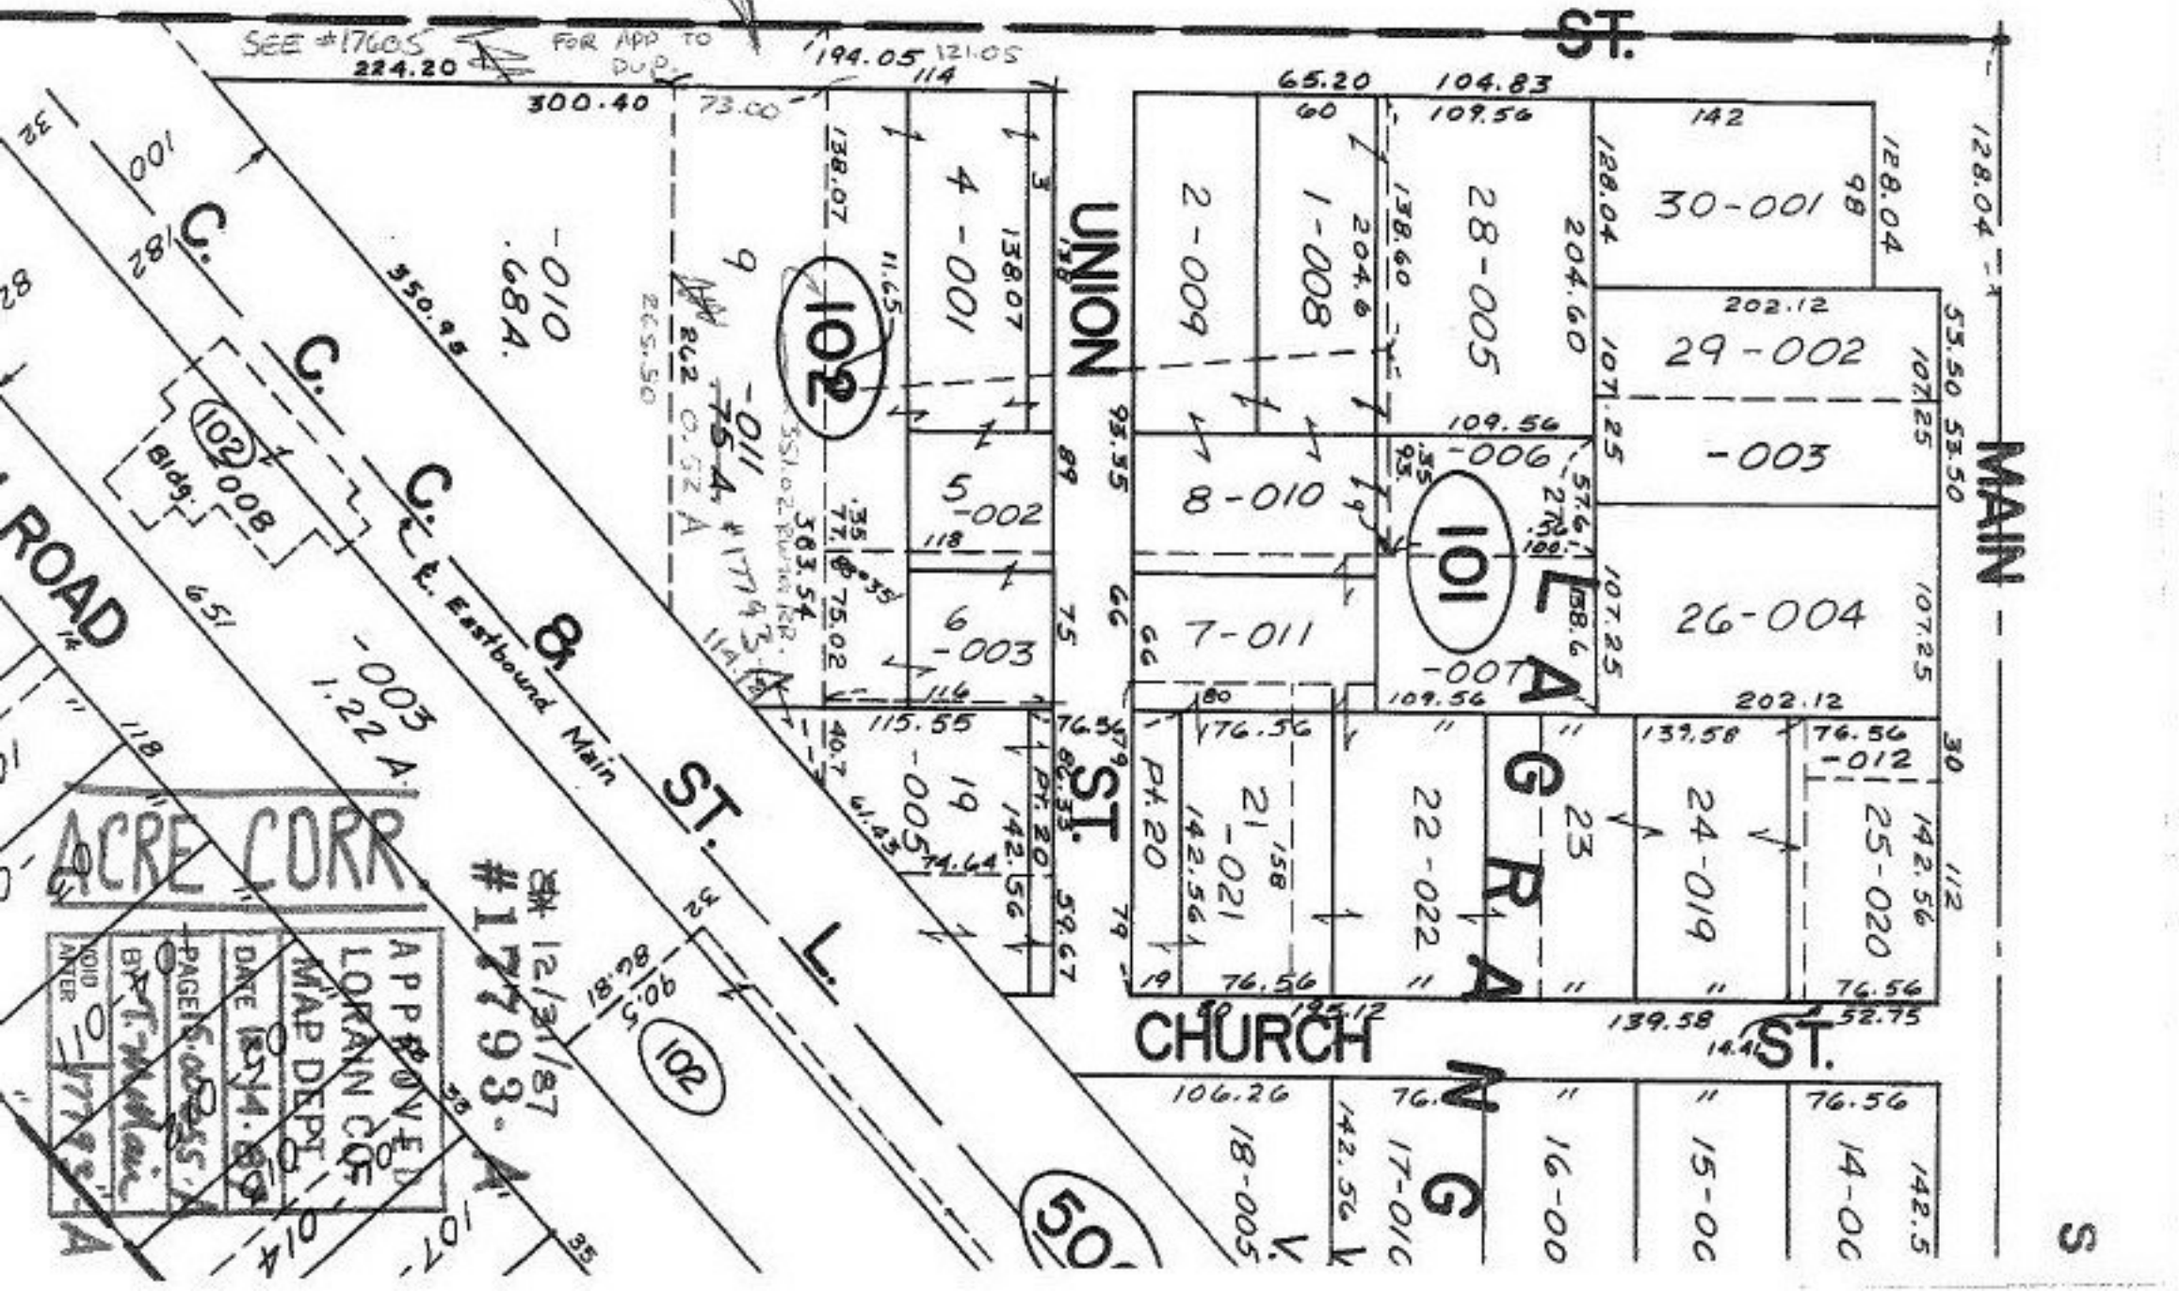
REFERENCE —
AFFIDAVIT OF CORRECTION BEING PUT OF RECORD TO CHANGE ACRE. SEE D.V. 457/655 & SURVIVORSHIP DEED DATED 2/3/73