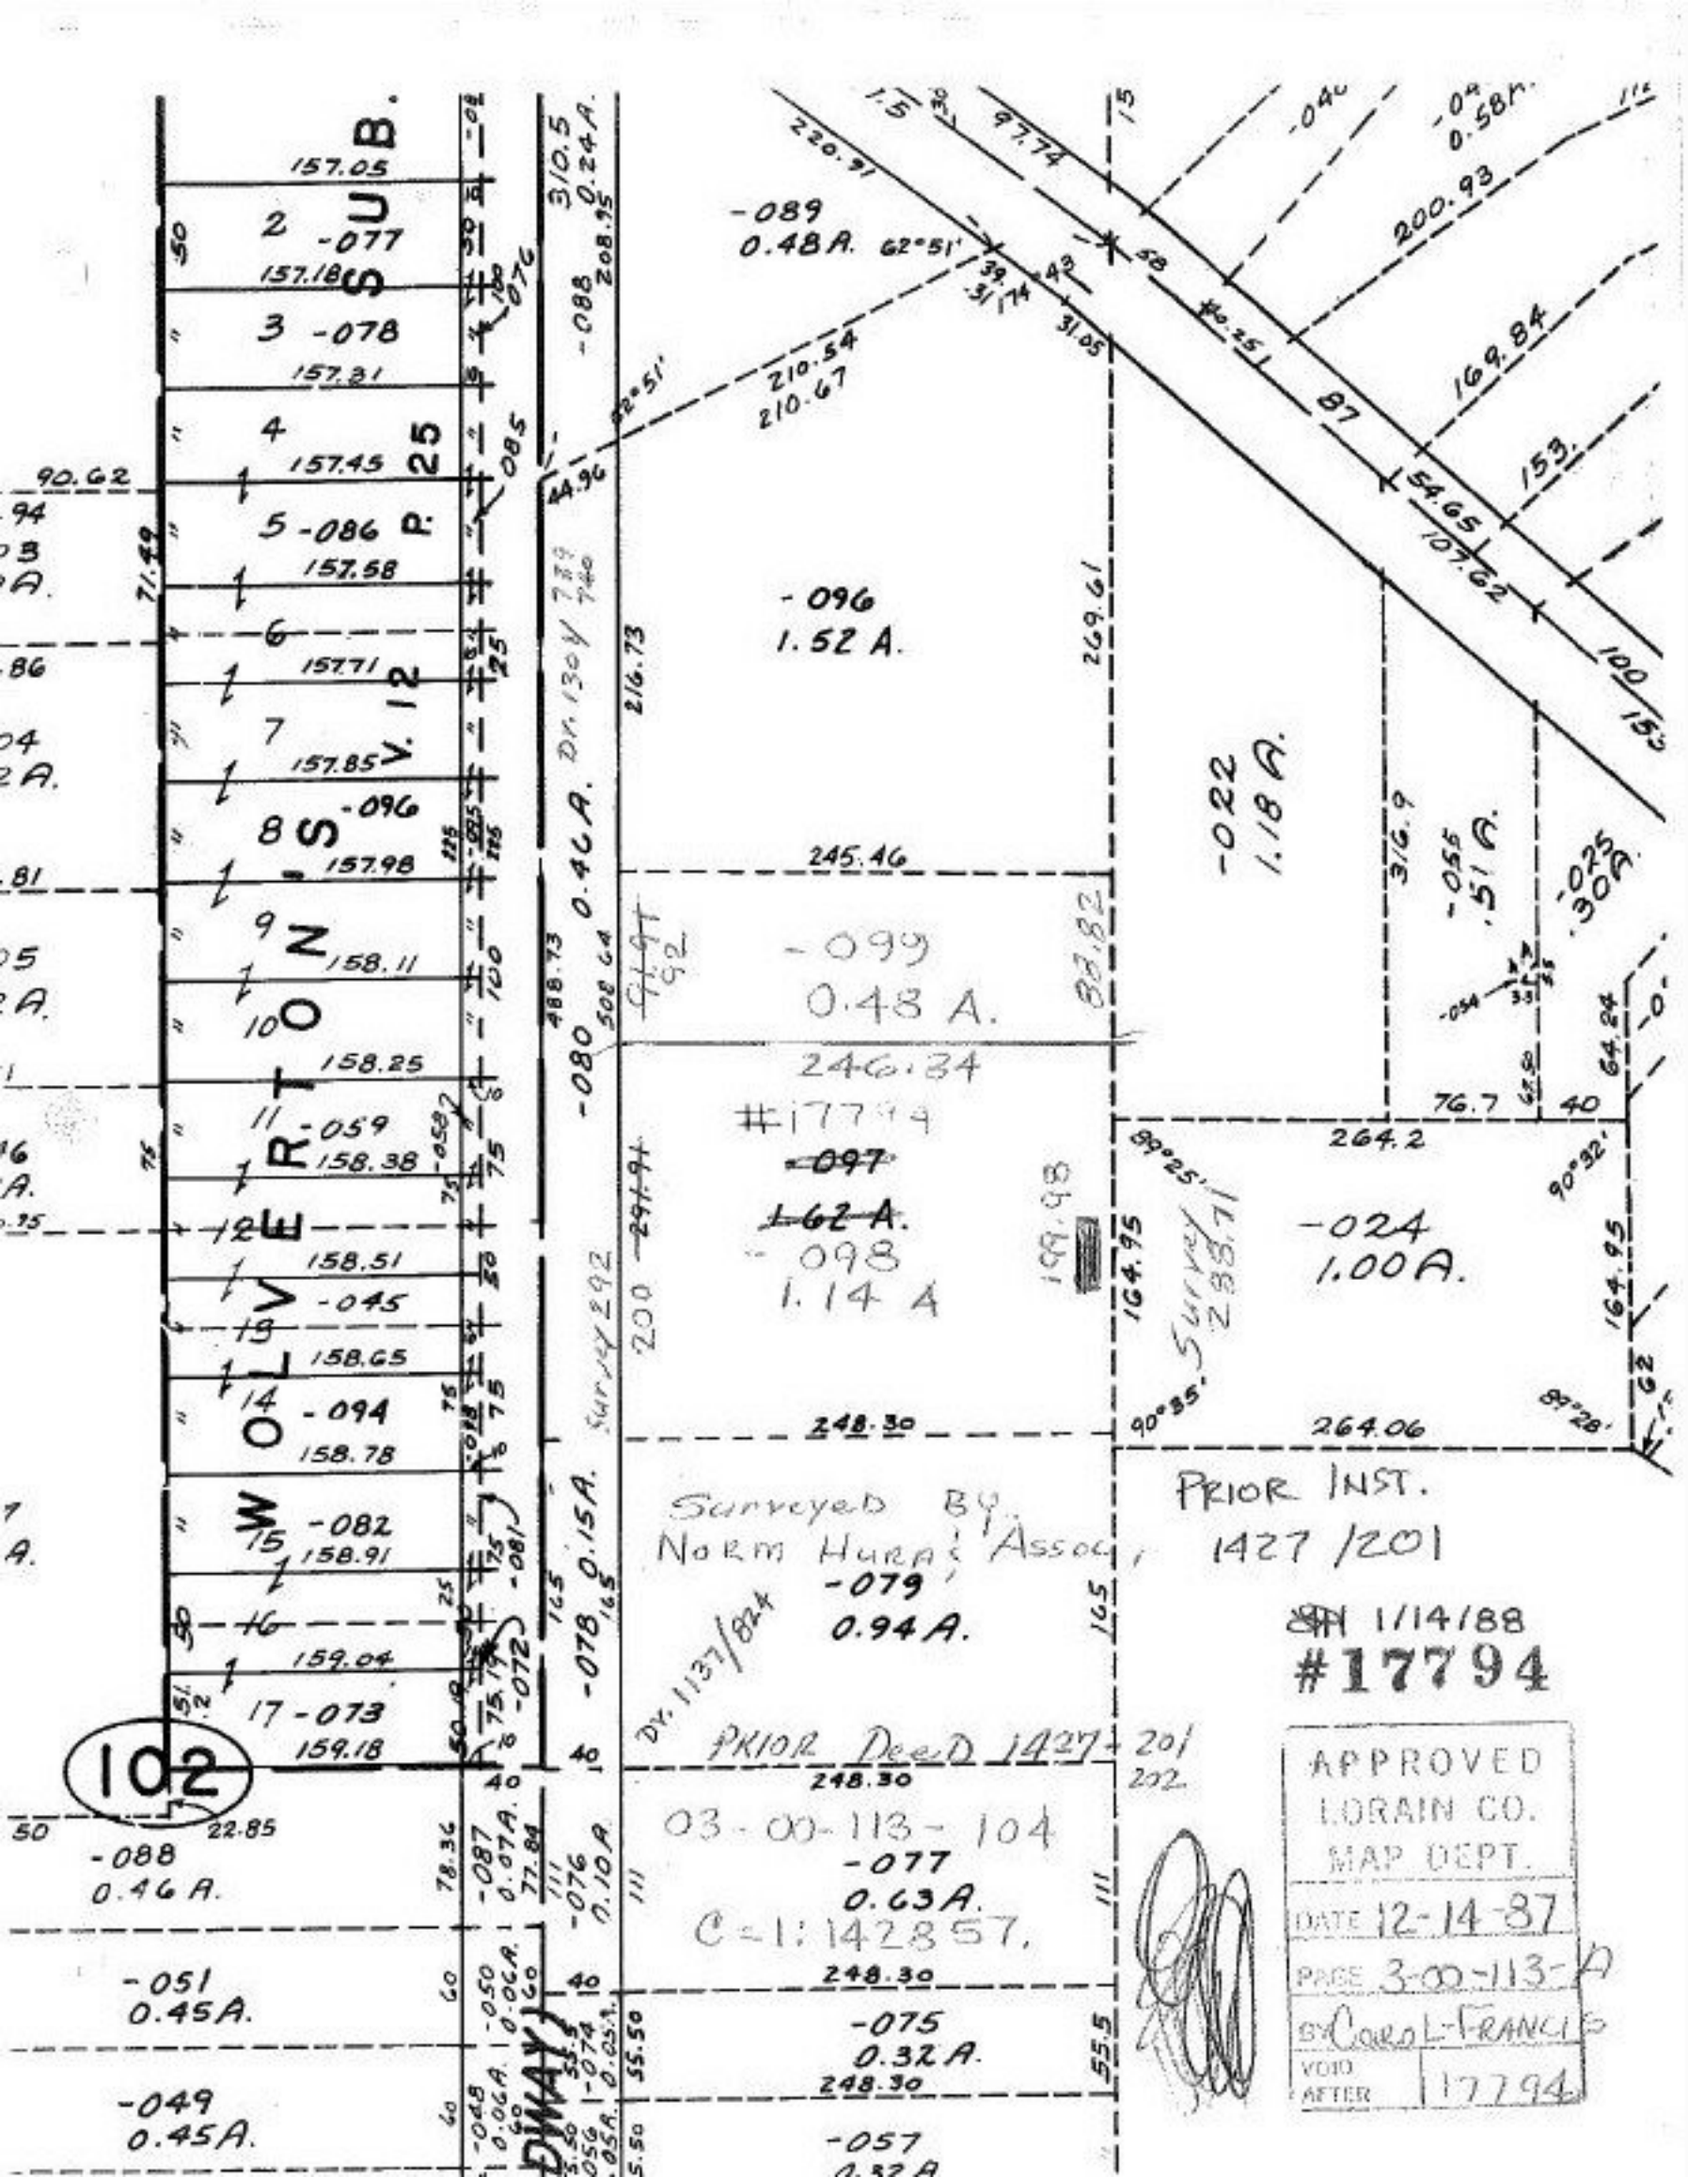

WOLVERTON'S SUB.
V. 12 P. 25
2 -077
3 -078
4
5 -086
6
7
8 -096
9
10
11 -059
12
13 -045
14 -094
15 -082
16
17 -073
102
-089
0.48 A.
-096
1.52 A.
-022
1.18 A.
-099
0.48 A.
246.34
#17794
-097
1.62 A.
-098
1.14 A
-024
1.00 A.
Survey 288.71
Survey 292
Surveyed By
Norm Hura & Assoc.
-079
0.94 A.
Dr. 1137/824
PRIOR Deed 1427-201
202
03-00-113-104
-077
0.63 A.
C=1:142857.
-088
0.46 A.
-051
0.45 A.
-049
0.45 A.
-075
0.32 A.
-057
PRIOR INST.
1427/201
1/14/88
#17794
APPROVED
LORAIN CO.
MAP DEPT.
DATE 12-14-87
PAGE 3-00-113-A
BY Carol L. Francis
VOID AFTER 17794