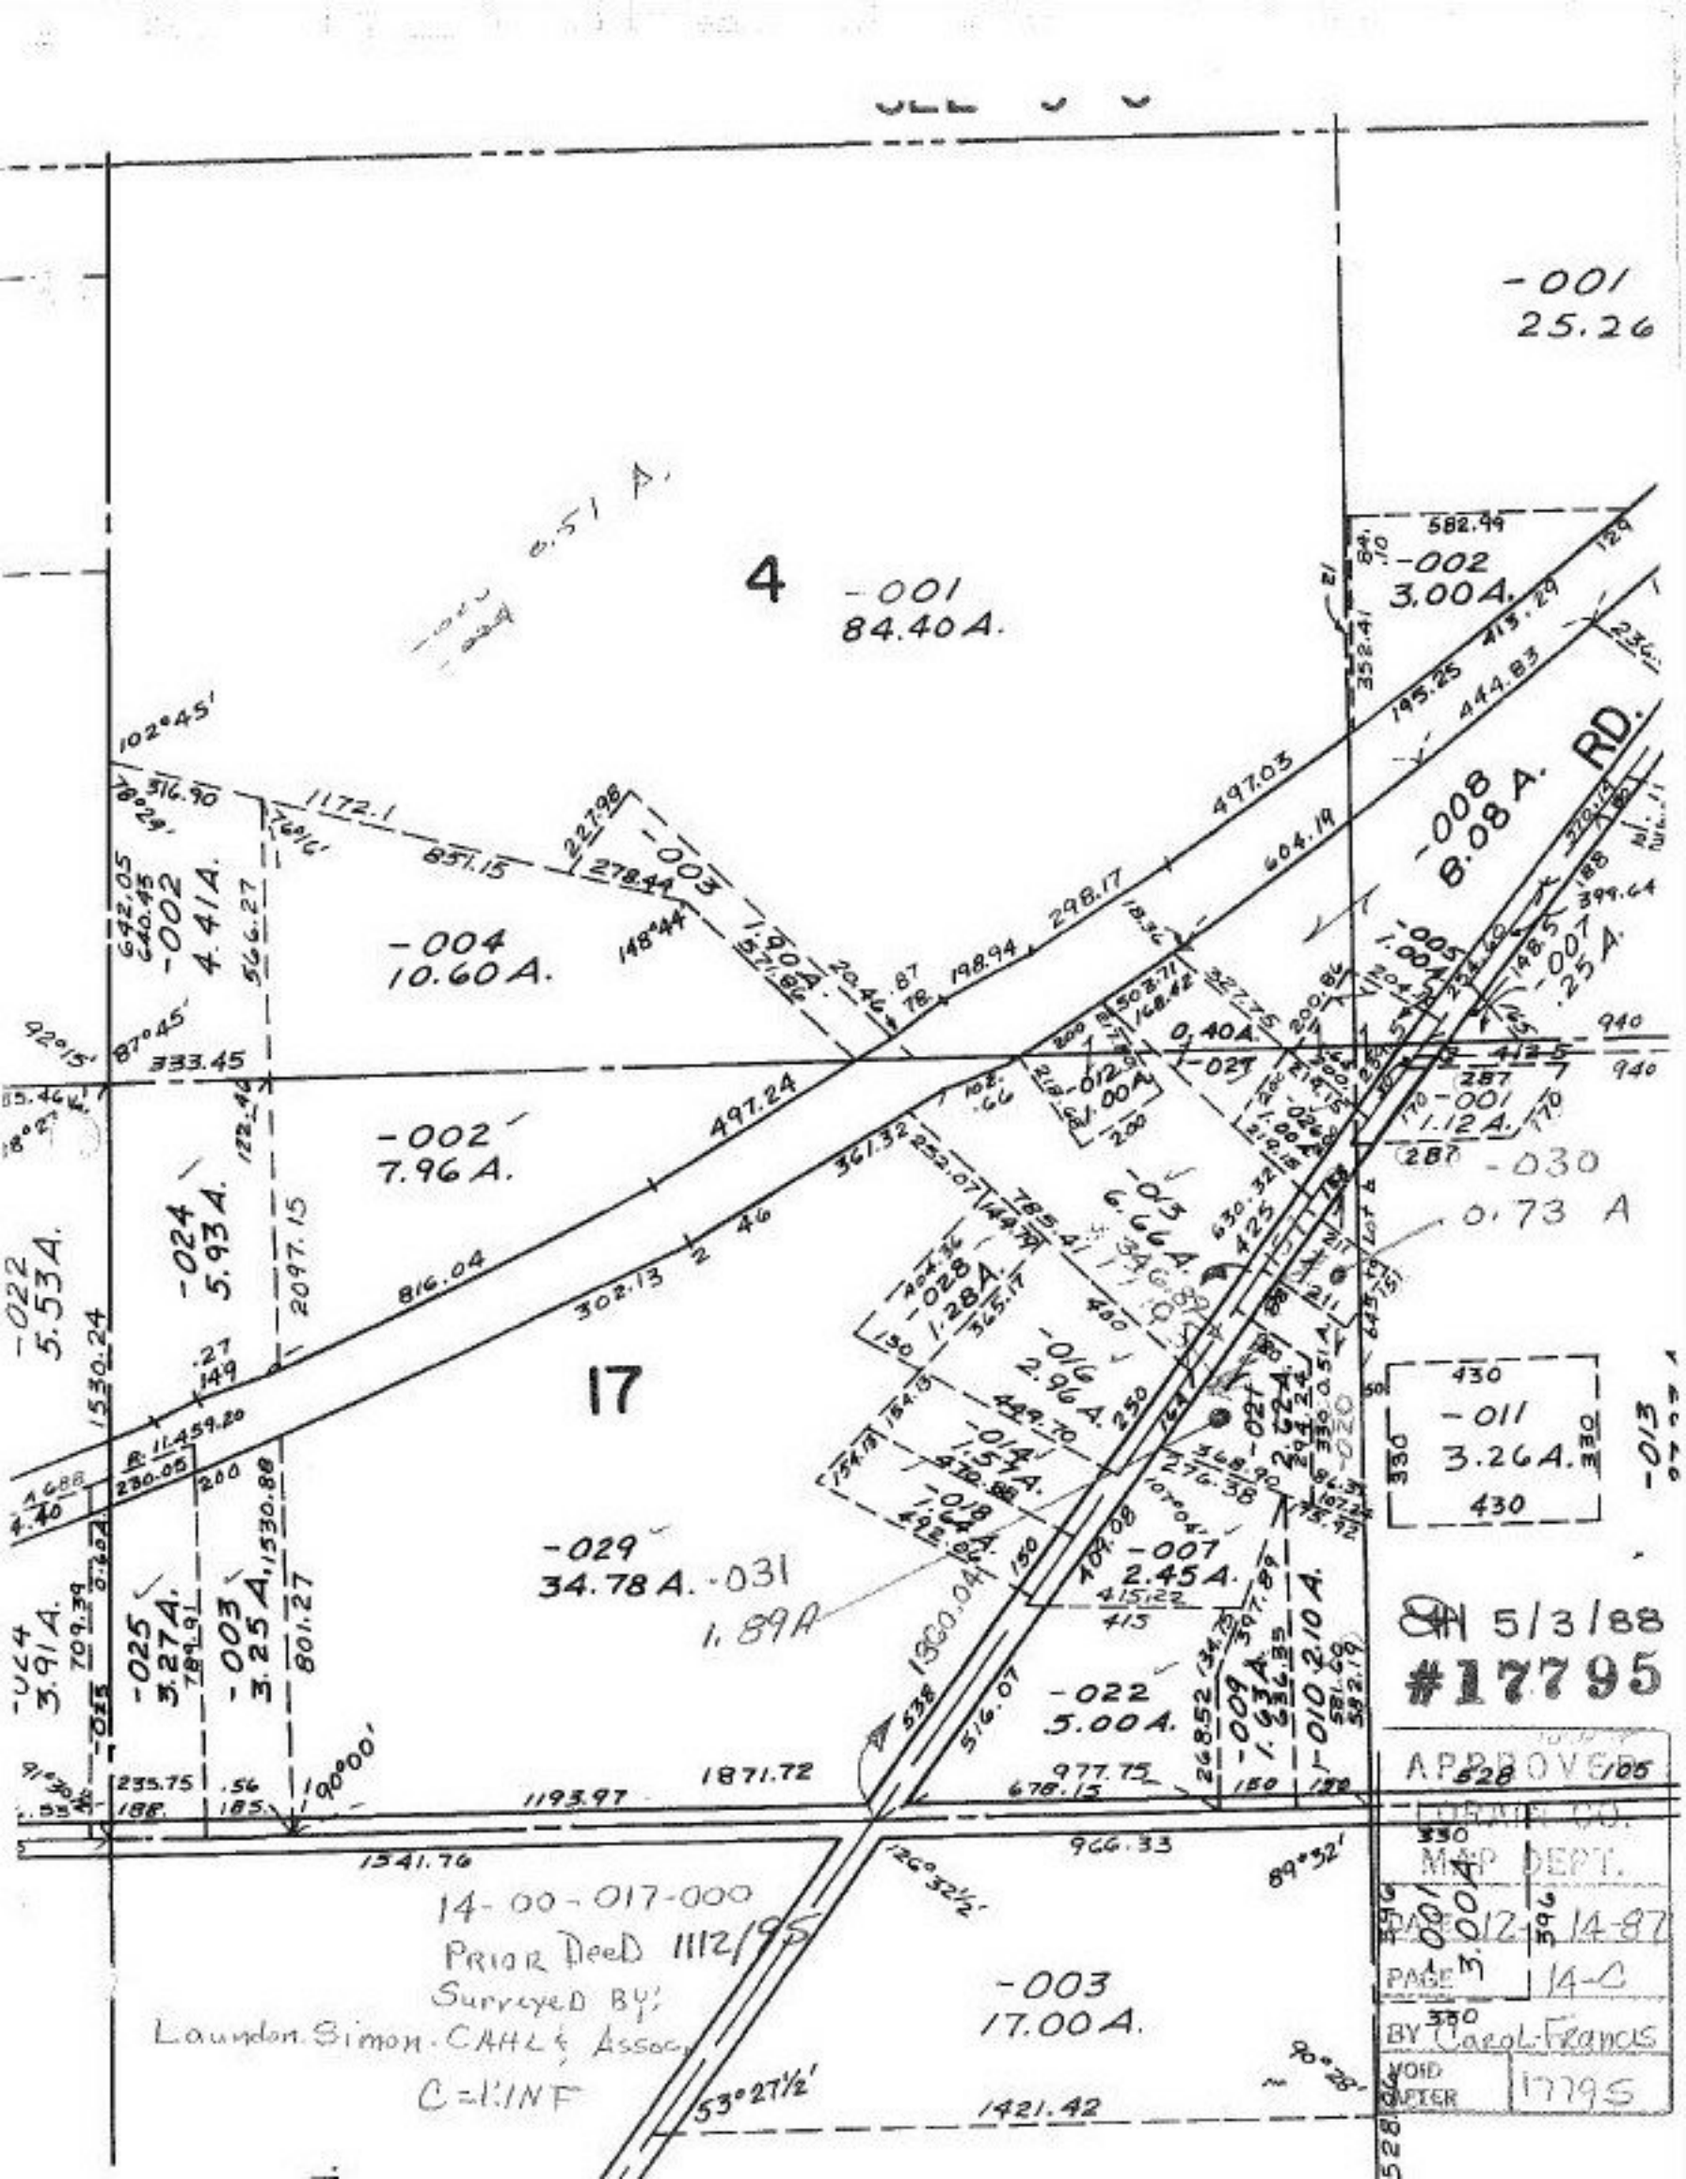
-001
25.26
4
-001
84.40A.
0.51 A.
-002
3.00A.
-008
8.08A.
RD.
-004
10.60A.
-003
-002
4.41A.
-002
7.96A.
-024
5.93A.
-022
5.53A.
17
-029
34.78A.
-031
1.89A
-025
3.27A.
-003
3.25A.
-004
3.91A.
-003
17.00A.
-022
5.00A.
-007
2.45A.
-009
1.63A.
-010
2.10A.
-011
3.26A.
-030
0.73 A
-001
1.12A.
-005
1.00A.
-007
.25A.
-012
.00A.
-027
0.40A.
-028
1.28A.
-016
2.96A.
-014
1.57A.
-018
.64A.
-013
-020
2.24A.
-021
.51A.
-026
.00A.
-023
.66A.
-015
.62A.
5/3/88
#17795
APPROVED
MAP DEPT.
14-00-017-000
PRIOR DEED 1112/95
Surveyed By:
Loundon Simon-CAHL & Assoc.
C=1.INF
1360.04
1541.76
1193.97
1871.72
966.33
1421.42
516.07
538
1530.24
2097.15
816.04
497.24
361.32
302.13
333.45
1172.1
851.15
278.44
227.98
148°44'
102°45'
87°45'
90°00'
53°27½'
126°32½'
89°32'
90°28'
RECORDED 14-87
PAGE 14-C
BY Carol Francis
VOID AFTER 17795