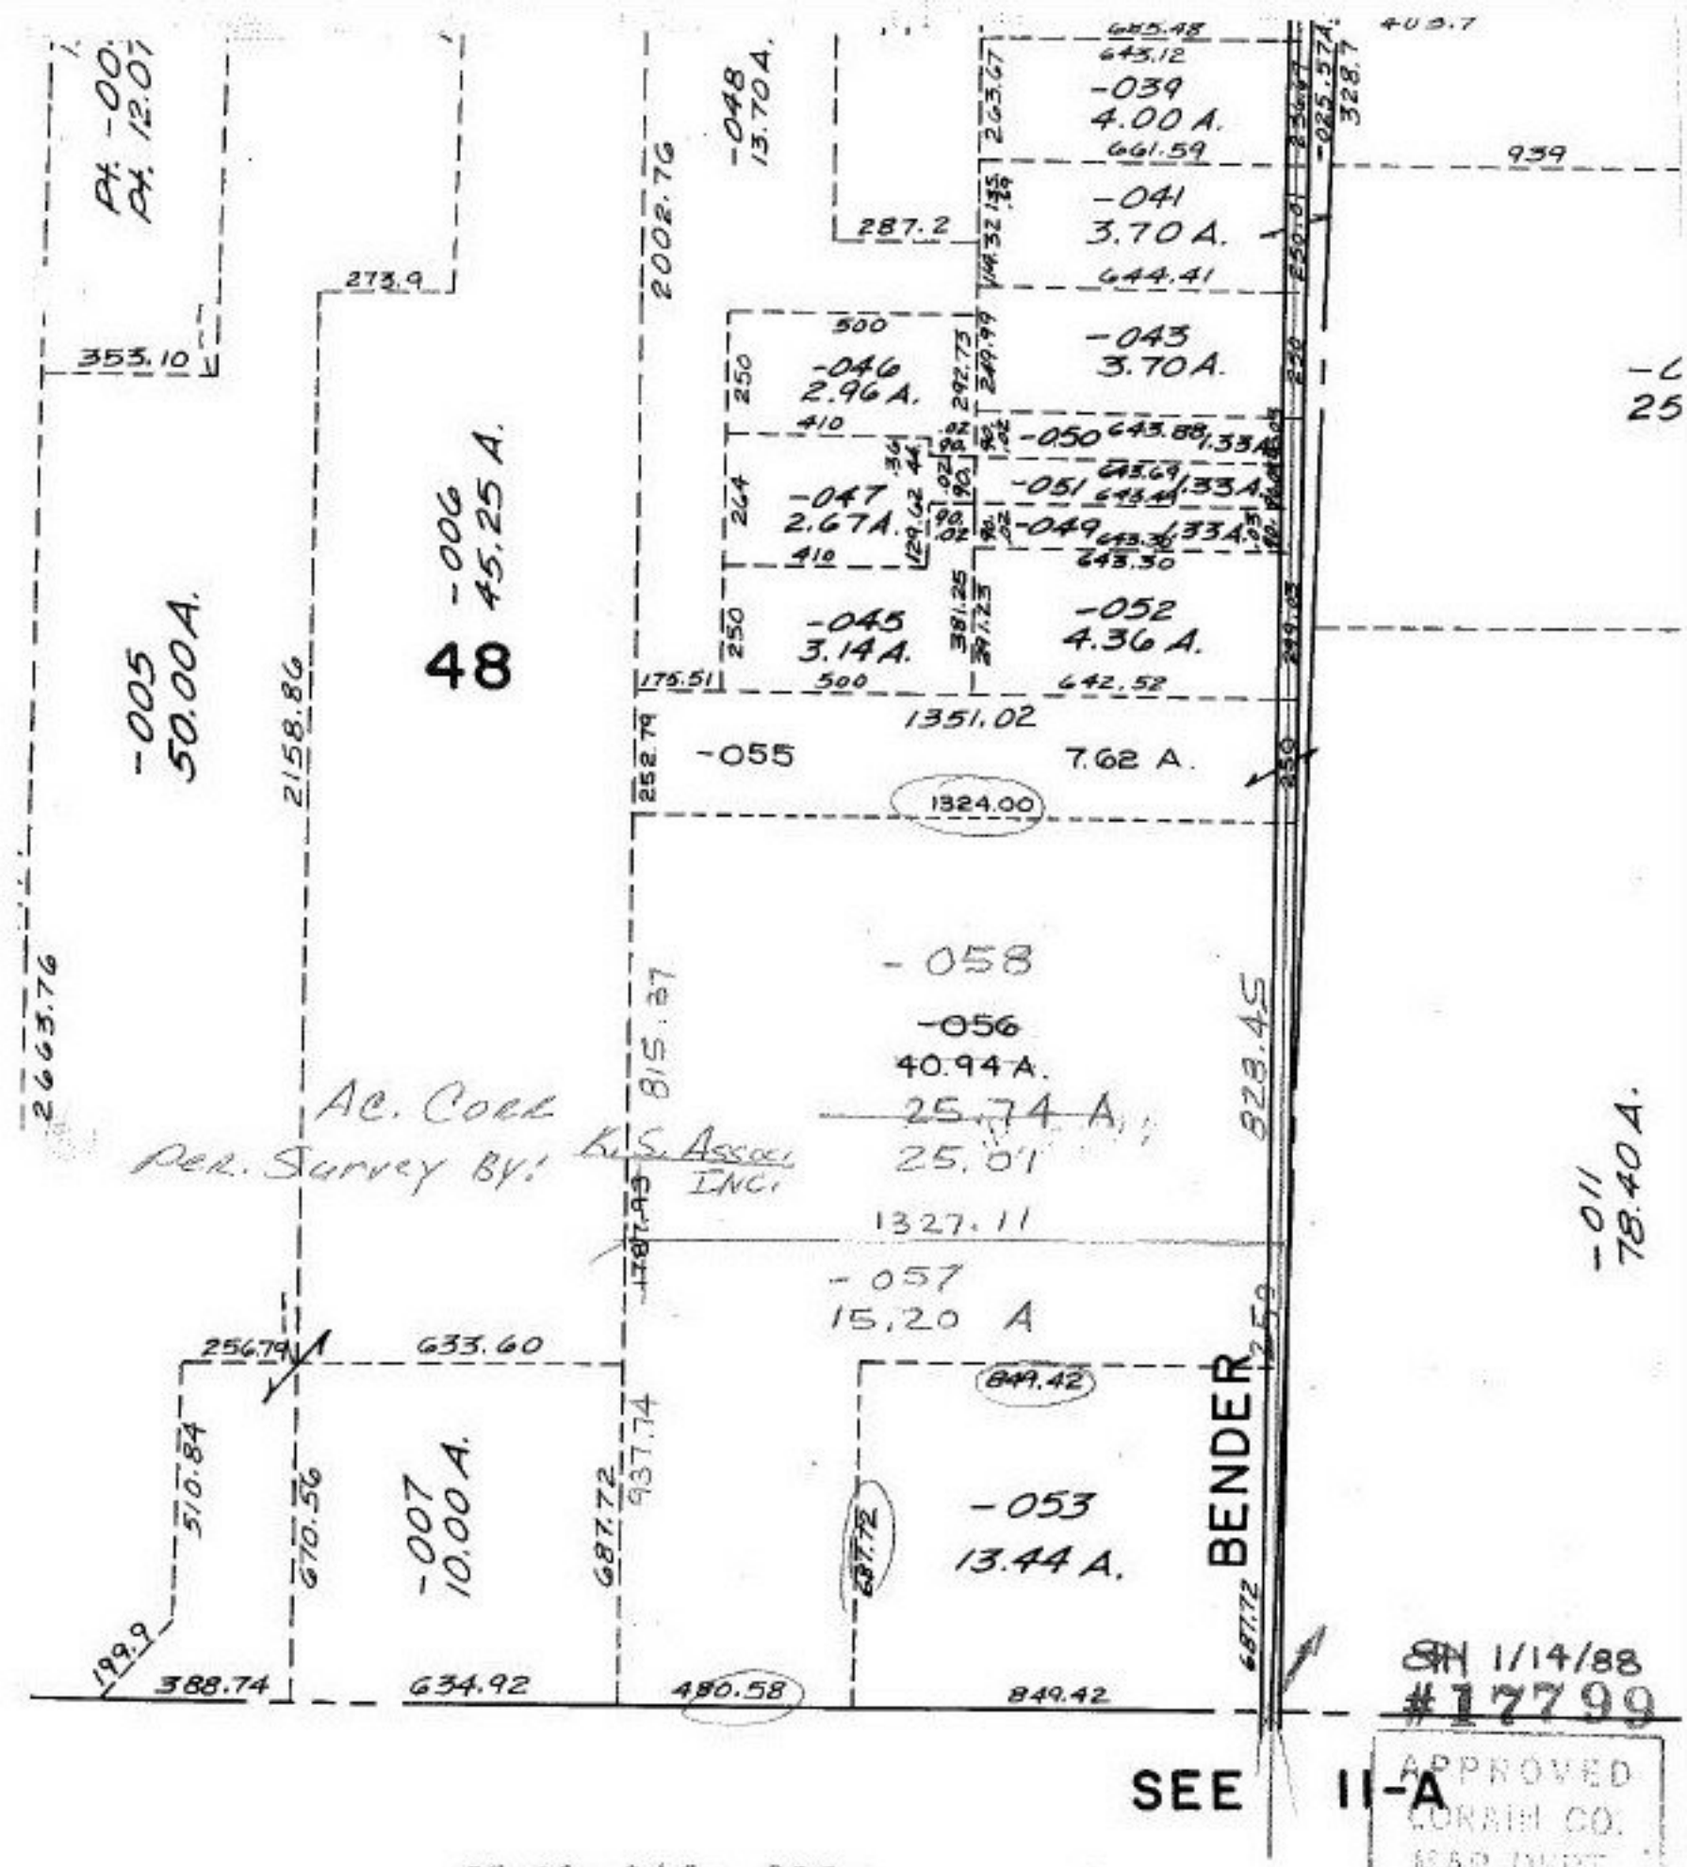

SM 1/14/88
#17799

07-00-048-000-
PRIOR DEED 944-80
Survey - K.S. Assoc. Inc.
C=1:1000000

APPROVED
LORAIN CO.
MAP DEPT.
DATE 12-16-87
PAGE 7-E
BY Carol Frances
VOID
AFTER 17799