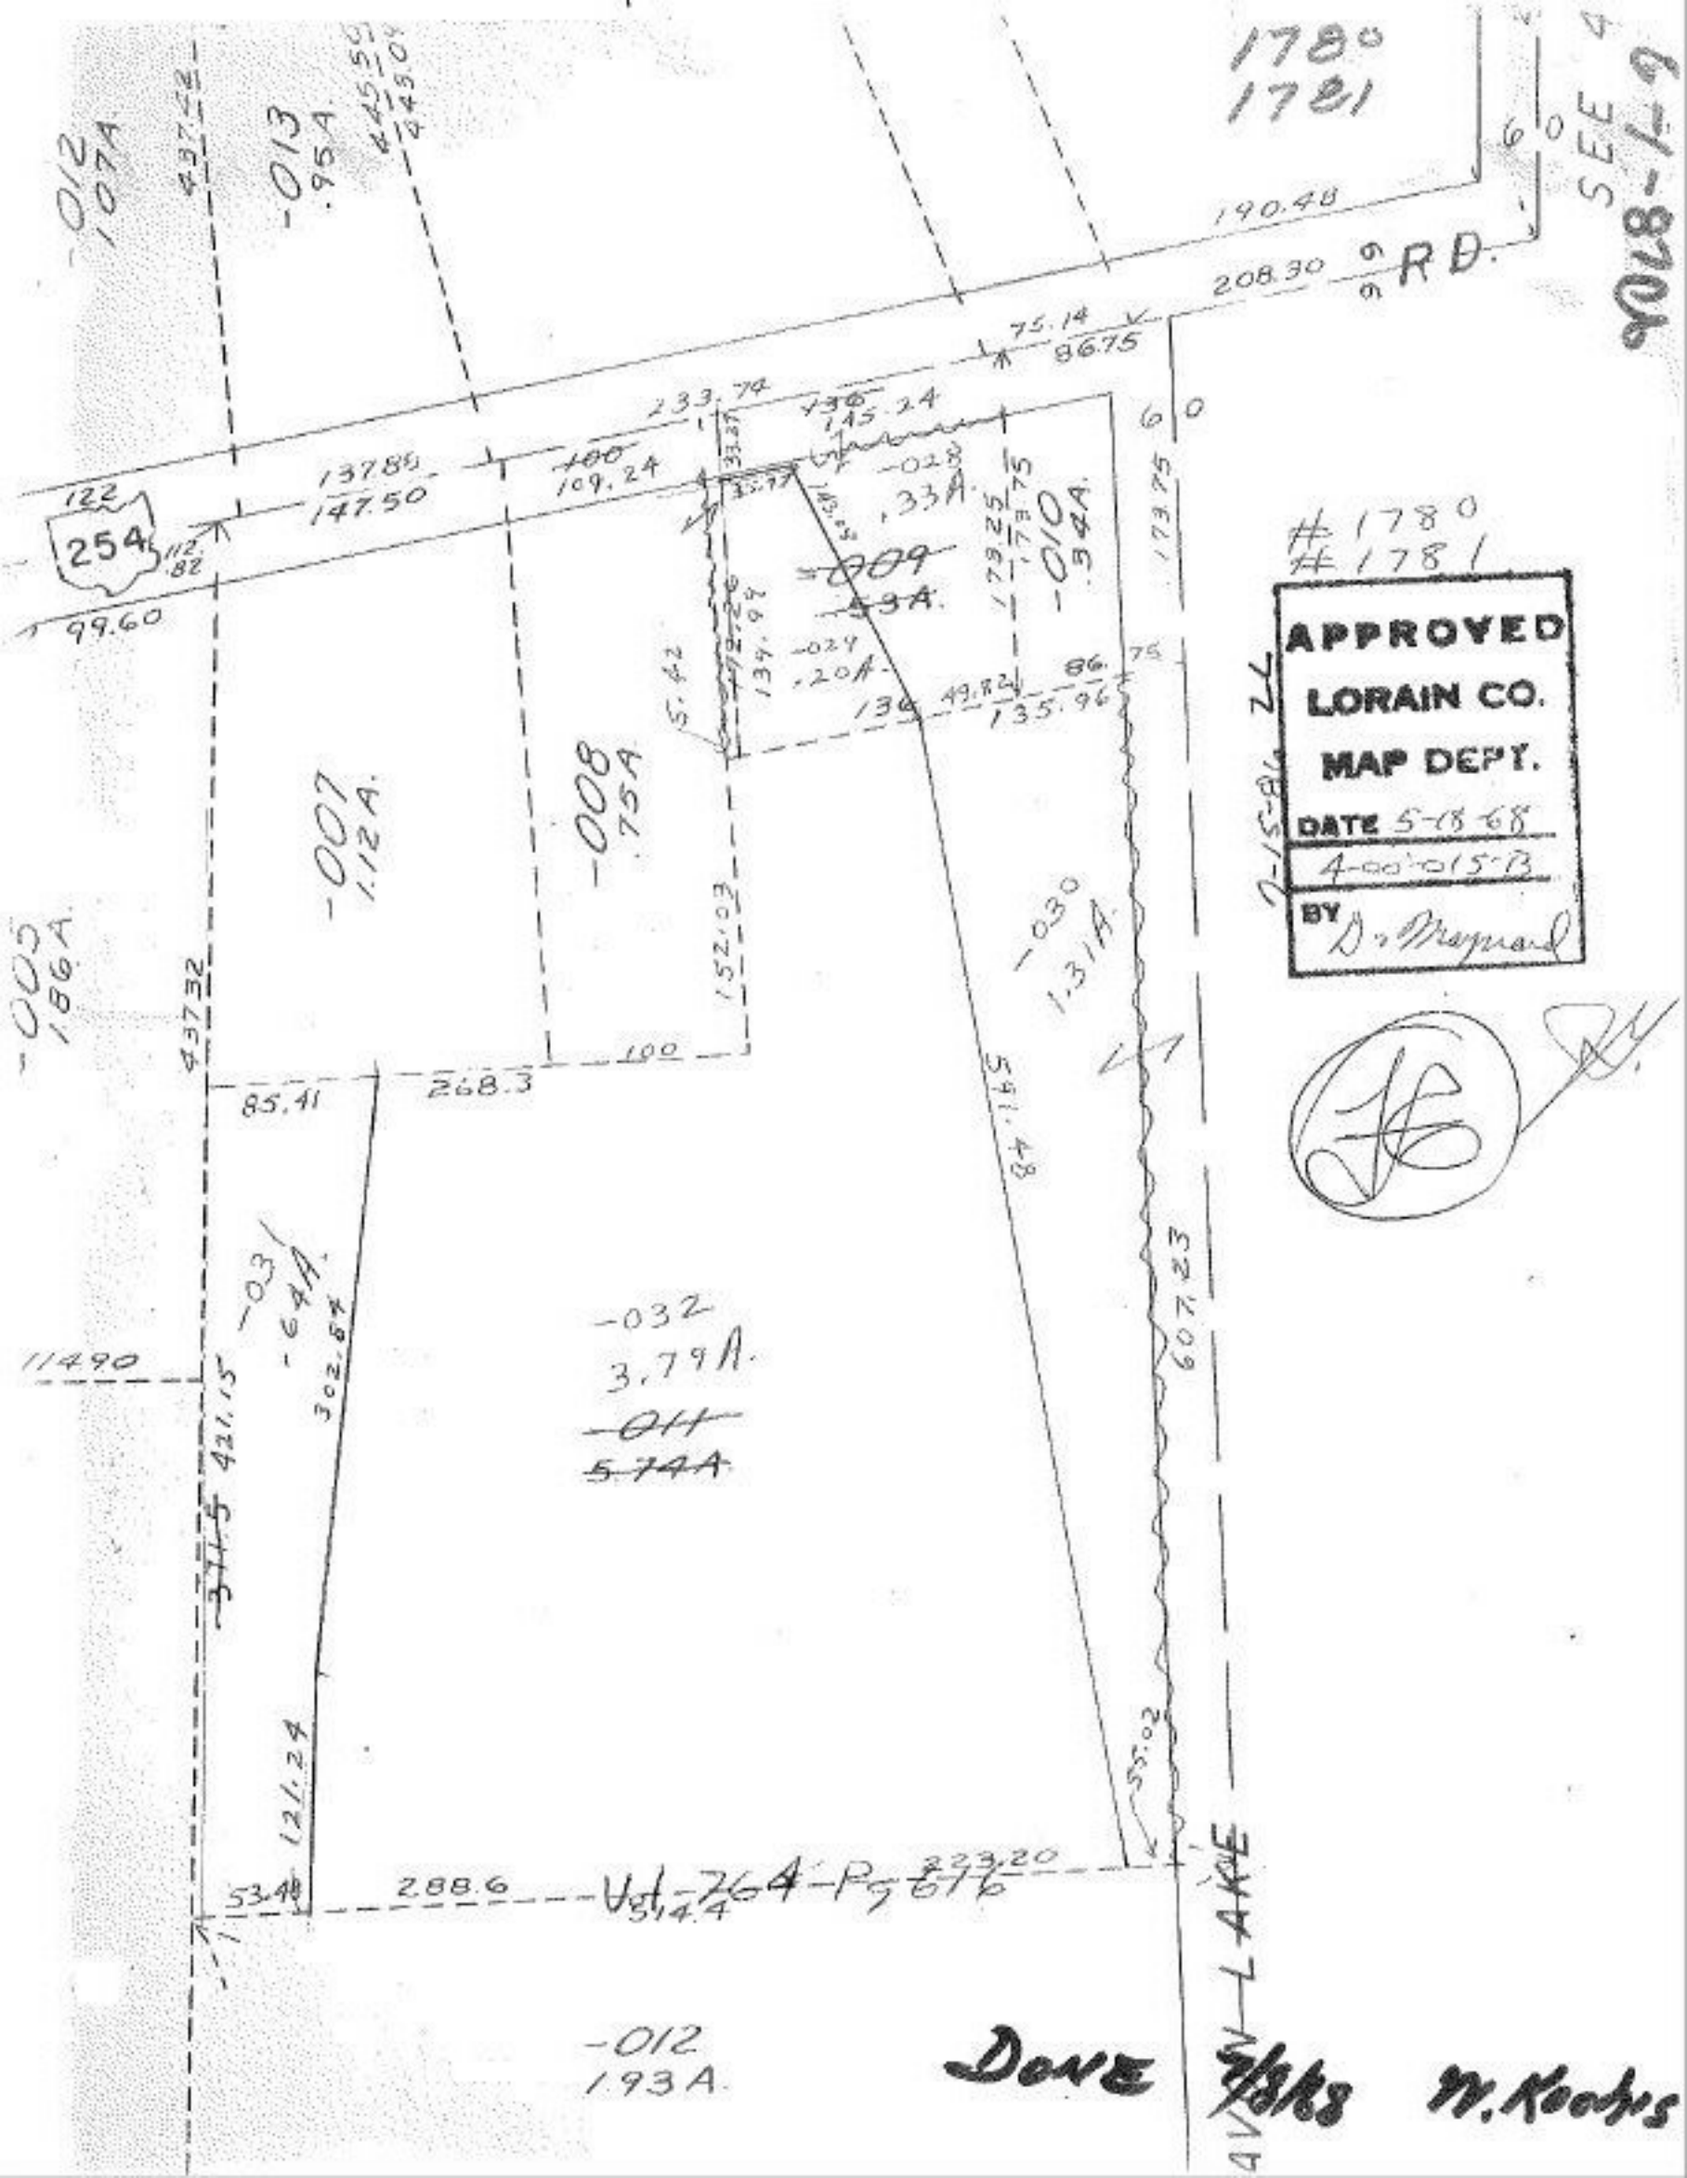
1780
1781
SEE 018-1-9
-012
107A.
-013
.95A.
#45.50
#43.09
#37.72
190.48
208.30
99 RD.
75.14
86.75
233.74
145.24
137.85
147.50
100
109.24
122
254
112.82
99.60
-028
.33A.
-009
.93A.
-010
.34A.
173.25
173.75
173.75
#1780
#1781
APPROVED
LORAIN CO.
MAP DEPT.
DATE 5-18-68
4-00-015-B
BY D. Maynard
-024
.20A.
134.98
55.42
49.82
135.96
86.75
-007
1.12A.
-008
.75A.
-030
1.31A.
-005
1.86A.
#37.32
85.41
268.3
100
152.03
84.145
607.23
-032
3.79A.
-03
.64A.
302.84
421.15
114.90
121.24
53.48
288.6
55.02
223.20
Vol 764 Pg 676
-012
1.93A.
Dave 5/3/68 W. Koons
AVON LAKE