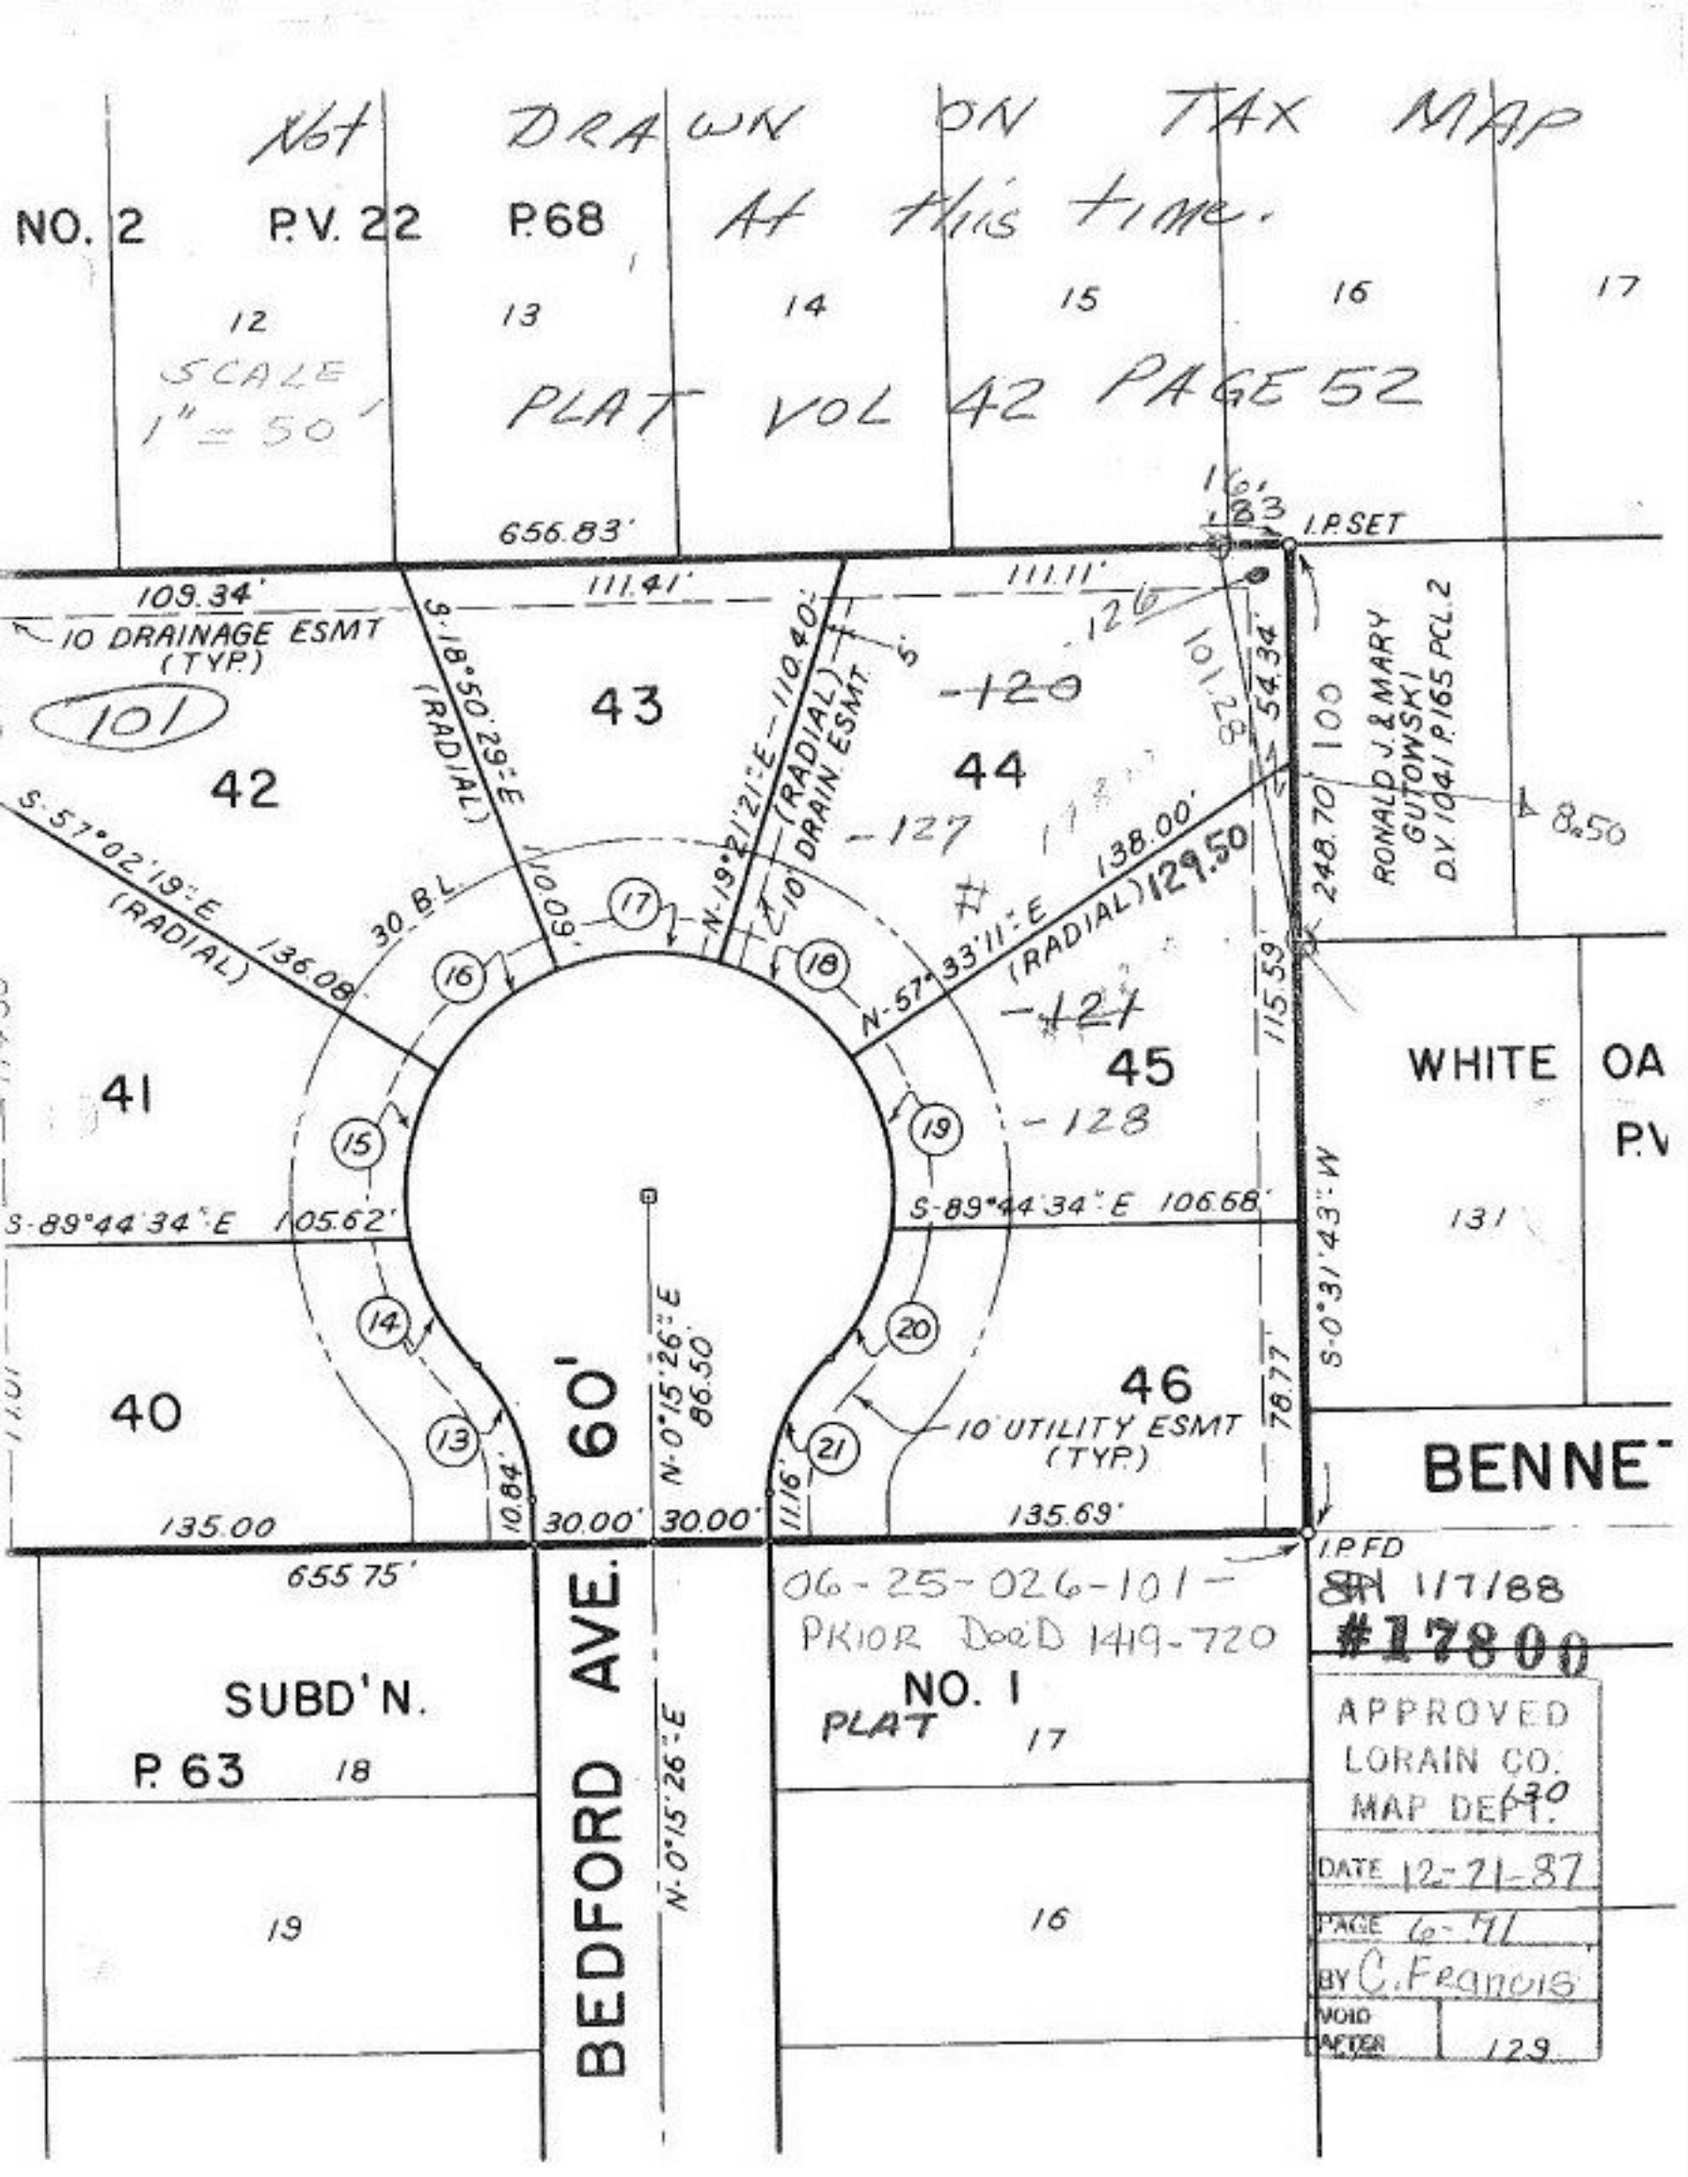
Not DRAWN ON TAX MAP At this time.
NO. 2
P.V. 22
P.68
12
13
14
15
16
17
SCALE 1" = 50'
PLAT VOL 42 PAGE 52
656.83'
I.P.SET
109.34'
10 DRAINAGE ESMT (TYP.)
111.41'
111.11'
101
42
43
44
45
41
40
46
S-18°50'29"-E (RADIAL)
N-19°21'21"-E 110.40' (RADIAL)
5' DRAIN ESMT
S-57°02'19"-E (RADIAL) 136.08'
30' B.L.
100.09'
N-57°33'11"-E (RADIAL) 129.50'
138.00'
101.28'
54.34'
248.70'
RONALD J. & MARY GUTOWSKI D.V. 1041 P.165 PCL. 2
8.50
115.59'
WHITE
OA
P.V
131
S-89°44'34"-E 105.62'
S-89°44'34"-E 106.68'
S-0°31'43"-W
78.77'
10' UTILITY ESMT (TYP.)
N-0°15'26"-E 86.50'
10.84'
30.00'
30.00'
111.16'
135.00'
135.69'
655.75'
BEDFORD AVE. 60'
N-0°15'26"-E
I.P.FD
BENNE
06-25-026-101-
PRIOR DOC'D 1419-720
SUBD'N.
P. 63
18
19
NO. 1
PLAT
17
16
APPROVED
LORAIN CO.
MAP DEPT.
DATE 12-21-87
PAGE 6-71
BY C. Francis
VOID AFTER 129
#17800