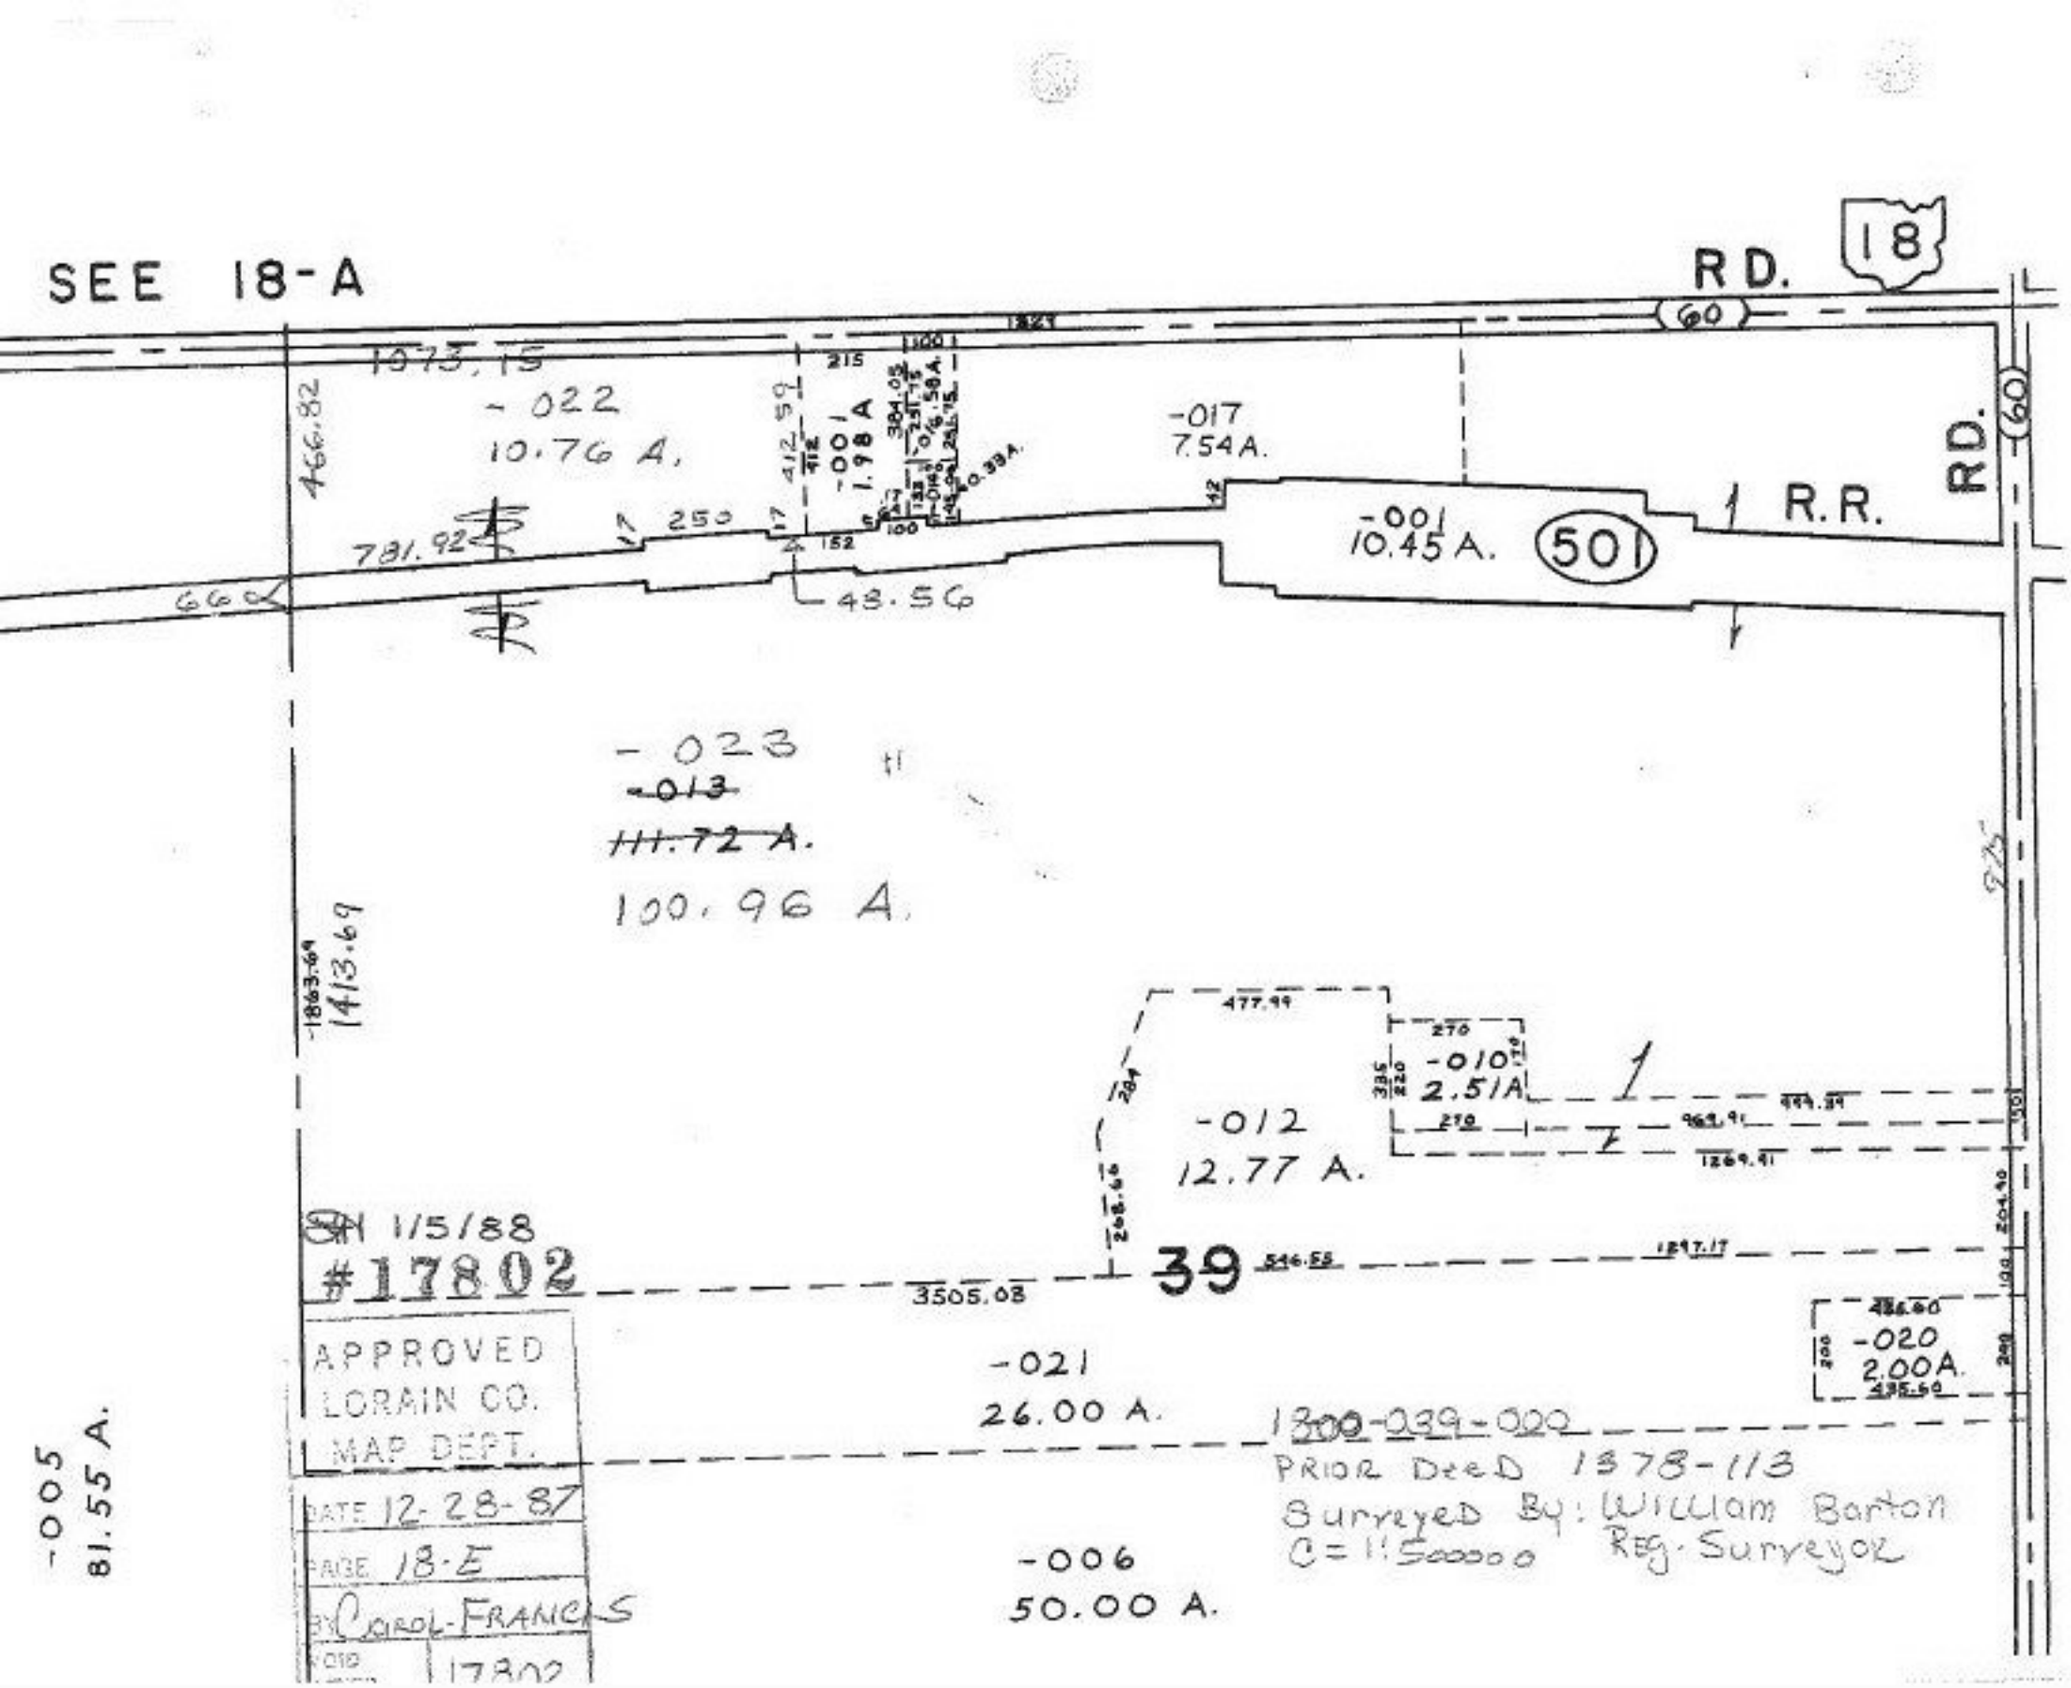
SEE 18-A
RD. 18
(60)
1073.15
-022
10.76 A.
466.82
215
412.59
412
-001
1.98 A
384.05
251.75
0.58 A.
245.75
0.38 A.
-017
7.54A.
-001
10.45 A.
501
1 R.R.
RD.
(60)
660
781.92
250
152
48.56
-023
-013
11.72 A.
100.96 A.
1863.69
1413.69
477.99
270
-010
2.51A
335
220
-012
12.77 A.
264
268.64
1269.41
1/5/88
#17802
39
546.58
1297.17
3505.08
APPROVED
LORAIN CO.
MAP DEPT.
DATE 12-28-87
PAGE 18-E
BY CAROL-FRANCIS
NO. 17802
-021
26.00 A.
1300-039-020
PRIOR DEED 1378-113
Surveyed By: William Barton
C=1:500000 Reg. Surveyor
-006
50.00 A.
-005
81.55 A.
925
1304.10
486.60
-020
2.00A.
435.60
200