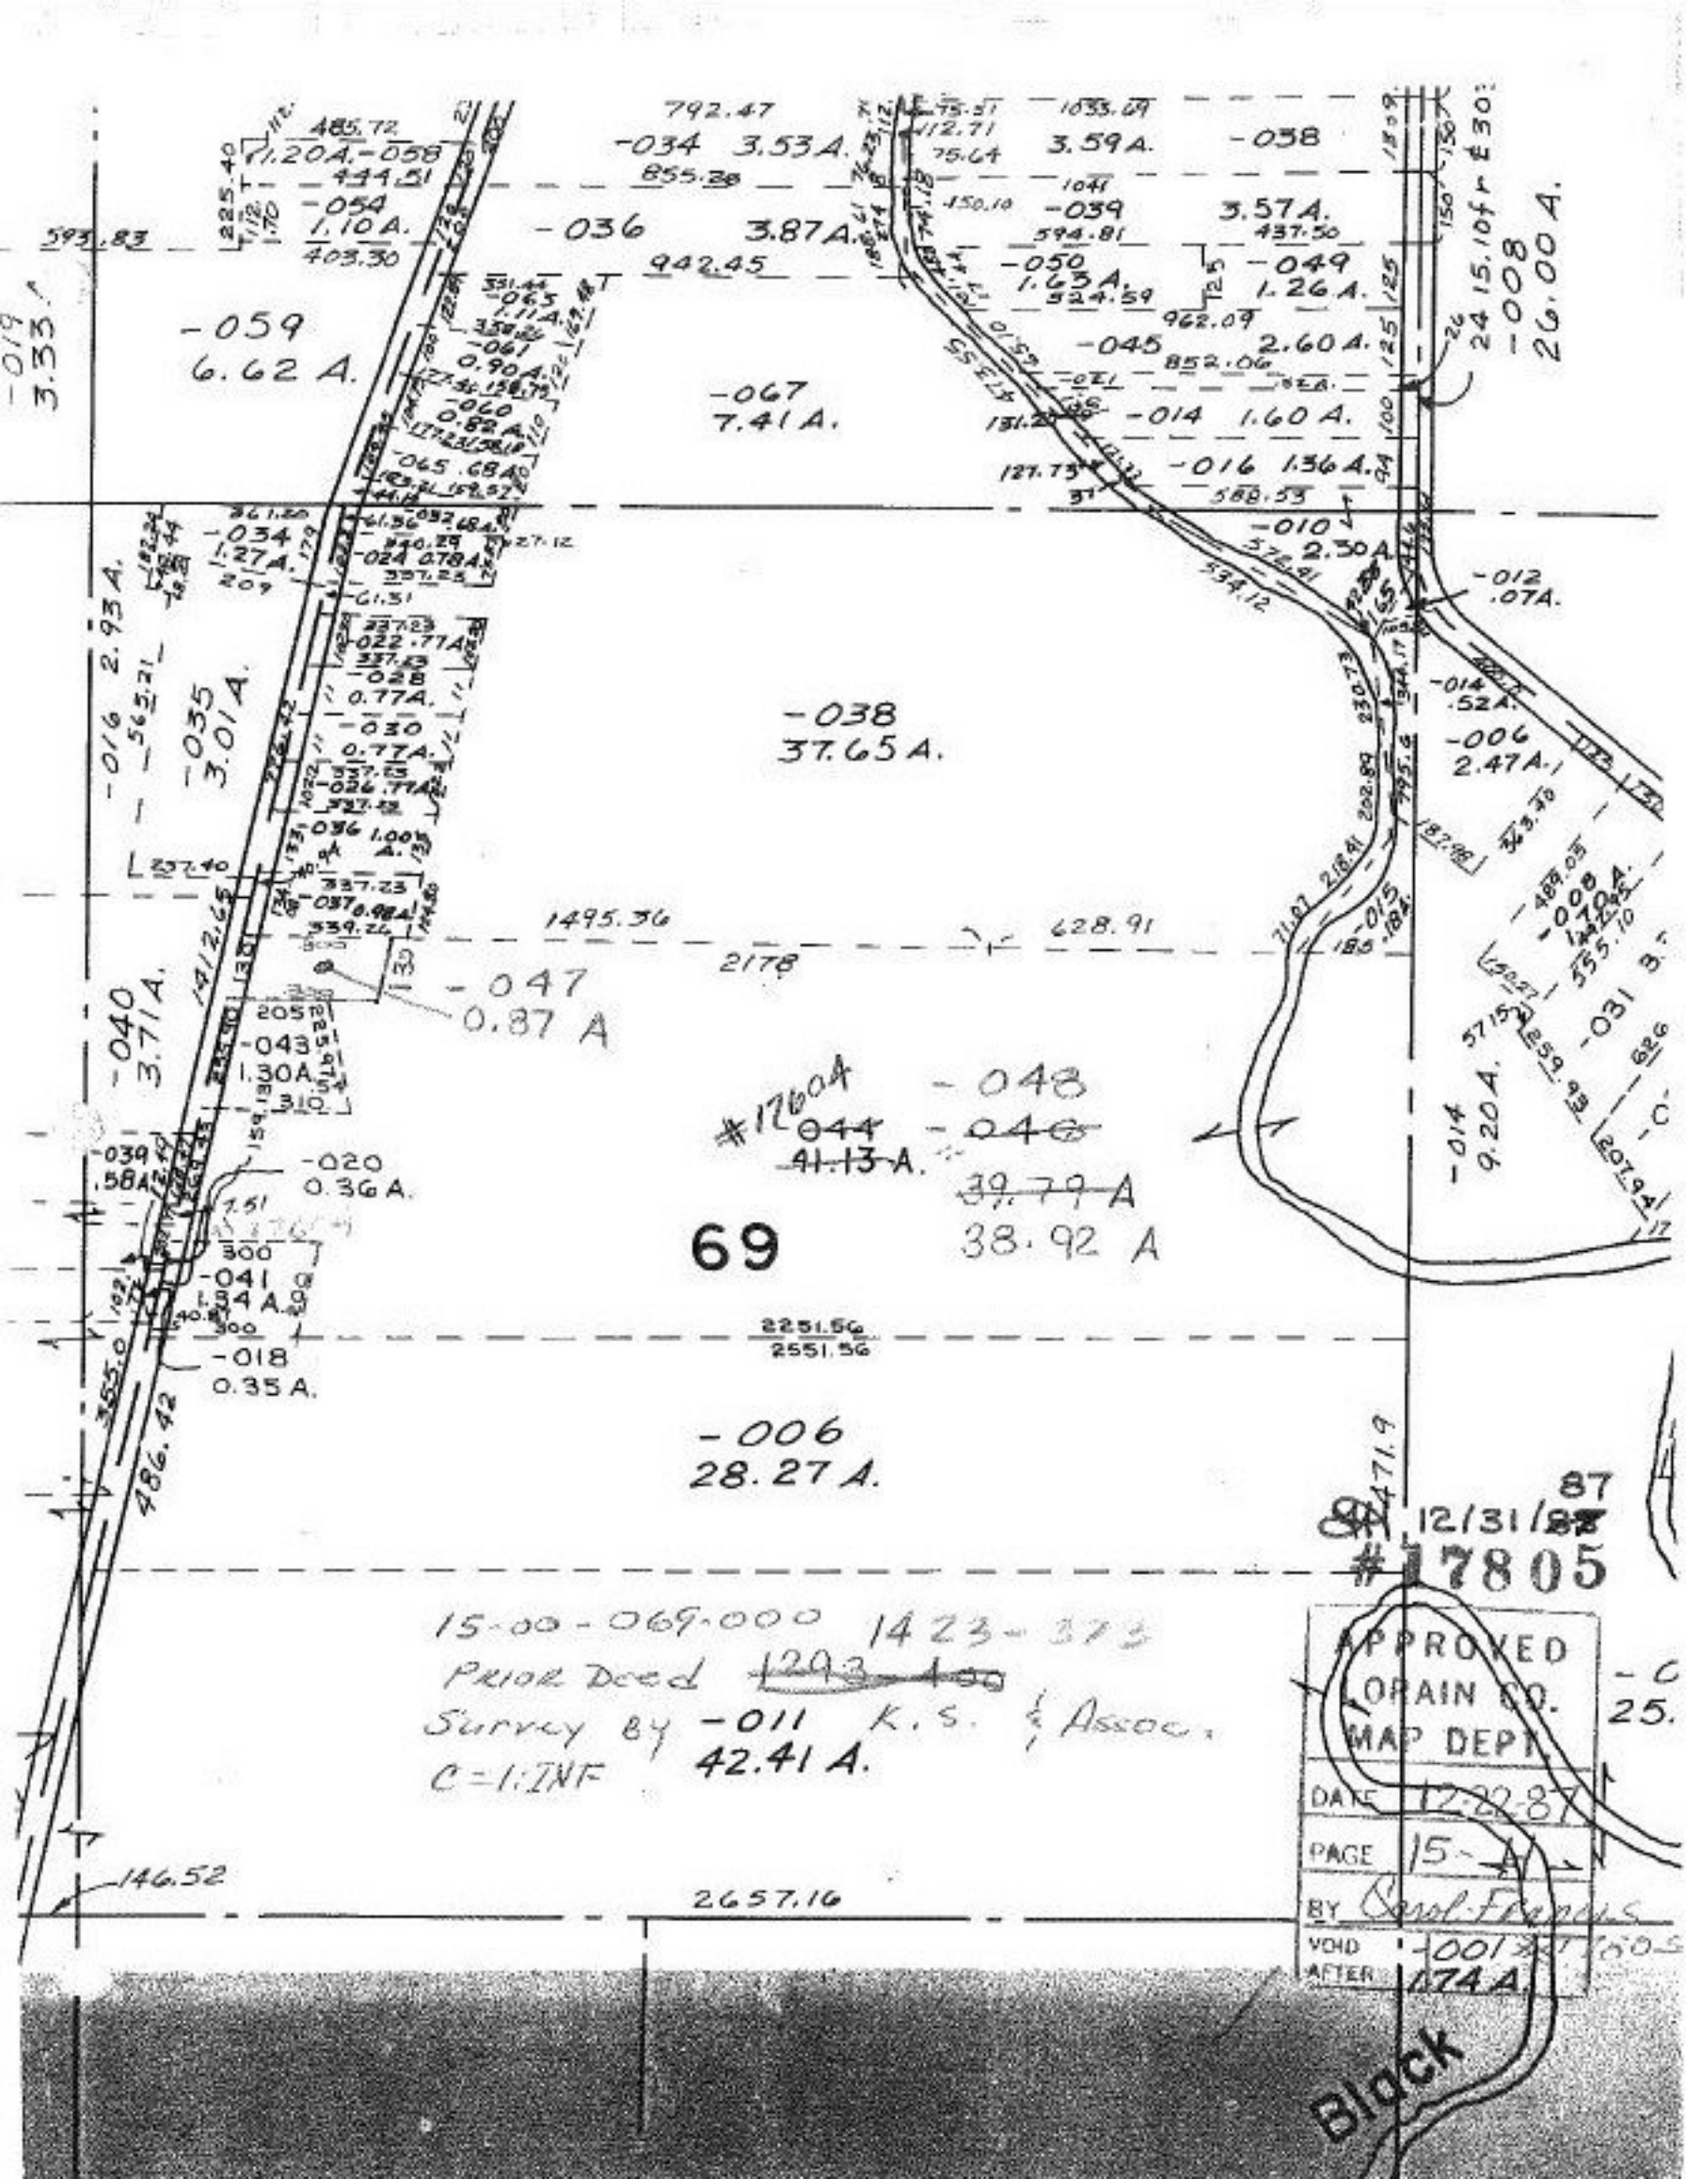

-034 3.53 A.
3.59 A.
-038
-036 3.87 A.
-039 3.57 A.
-050 1.63 A.
-049 1.26 A.
-045 2.60 A.
-059 6.62 A.
-067 7.41 A.
-014 1.60 A.
-016 1.36 A.
-010 2.30 A.
-012 .07 A.
-038 37.65 A.
-006 2.47 A.
-035 3.01 A.
-040 3.71 A.
-047 0.87 A
-043 1.30 A.
-048
#17604
~~044~~ ~~41.13 A.~~
~~-046~~
~~39.79 A~~
38.92 A
-020 0.36 A.
-041 1.34 A.
-018 0.35 A.
69
-006 28.27 A.
-014 9.20 A.
-008 26.00 A.
-019 3.33
-016 2.93 A.
-031
12/31/87
#17805
15-00-069-000 1423-373
Prior Deed ~~1293-400~~
Survey by -011 K.S. & Assoc.
C=1:INF 42.41 A.
APPROVED
LORAIN CO.
MAP DEPT.
DATE 12-22-87
PAGE 15-A
BY Carol Francis
VOID -001
AFTER 1.74 A.
Block