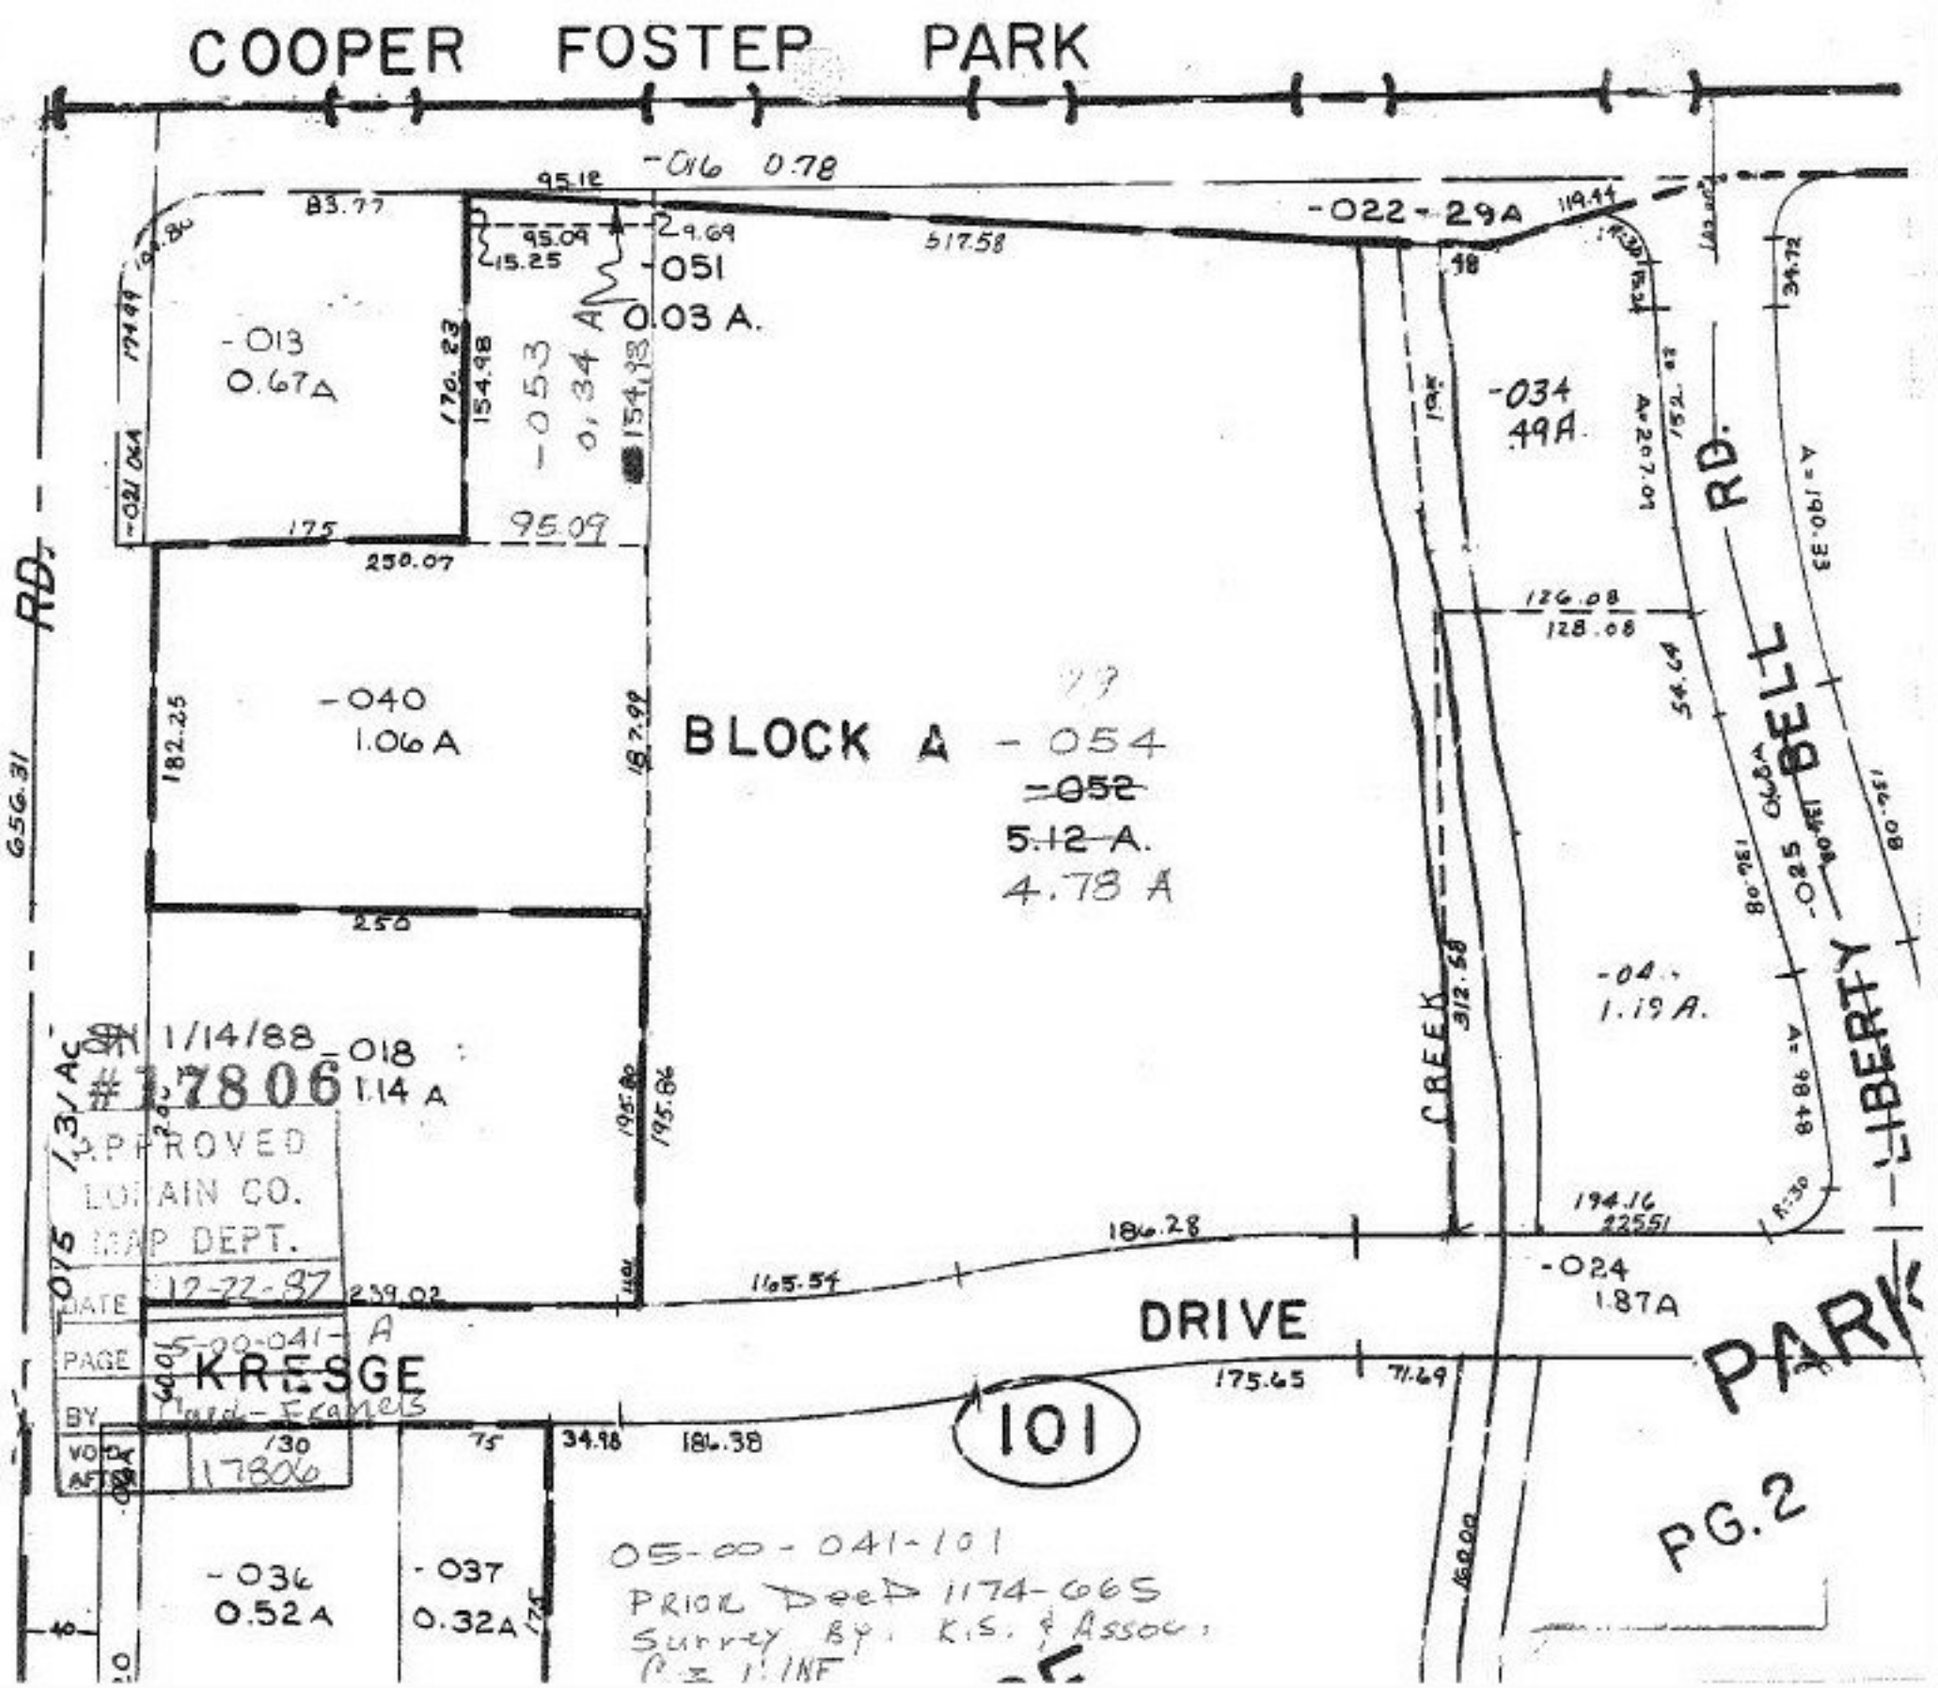
COOPER FOSTEP PARK
-016 0.78
-022 - 29A
-051
0.03 A.
-013
0.67A
-053
0.34 A
-034
.49A
-040
1.06 A
BLOCK A
-054
~~-052~~
~~5.12 A.~~
4.78 A
-04
1.19 A.
-018
1.14 A
1/14/88
#17806
APPROVED
LORAIN CO.
MAP DEPT.
DATE 12-22-87
PAGE 5-00-041-A
BY
VOID AFTER 17806
KRESGE
DRIVE
101
-024
1.87A
-036
0.52A
-037
0.32A
05-00-041-101
PRIOR DEED 1174-665
Survey By. K.S. & Assoc.
CREEK
BELL RD.
LIBERTY
PARK
PG. 2