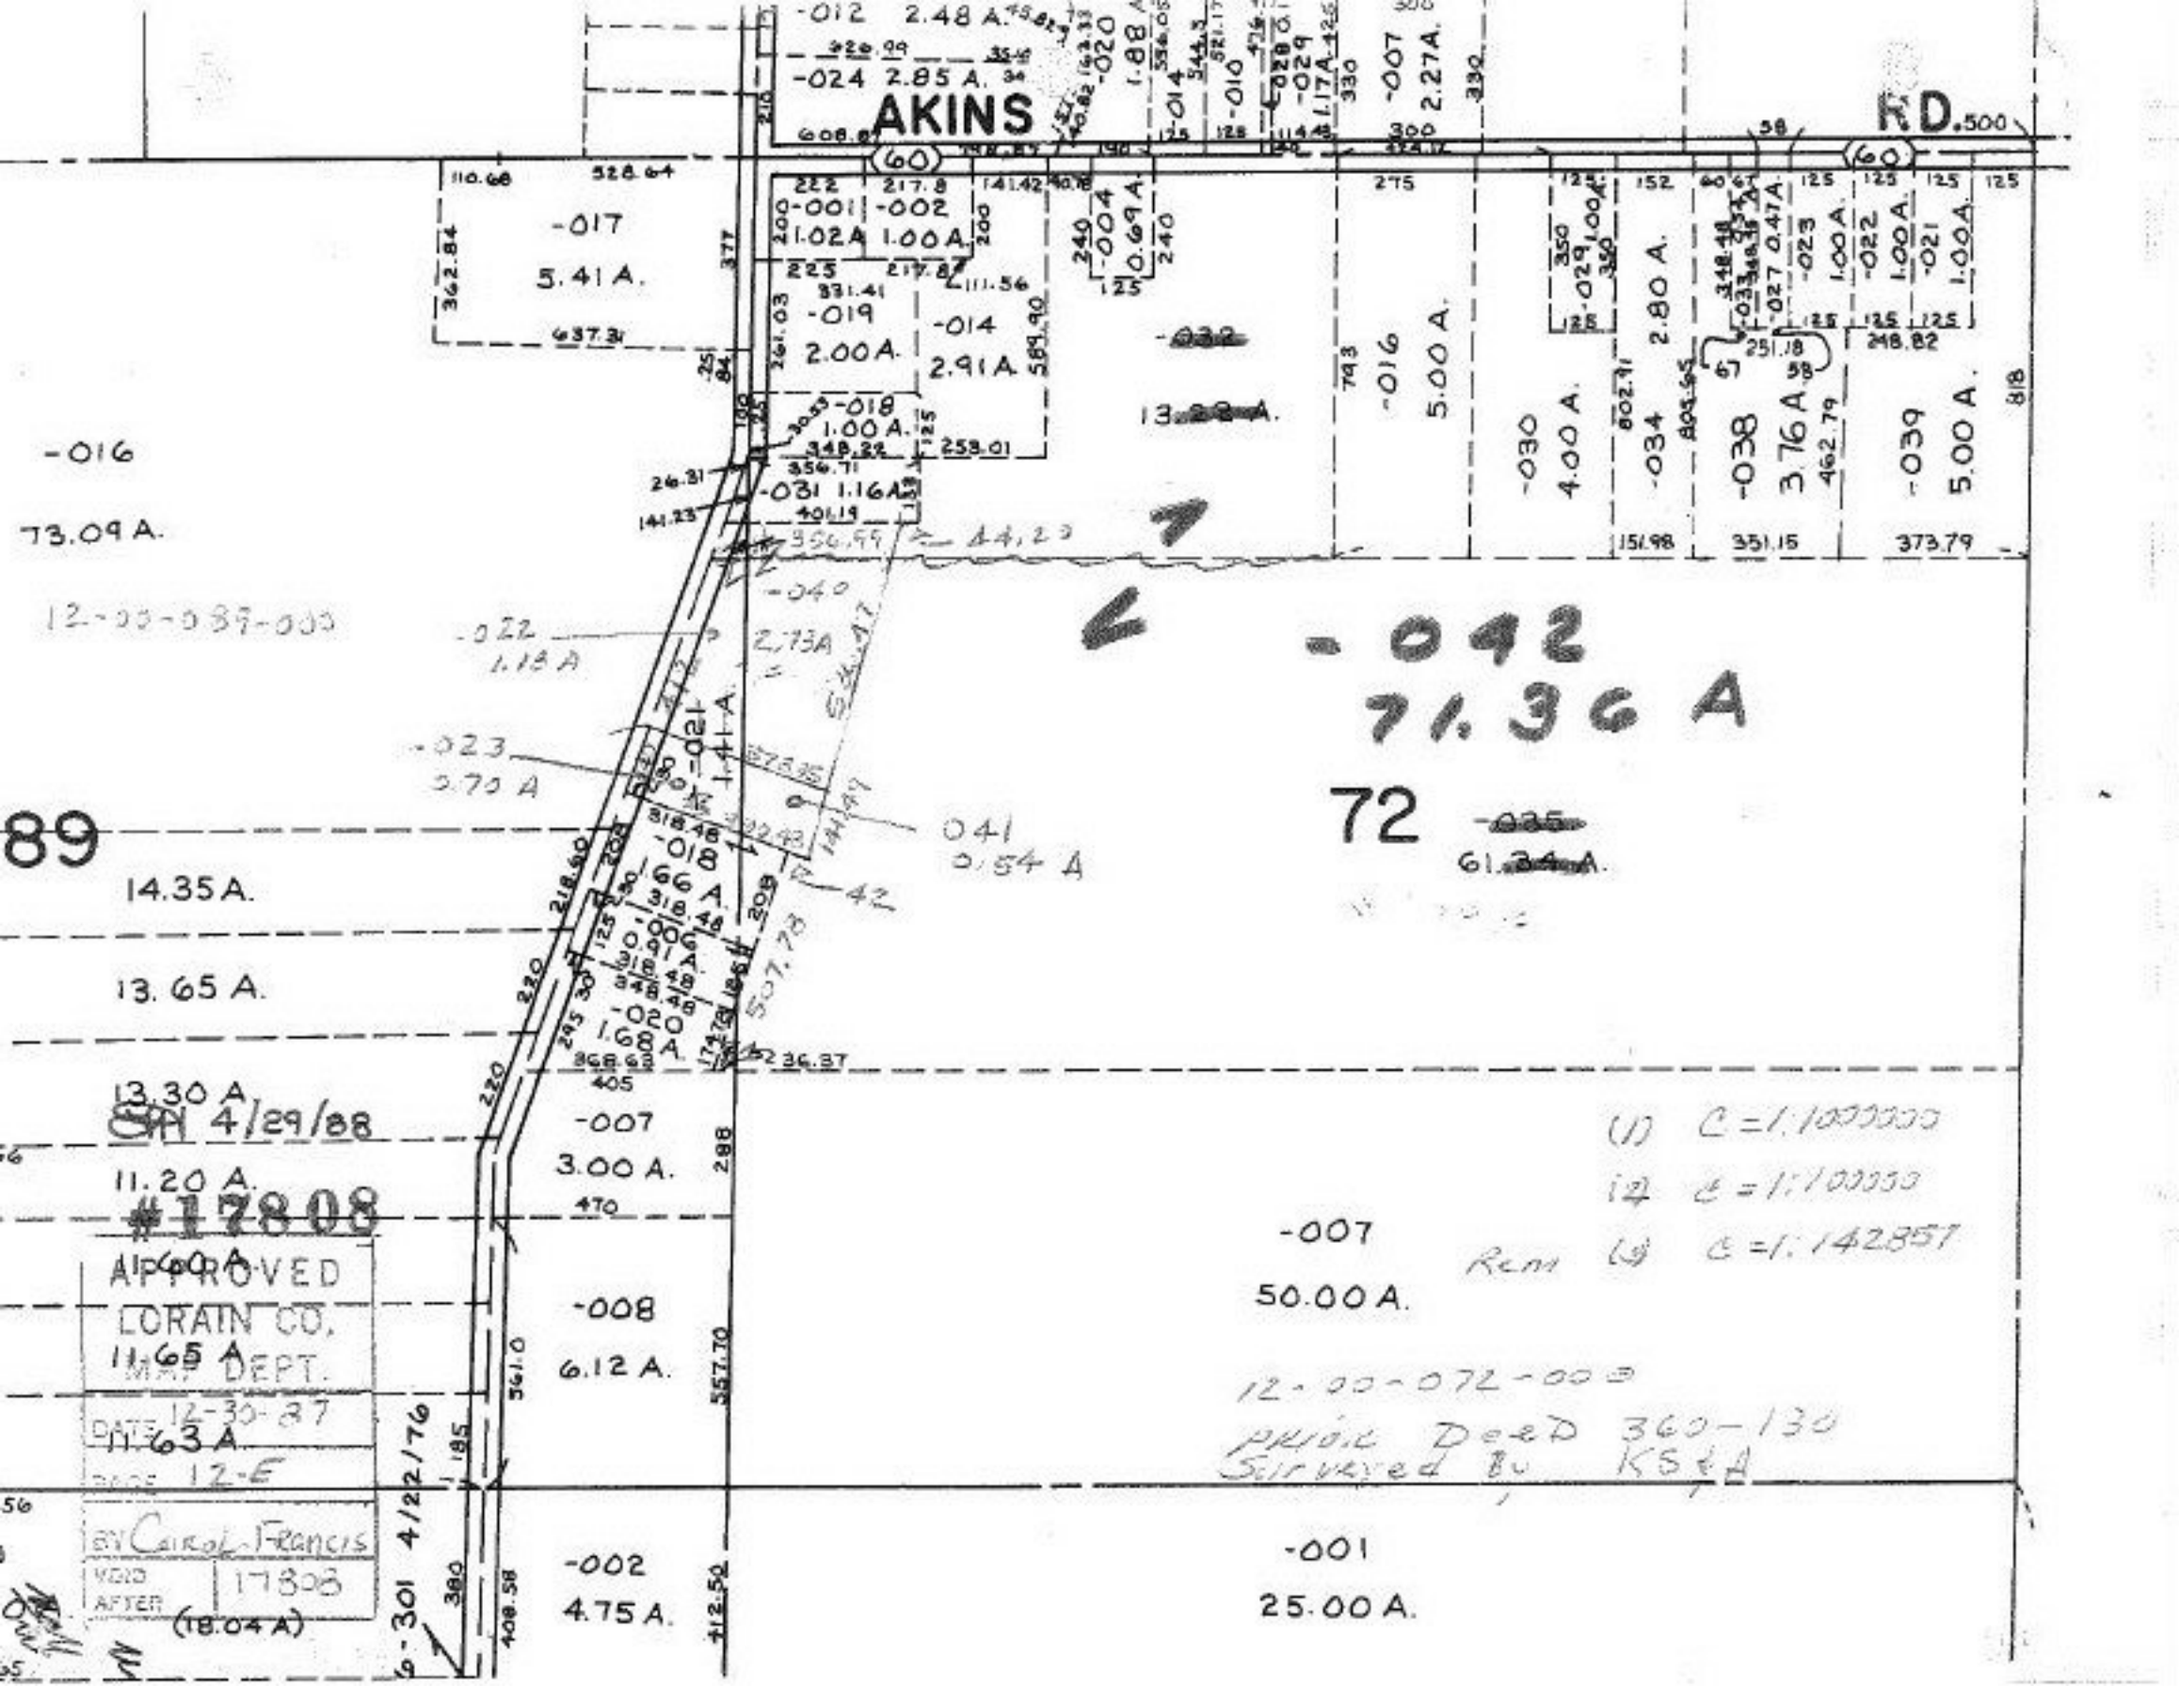
AKINS RD.
-012 2.48 A.
-024 2.85 A.
-020 1.88 A.
-014
-010
-029 1.17A
-007 2.27A.
-017 5.41 A.
-001 1.02A
-002 1.00A.
-019 2.00A.
-014 2.91A
-004 0.69 A.
-032
13.28 A.
-016 5.00 A.
-030 4.00 A.
-029 1.00A.
-034 2.80 A.
-027 0.47A.
-023 1.00 A.
-038 3.76 A
-022 1.00 A.
-021 1.00A.
-039 5.00 A.
-018 1.00 A.
-031 1.16A
-040 2.73A
-022 1.18 A
-023 0.70 A
-021 1.41 A.
-018 1.66 A
041 0.54 A
-042 71.36 A
72 -035 61.34 A.
89 14.35 A.
13.65 A.
-020 1.60 A.
13.30 A
SM 4/29/88
-007 3.00 A.
11.20 A.
#17808
APPROVED
LORAIN CO.
MAP DEPT.
DATE 12-30-87
PAGE 12-E
BY Carol Francis
VOID AFTER 17808
(18.04 A)
-008 6.12 A.
11.65 A
11.63 A
-002 4.75 A.
-007 50.00 A.
-001 25.00 A.
73.09 A.
-016
12-00-039-000
(1) C=1:1000000
(2) C=1:100000
(3) C=1:142857
Rem
12-00-072-000
prior Deed 360-130
Surveyed by KS&A
4/22/76