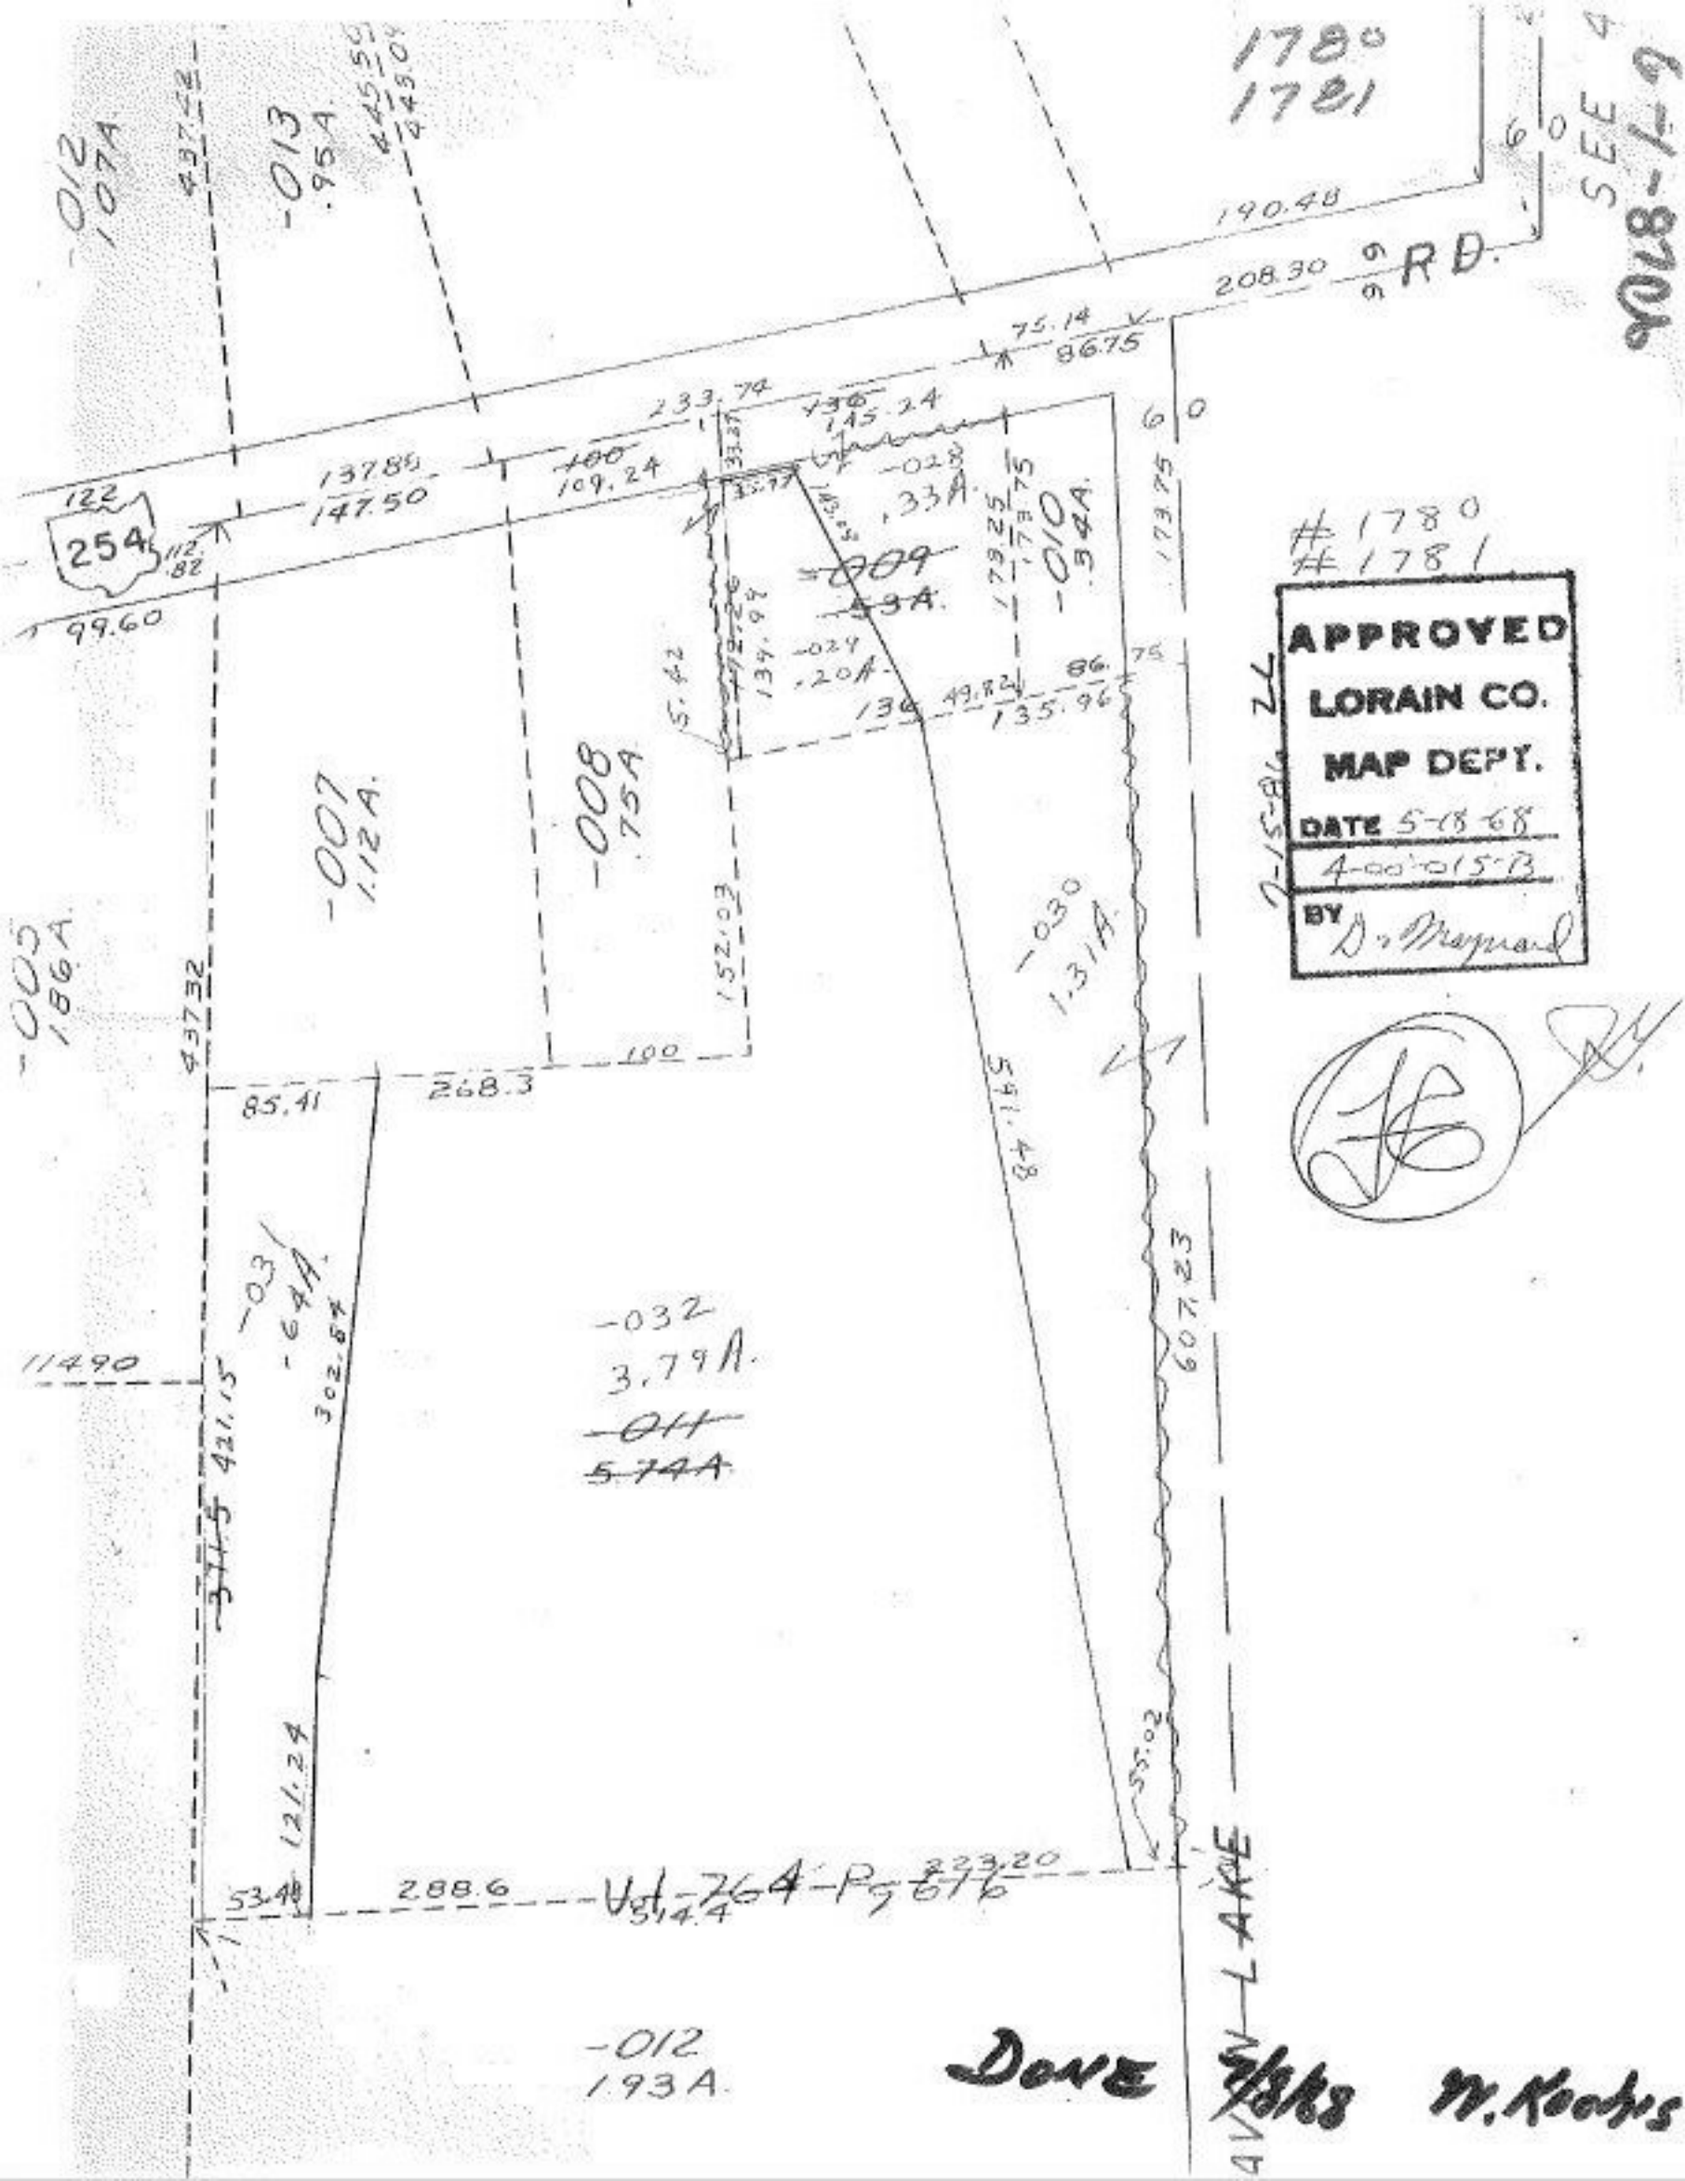
1780
1781
SEE 4
-012
1.07A
-013
.95A
190.48
208.30
RD.
75.14
86.75
233.74
145.24
137.85
147.50
109.24
254
99.60
-028
.33A
-009
.53A
-010
.34A
-029
.20A
-007
1.12A
-008
.75A
-005
1.86A
-030
1.31A
152.03
268.3
85.41
100
591.48
607.23
-031
.64A
302.84
-032
3.79A
-011
5.74A
114.90
421.15
121.24
53.48
288.6
223.20
514.4
55.02
-012
1.93A
#1780
#1781
APPROVED
LORAIN CO.
MAP DEPT.
DATE 5-18-68
4-00-015-B
BY D. Maynard
DONE 5/8/68 W. Koodis