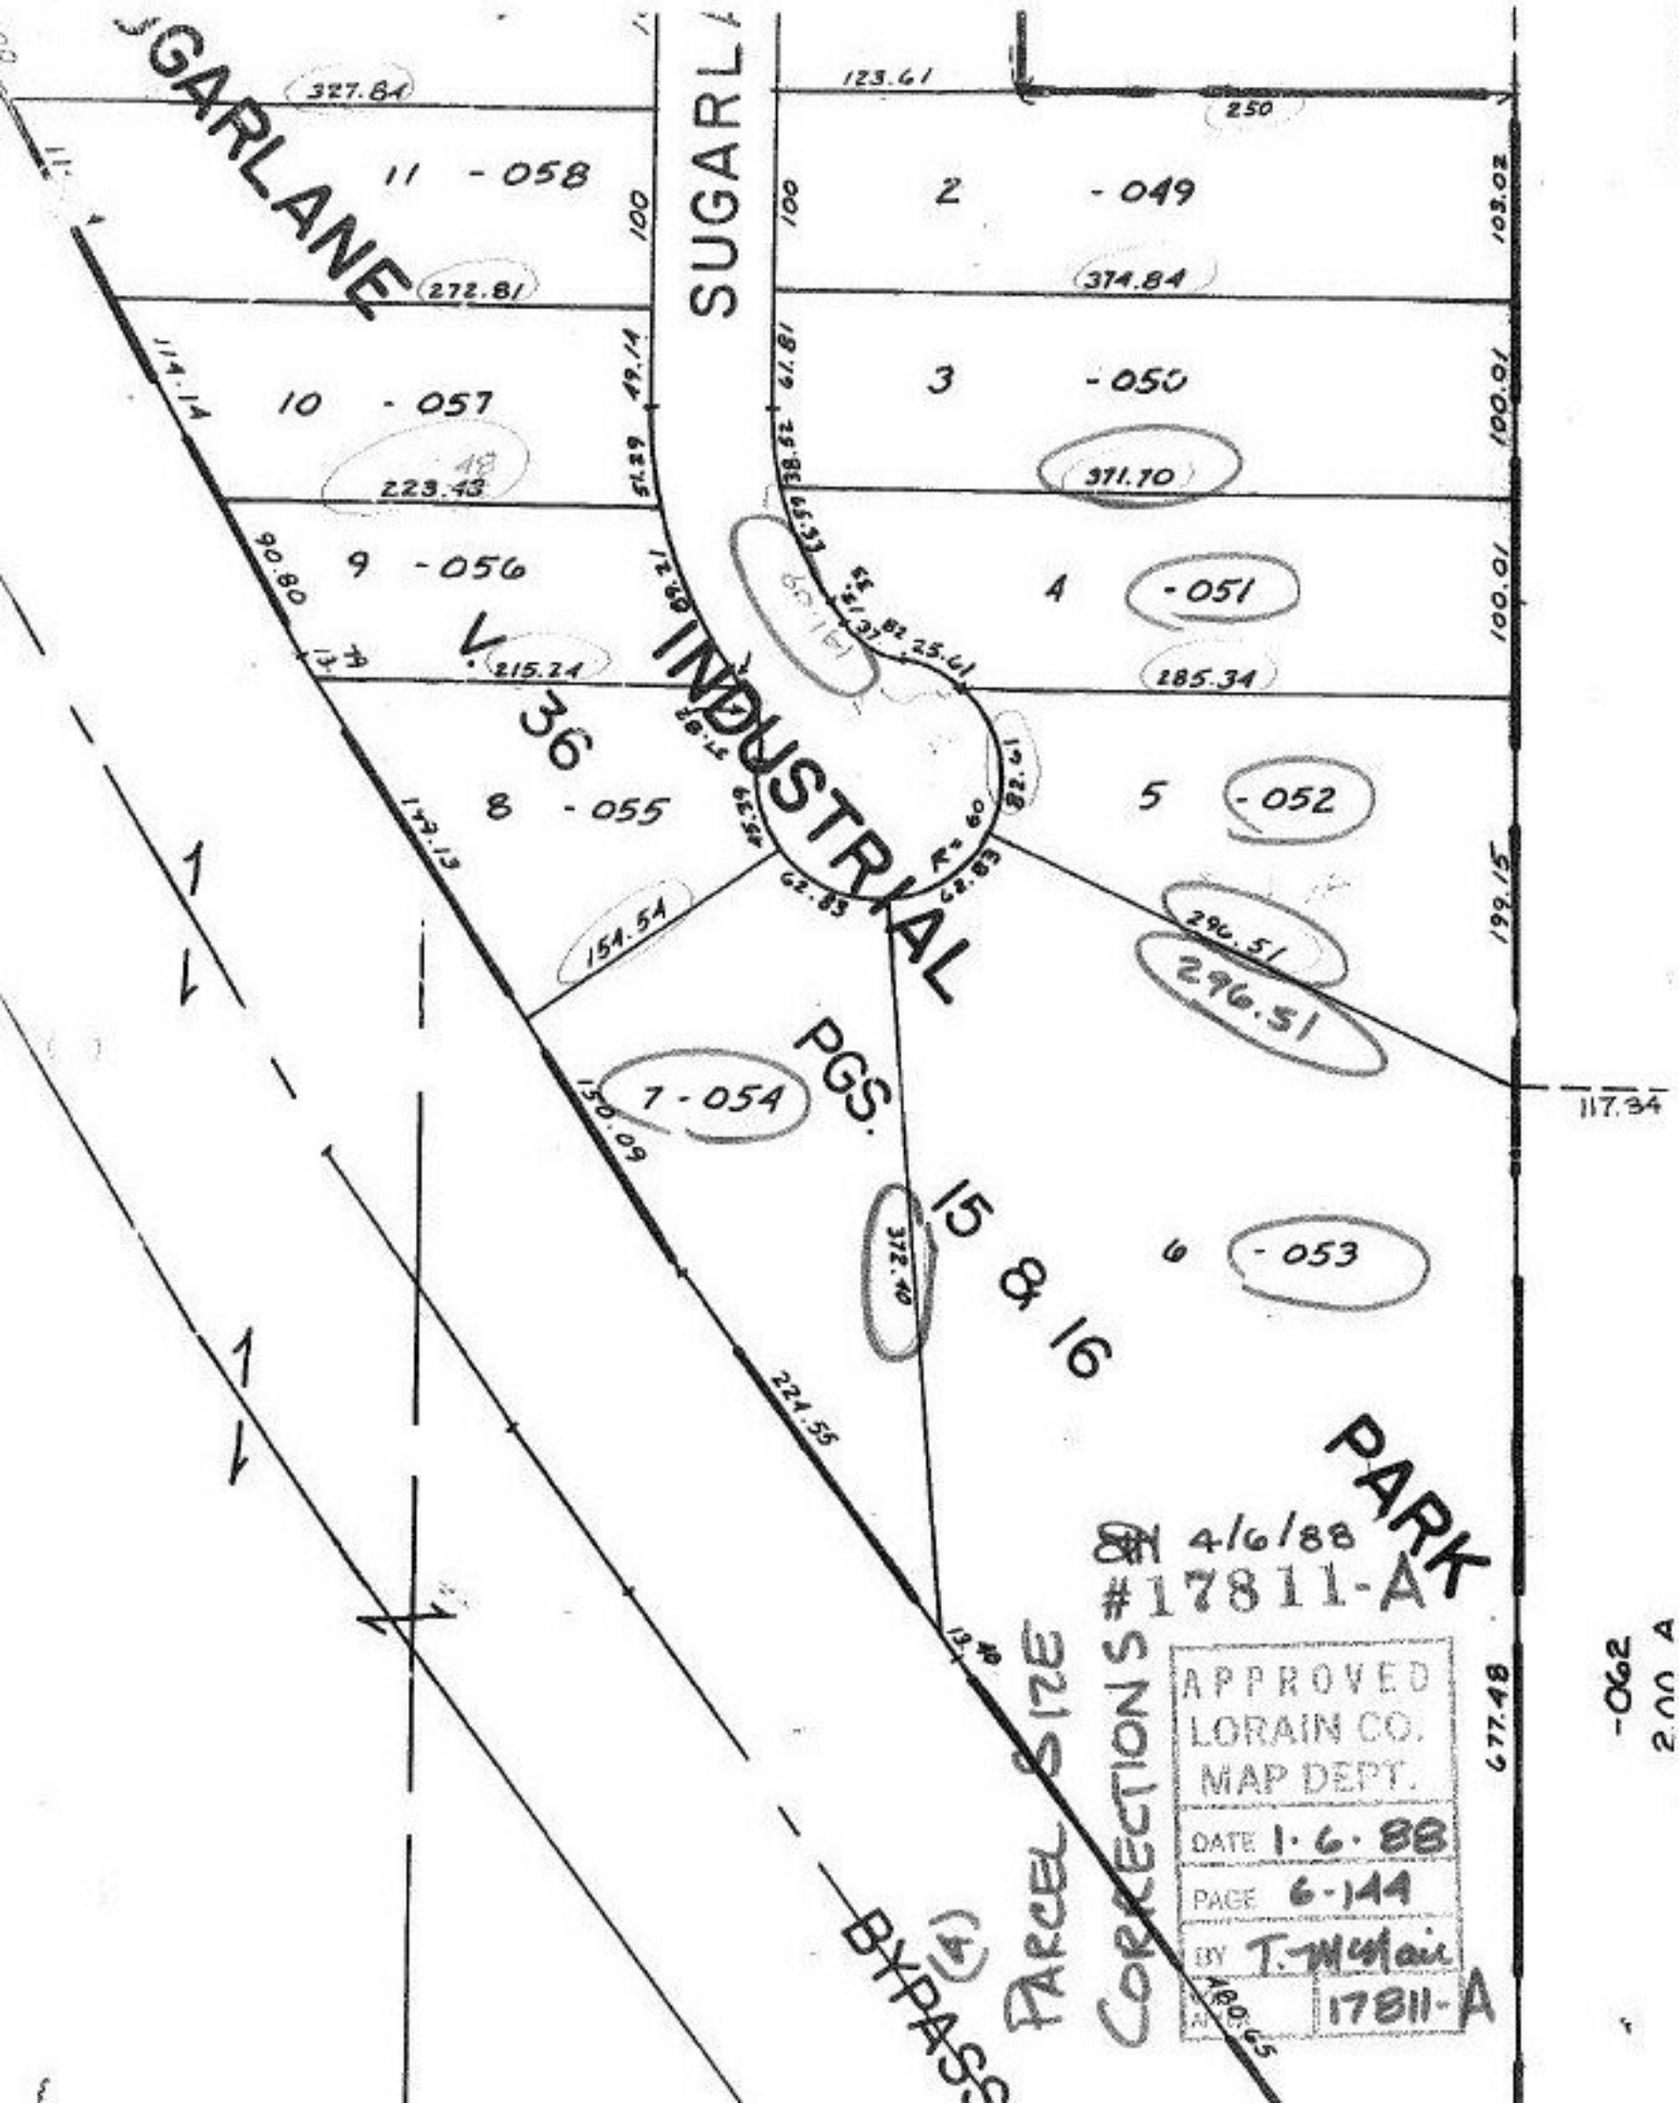

SUGARLANE
SUGARL
INDUSTRIAL
PARK
PGS. 15 & 16
V. 36
11 - 058
10 - 057
9 - 056
8 - 055
7 - 054
6 - 053
5 - 052
4 - 051
3 - 050
2 - 049
327.84
272.81
223.43
215.24
154.54
150.09
224.55
123.61
250
374.84
371.70
285.34
296.51
296.51
372.40
117.34
677.48
4/6/88
#17811-A
APPROVED
LORAIN CO.
MAP DEPT.
DATE 1·6·88
PAGE 6-144
BY T. McMair
17811-A
PARCEL SIZE CORRECTIONS
BYPASS (4)
-062